FHWA REG NO.	STATE	PROJECT NO.	YEAR	SHEET NO.	TOTAL SHEETS
7	KANSAS	STP-N012(901)	1999	41	131

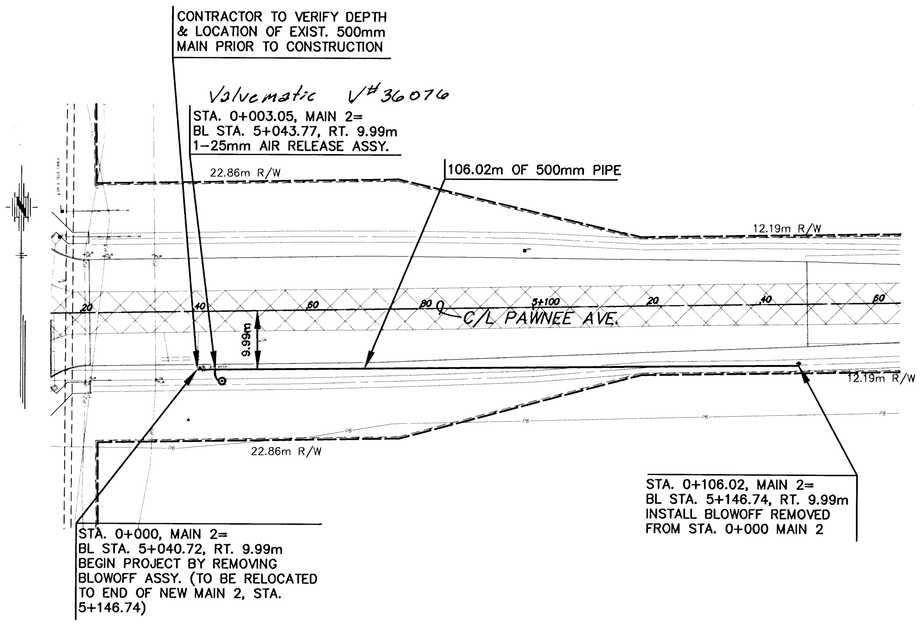

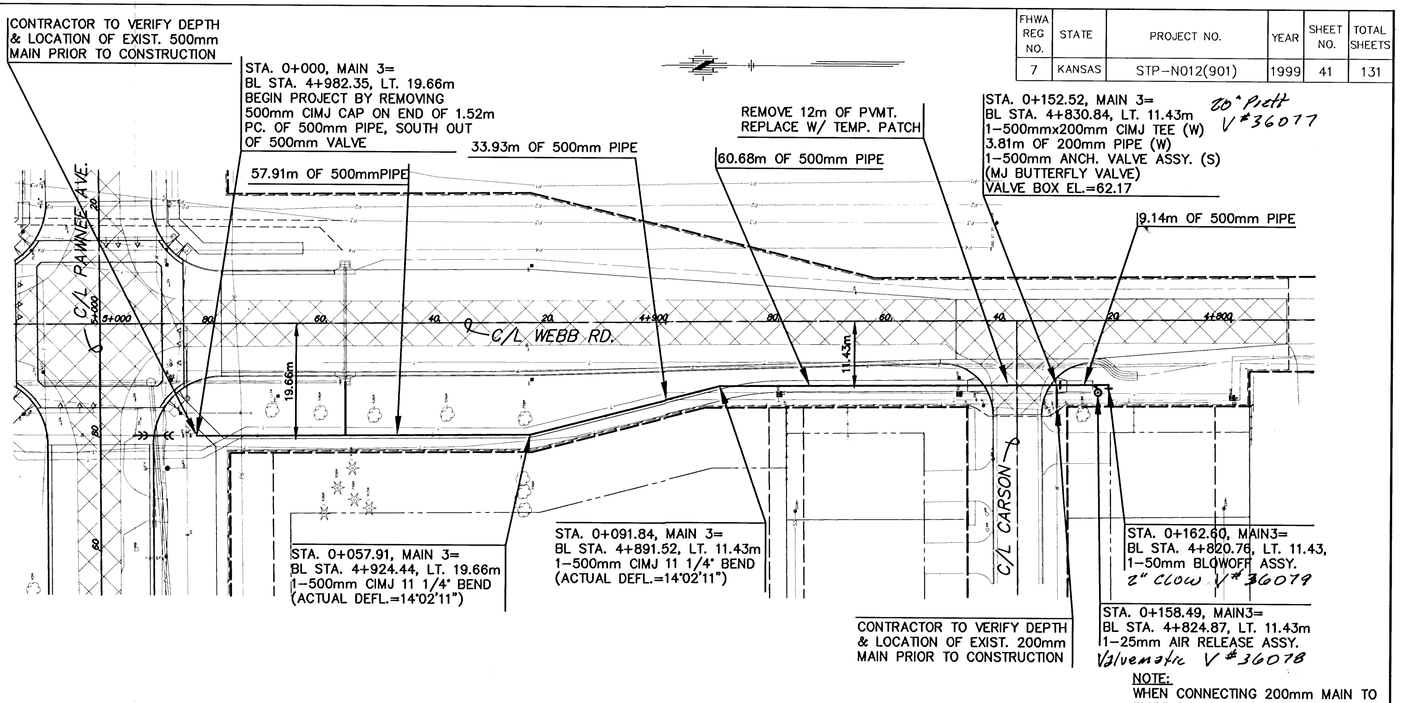

NOTE:
WHEN CONNECTING 200mm MAIN TO EXIST. HYDT. TEE, CLOSE 200mm VALVE WEST OF TEE, THEN THE F.H. CAN BE USED TO FLUSH OUT THE WEBB RD. 500mm MAIN

PLAN – MAIN 2
SCALE: 1 : 500

PROFILE – MAIN 2
HORIZONTAL SCALE: 1 : 500
VERTICAL SCALE: 1 : 50

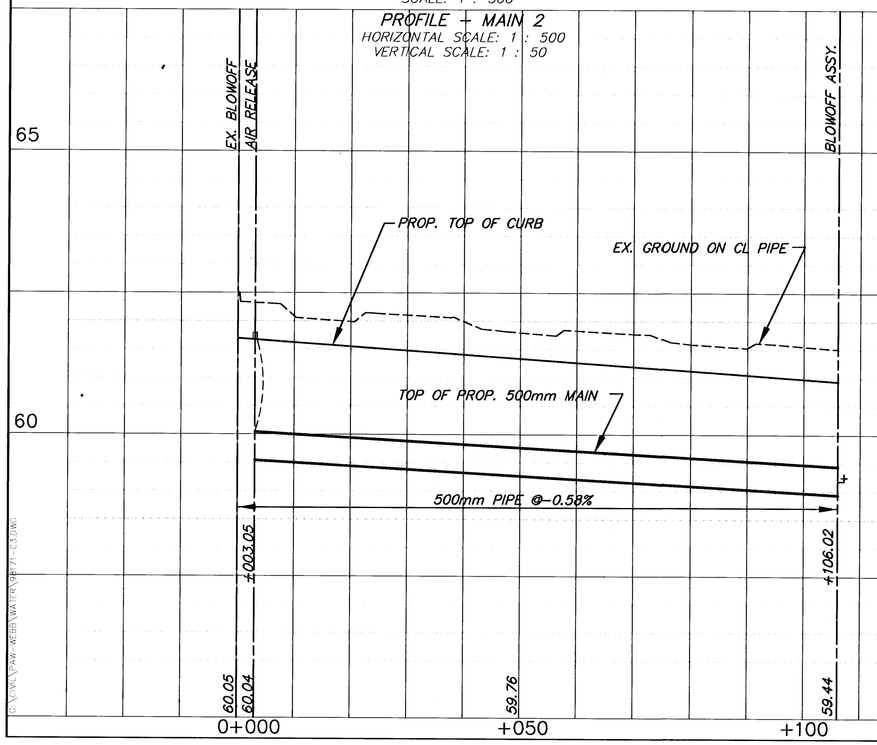

PLAN – MAIN 3
SCALE: 1 : 500

PROFILE – MAIN 3
HORIZONTAL SCALE: 1 : 500
VERTICAL SCALE: 1 : 50

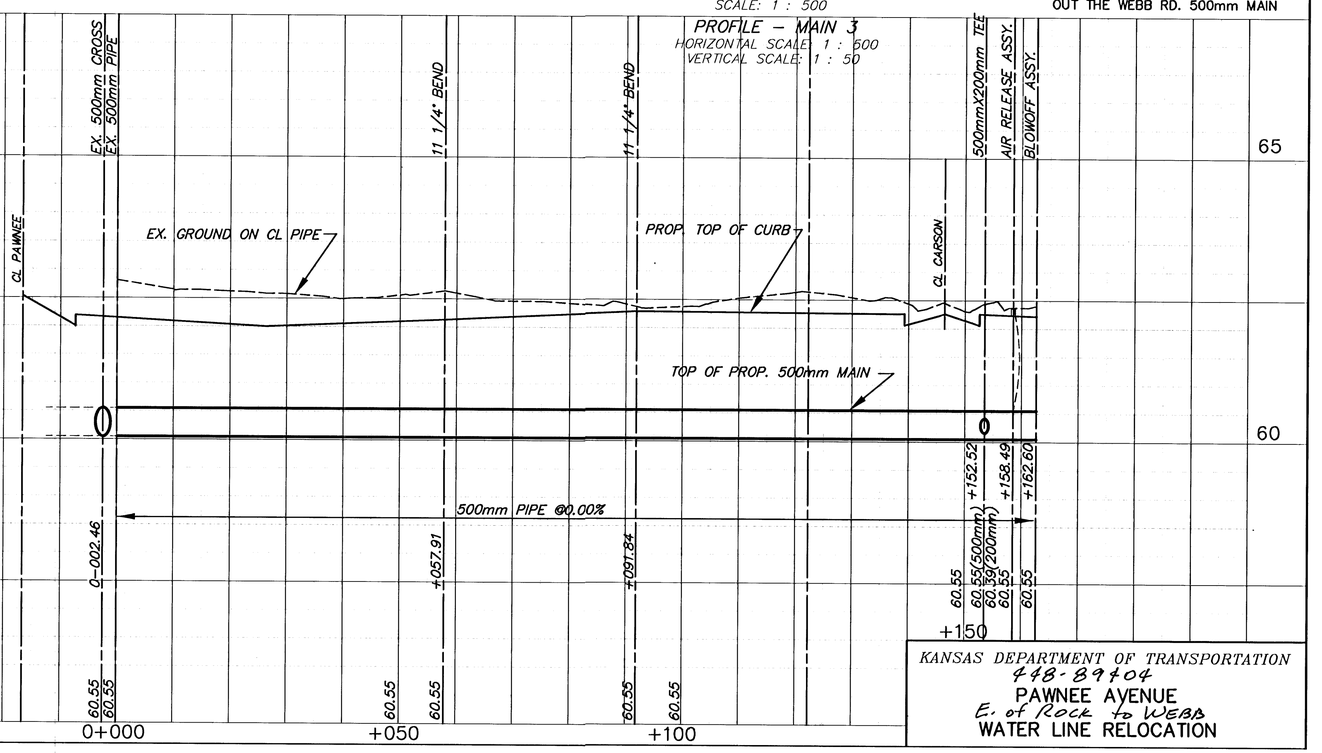

KANSAS DEPARTMENT OF TRANSPORTATION
748-89704
PAWNEE AVENUE
E. of Rock to WEBB
WATER LINE RELOCATION

G:\CIVIL\PAW-WEBB\WATER\98171-C3.DWG Thu Sep 14 10:00:37 2000