

FHWA REGION NO.	STATE	PROJECT NUMBER	FISCAL YEAR	SHEET NUMBER	TOTAL SHEETS
7	KANSAS	87N-0195-01	2001	73	127


BY	DATE
REFERENCES NOTED	
REFERENCES CHECKED	

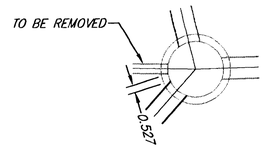

STA. 9+234.791, 5 976 LT.
EXISTING MANHOLE (TYPE P)
(1200mm D)

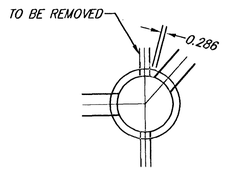


STA. 9+223.208, 6 468 RT.
PROPOSED MANHOLE (TYPE P)
(1200mm D)

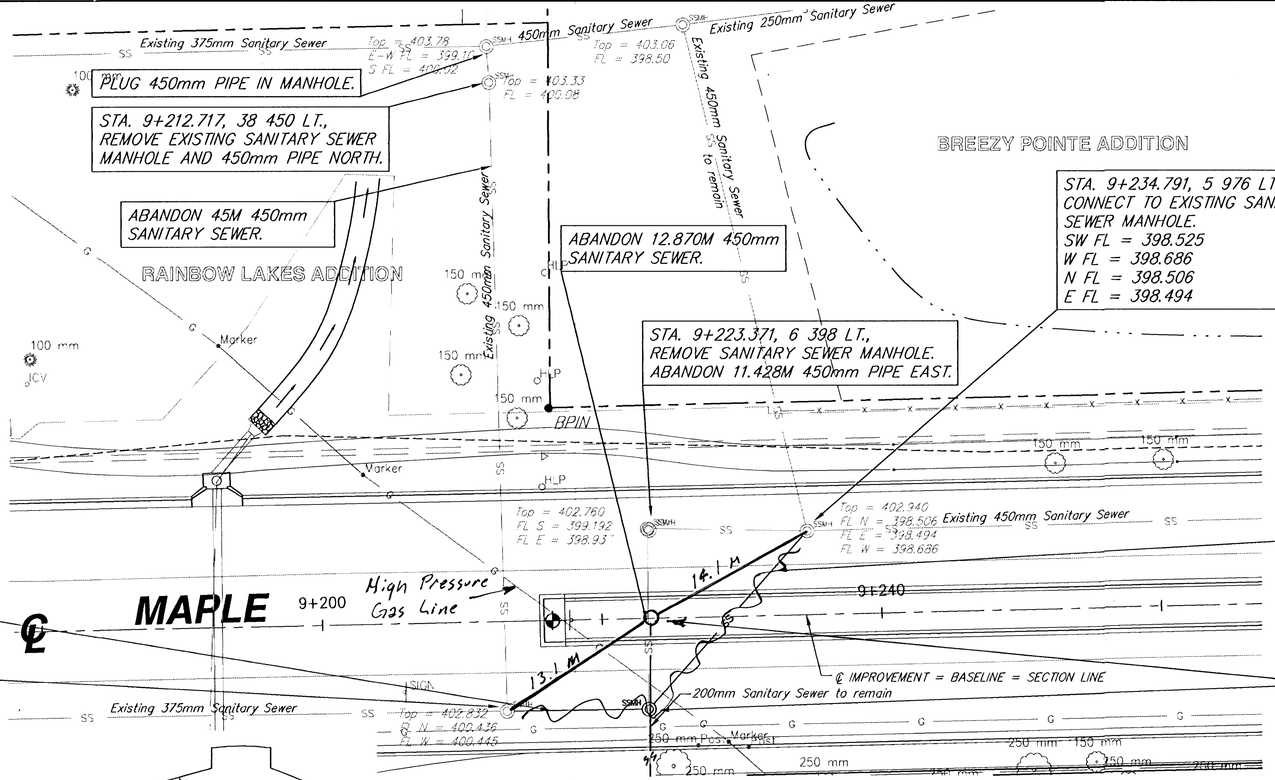

VERTICAL DATUM: USGS DATUM
DATUM BENCH MARK: CITY OF WICHITA MONUMENT DISK @ NW HUBGUARD OF MAPLE AND BREEZY POINTE CIRCLE
MSL ELEV. 403.162

AS BUILT
7/28/03
RDL
PDF

SCALE
5 0 5 10
PLAN: Lat. & Long. (meters)

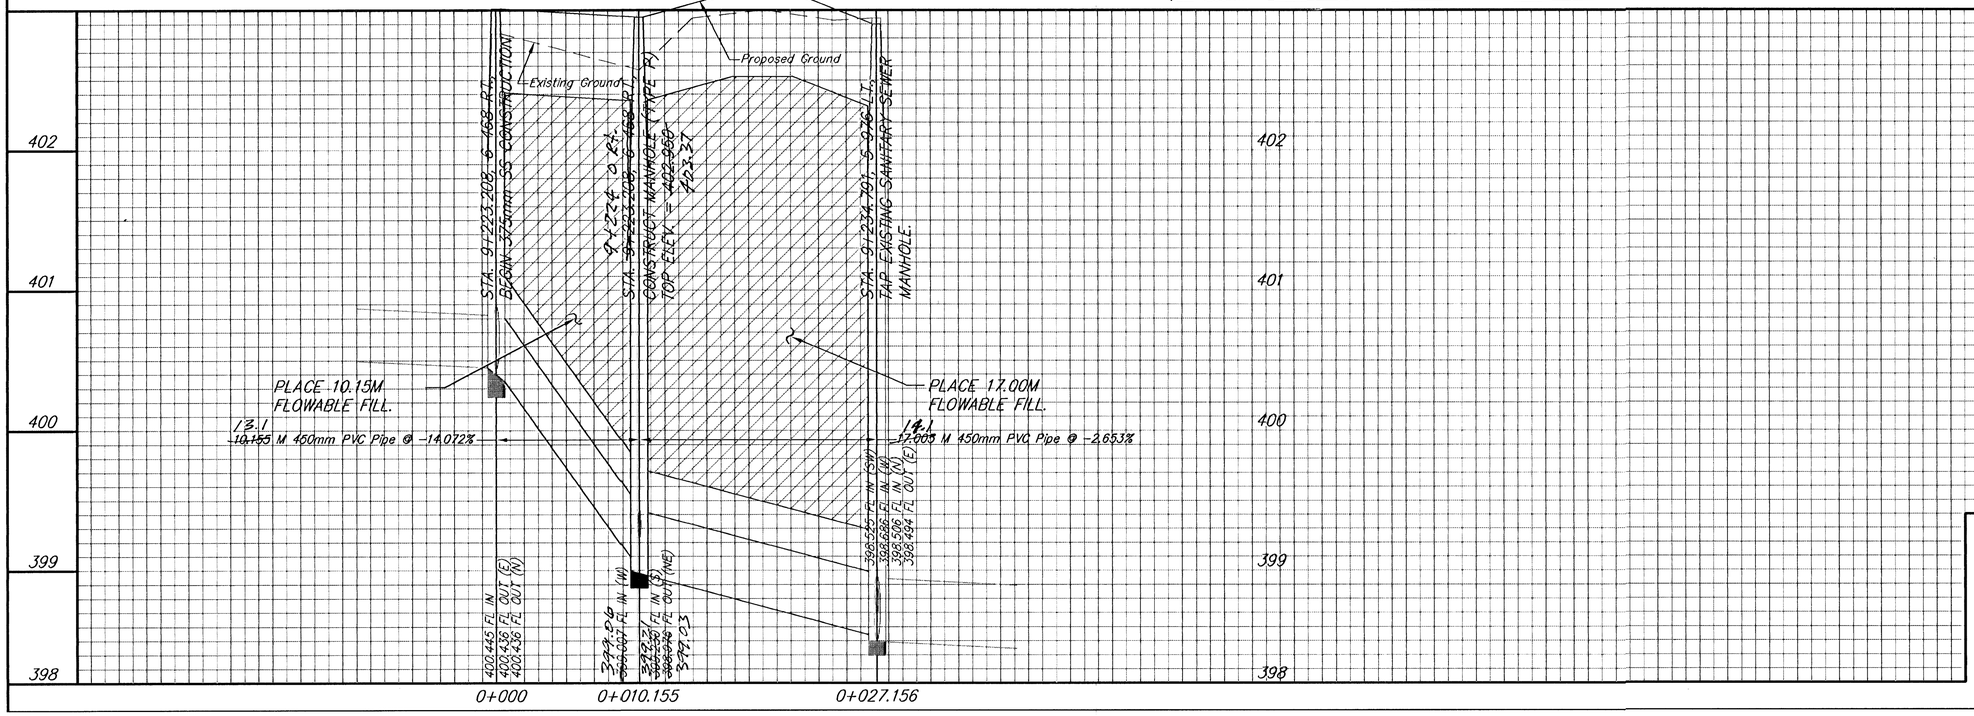

MAPLE IMPROVEMENTS - 135TH ST. W. TO 119TH ST. W.
SANITARY SEWER RELOCATION PLAN

SRB 924 NORTH MAIN WICHITA, KANSAS 67203 316-264-6006 FAX 264-6821 www.srbt.com E-Mail: srb@srbt.com
SAVOY, RUGGLES & BOHM, P.A. ENGINEERING & SURVEYING

PROJECT NUMBER 472-76-245-83262-000-000-001

DRAWN	DESIGN	REVIEW	DATE	UTILITY	SRB JOB
JRA	JDS		Sept. 28, 2001		1217T

REVISED

Dgn: TLC Sanitary_sewer 73 127