


IRONS

Point Table			
Point #	Northing	Easting	Raw Description
100	6460.47	8741.48	iron
101	6524.47	8741.00	iron
102	6525.01	8813.00	iron
103	6461.01	8813.48	iron
104	6593.52	8880.48	iron
105	6594.00	8944.48	iron
106	6436.03	8894.36	iron
107	6470.91	8940.69	iron
108	6422.68	9037.37	iron
109	6364.68	9037.37	iron
110	6364.68	9063.48	iron
111	6422.68	9063.48	iron
112	6472.68	8866.76	iron
113	6507.57	8913.10	iron
114	6514.46	9180.89	iron
115	6500.45	9237.18	iron
116	6689.47	9284.22	iron
117	6703.48	9227.94	iron
118	6412.50	8915.58	iron
119	6374.19	8965.76	iron
120	6394.42	8903.59	iron
121	6362.37	8951.93	iron
122	6333.80	8943.43	iron
123	6333.37	8885.43	iron
124	6277.36	8885.85	iron
125	6277.79	8943.85	iron

WATER

Point Table			
Point #	Northing	Easting	Raw Description
6000	6466.66	8766.43	0+00
6001	6467.77	8780.73	0+14.34
6002	6468.01	8813.42	0+47.03
6003	6482.77	8871.41	1+07.46
6004	6593.94	8937.48	2+43.38
6005	6634.21	8937.18	2+83.65
6006	6654.21	8937.03	3+03.65
6007	6459.92	8883.88	0+26.03
6008	6439.64	8899.15	0+51.41
6009	6419.65	8916.76	0+78.08
6010	6388.21	8961.48	1+32.98
6011	6370.68	9037.37	2+11.53
6012	6370.68	9063.48	2+37.64
6013	6501.90	9231.36	4+67.19
6014	6608.58	9257.91	5+77.12
6015	6698.25	9280.22	6+69.53
6016	6710.44	9300.49	6+93.18
6017	6752.17	9310.88	7+36.18
6018	6361.81	8944.13	0+31.6
6019	6345.09	8937.35	0+49.64
6020	6269.41	8937.92	1+25.32
6021	6259.95	8951.42	1+41.81
6022	6227.54	8957.14	1+74.73
6023	6197.10	8935.83	2+11.88
6024	6192.43	8909.33	2+38.79
6025	6213.74	8878.89	2+75.94
6026	6226.35	8876.67	2+88.75

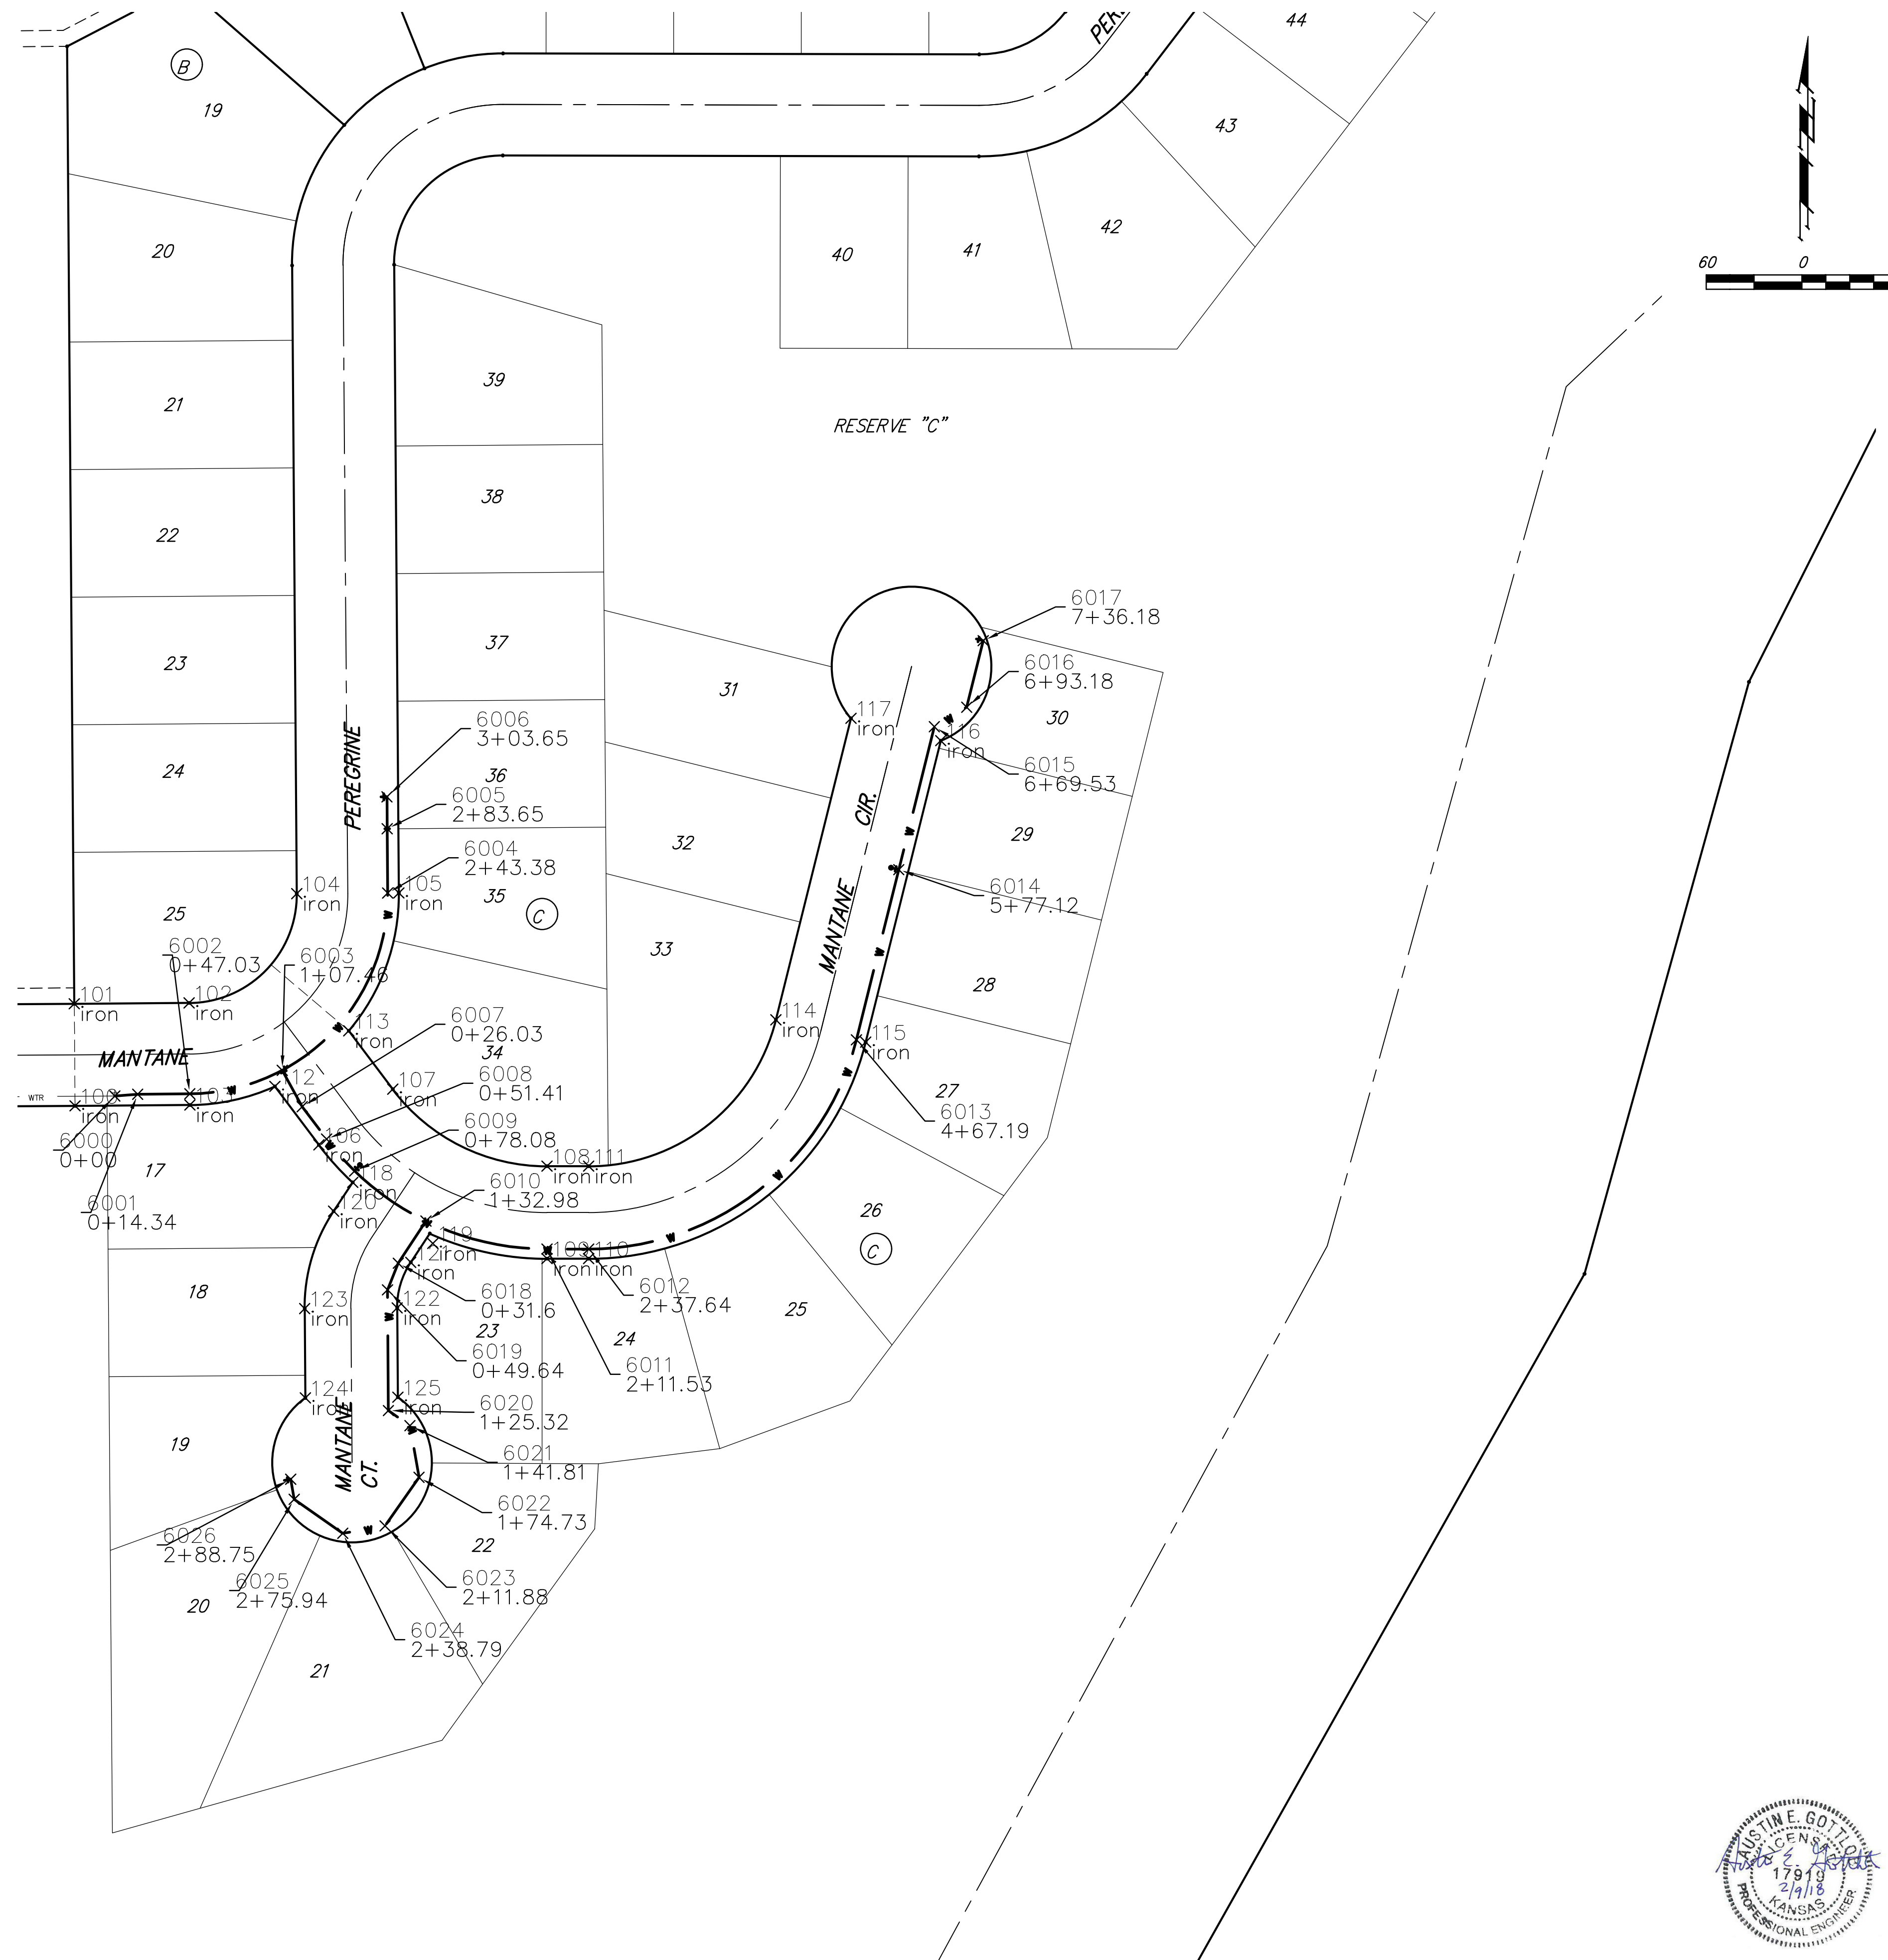

Baughman Company, P.A.
 ENGINEERING, ARCHITECTURE, PLANNING, LANDSCAPE ARCHITECTURE
 17918
 2/1/18
 KANSAS
 PROFESSIONAL ENGINEER

FALCON FALLS 3RD ADD. PH. 3A
COORDINATE SHEET
 WATER DISTRIBUTION SYSTEM

