


FHWA REG NO.	STATE	PROJECT NO.	YEAR	SHEET NO.	TOTAL SHEETS
7	KANSAS	87 N-0287-01	2003	106	107
		16	18	20	

FINAL SURVEY	BY	DATE
PLOTTED AREAS		
CHECKED AREAS		

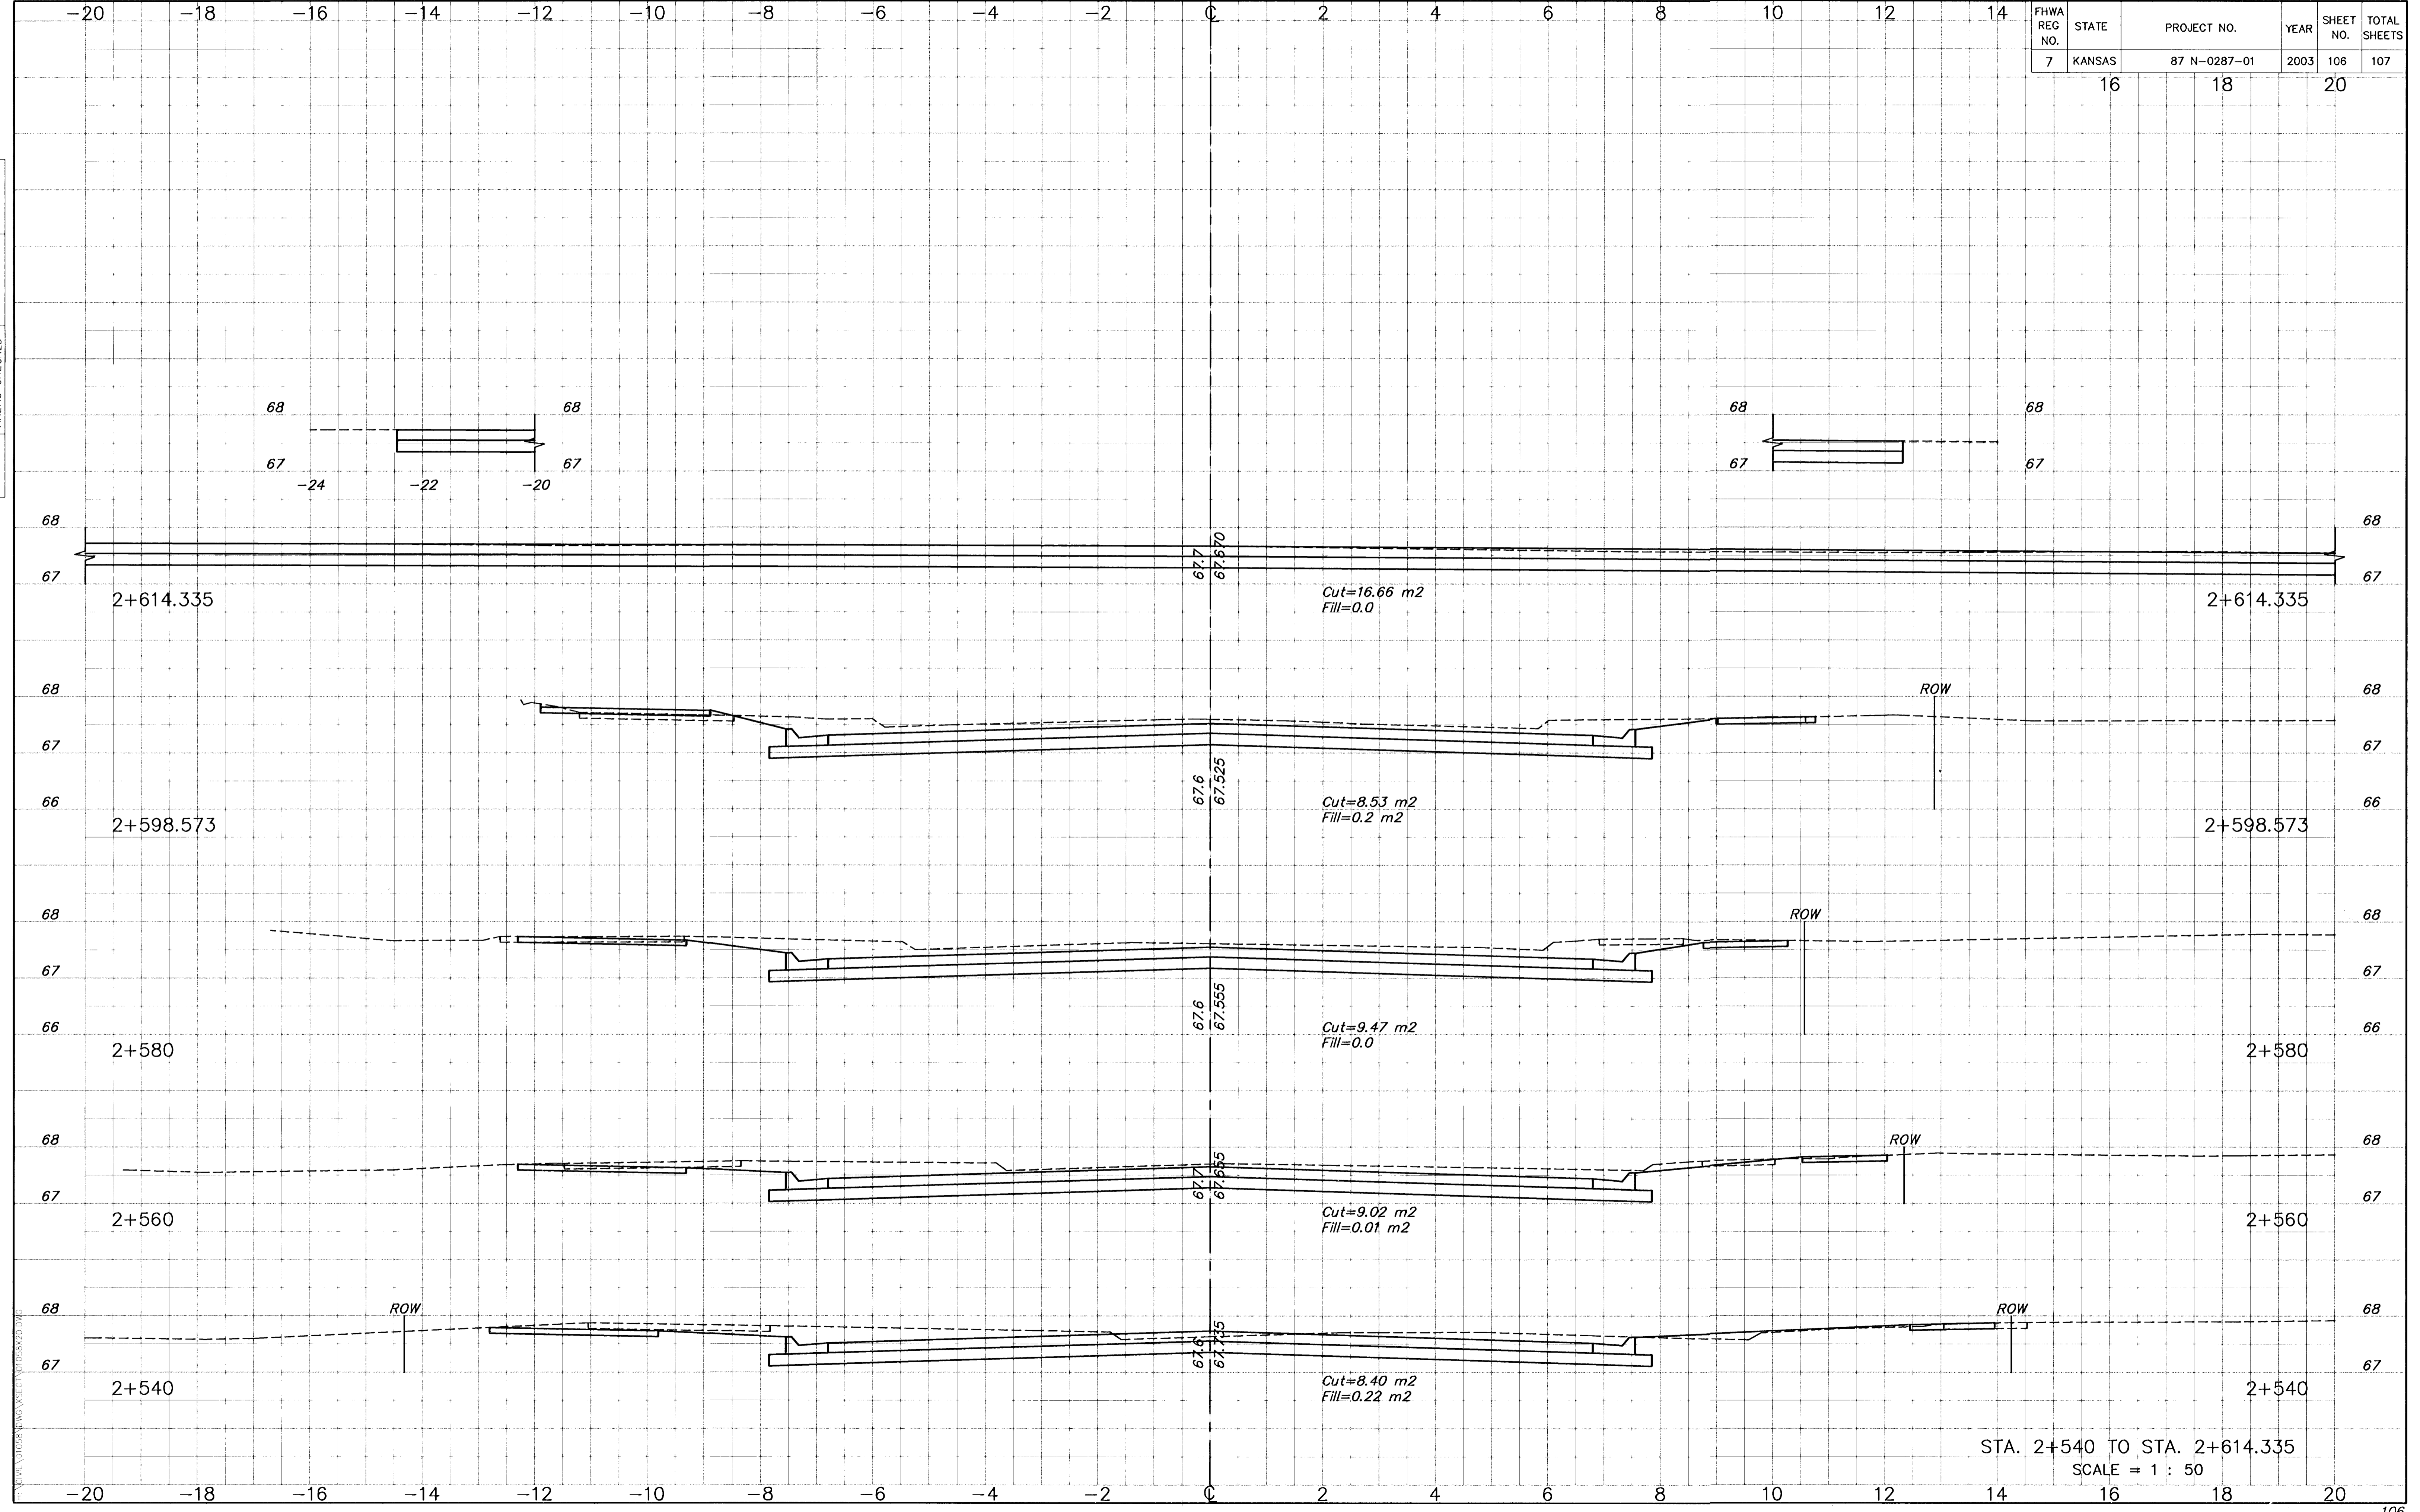

STA. 2+540 TO STA. 2+614.335
SCALE = 1 : 50