






© 2018 GARVER, LLC
 THIS DOCUMENT, ALONG WITH THE IDEAS AND DESIGNS CONVEYED HEREIN, SHALL BE CONSIDERED INSTRUMENTS OF PROFESSIONAL SERVICE AND ARE PROPERTY OF GARVER, LLC. ANY USE, REPRODUCTION, OR DISTRIBUTION OF THIS DOCUMENT, ALONG WITH THE IDEAS AND DESIGN CONTAINED HEREIN, IS PROHIBITED UNLESS AUTHORIZED IN WRITING BY GARVER, LLC OR EXPLICITLY ALLOWED IN THE GOVERNING PROFESSIONAL SERVICES AGREEMENT FOR THIS WORK.

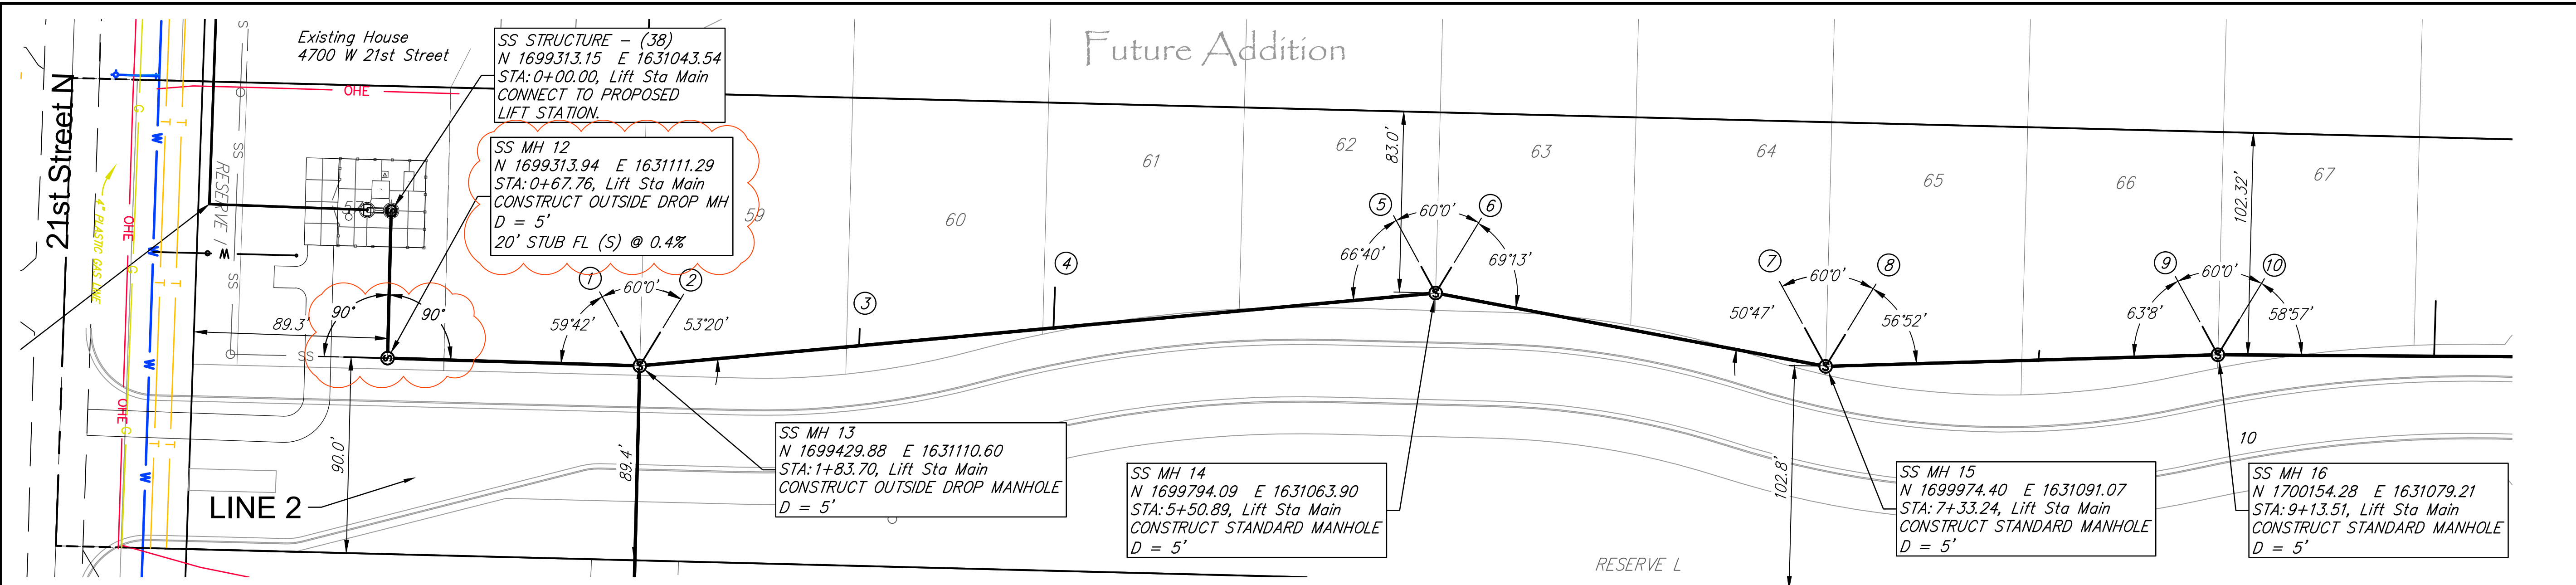

NUMBER	TYPE	SERVING			STATION/DIRECTION	FOR INFORMATION ONLY	
		LOT NO.	BLOCK NO.	LINE NO.		APPROX. LENGTH 4" PIPE	
						VERTICAL	HORIZONTAL
1	MH Connection	58	2	LiftSta	1+84 Left	20'	18'
2	MH Connection	59	2	LiftSta	1+84 Left	20'	18'
3	8"X4" Tee	60	2	LiftSta	2+87 Left	18'	10'
4	8"X4" Tee	61	2	LiftSta	3+76 Left	18'	20'
5	MH Connection	62	2	LiftSta	5+50 Left	15'	15'

NUMBER	TYPE	SERVING			STATION/DIRECTION	FOR INFORMATION ONLY	
		LOT NO.	BLOCK NO.	LINE NO.		APPROX. LENGTH 4" PIPE	
						VERTICAL	HORIZONTAL
6	MH Connection	63	2	LiftSta	5+50 Left	15'	15'
7	MH Connection	64	2	LiftSta	7+33 Left	14'	20'
8	MH Connection	65	2	LiftSta	7+33 Left	15'	20'
9	MH Connection	66	2	LiftSta	9+14 Left	15'	15'
10	MH Connection	67	2	LiftSta	9+14 Left	15'	20'

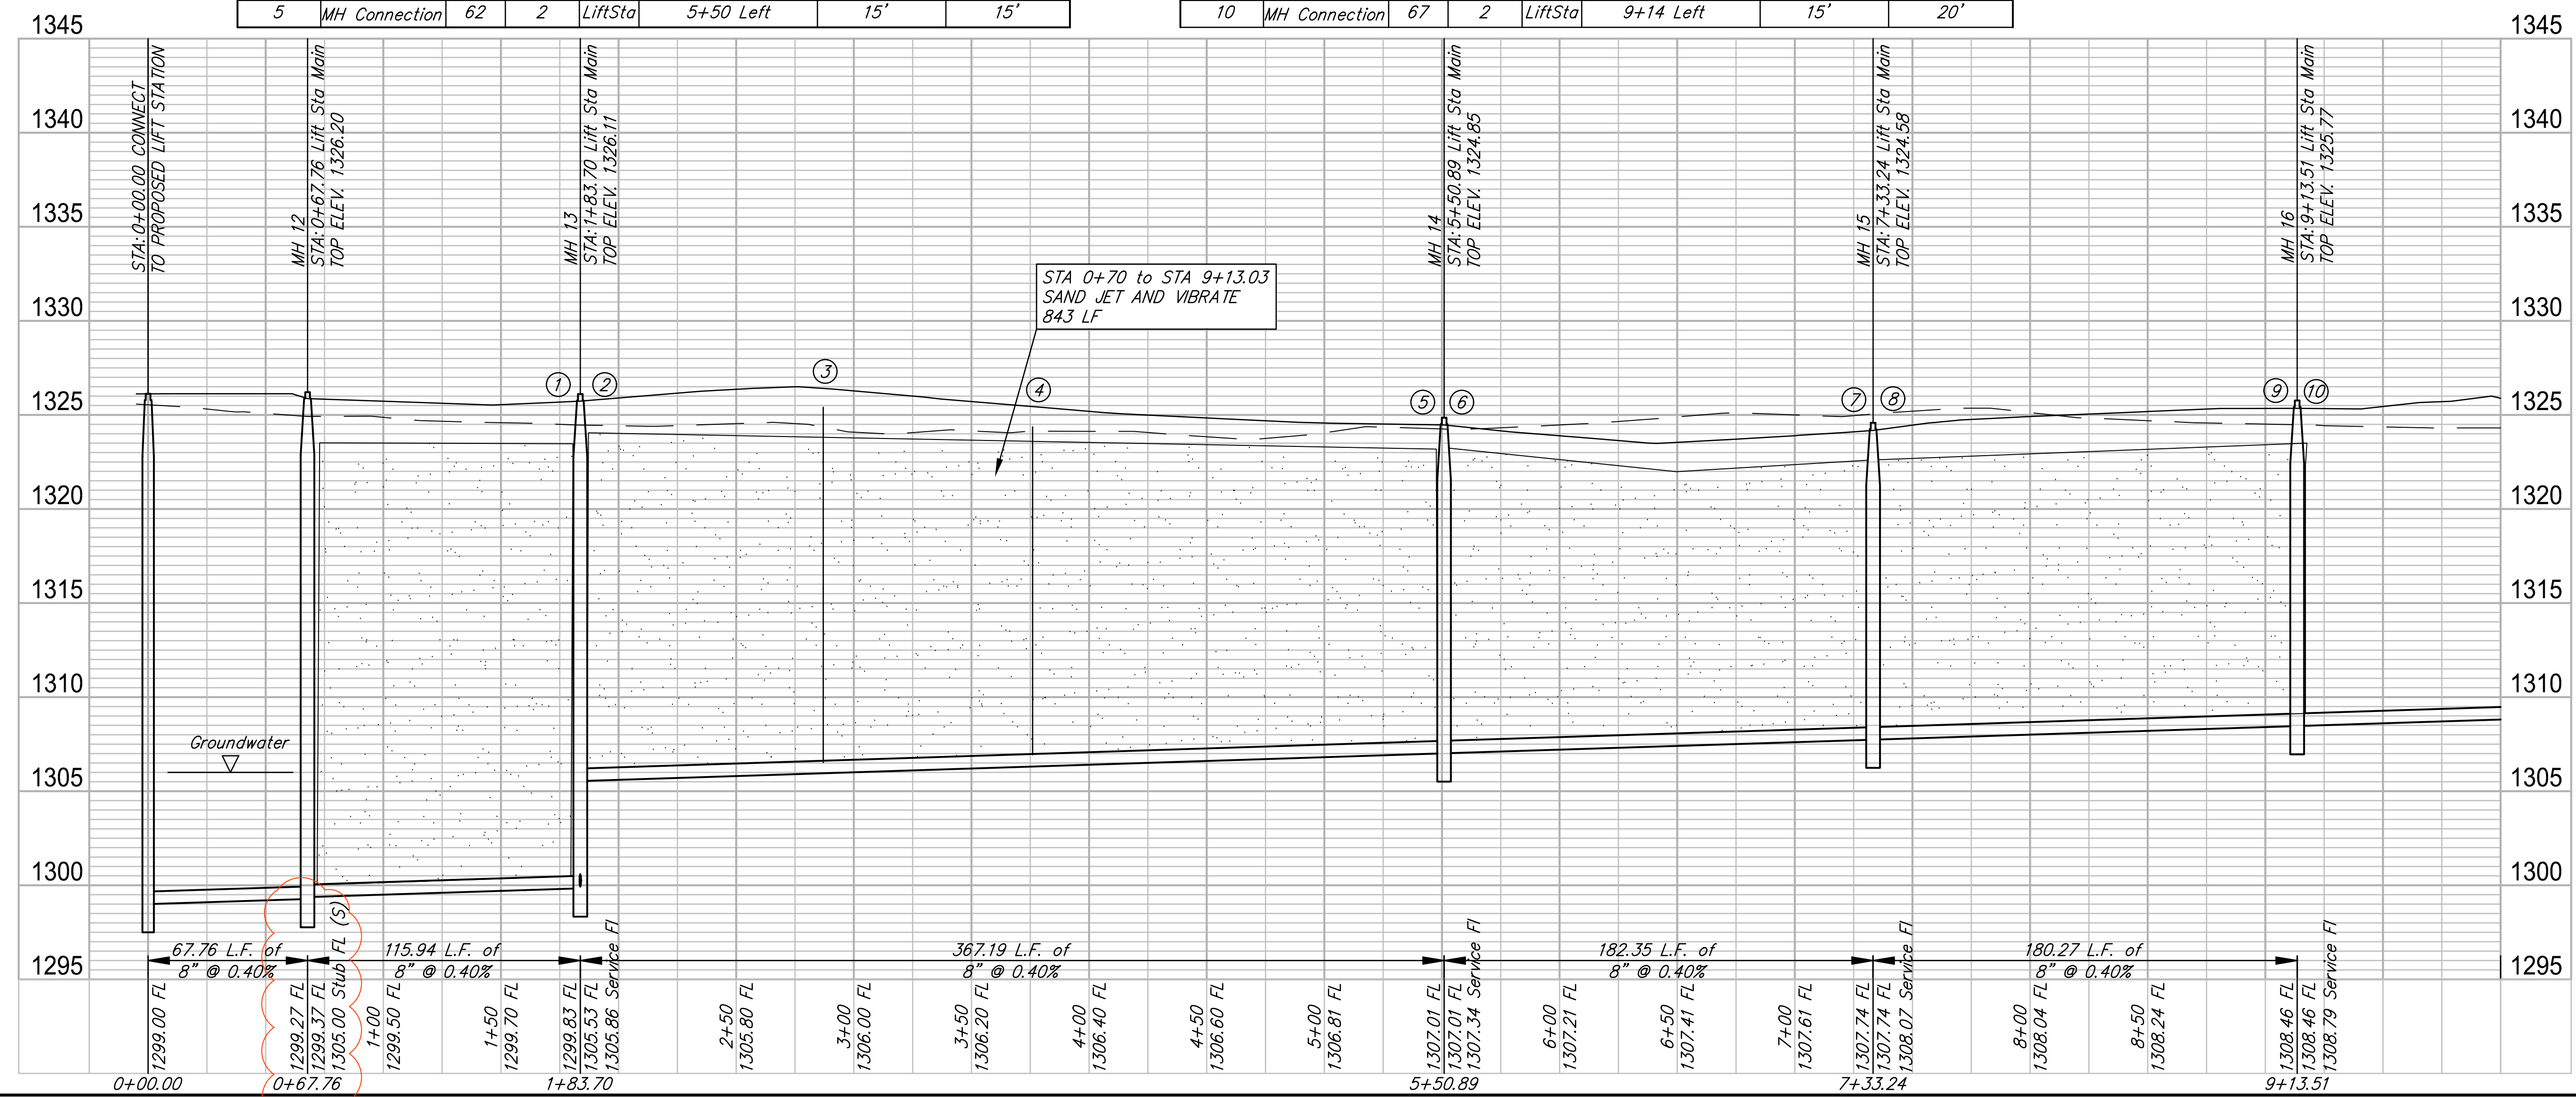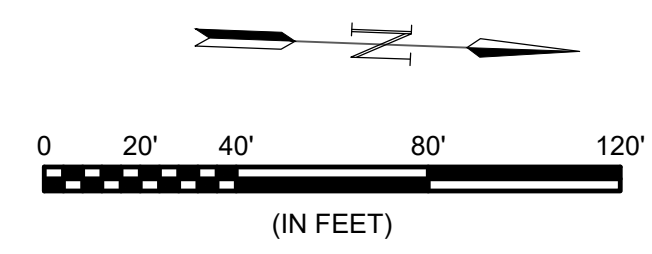

File: L:\2017\17264883 - Emerald Bay 3rd Improvements\Drawings\C3D\Sanitary Sewer Lift Station\Lift Station Main 01.dwg Last Save: 3/22/2018 8:57 AM Last saved by: E.J.Glover
 Last plotted by: Glover, Eric J. Plot Style: --- Plot Scale: 1:2.5849 Plot Date: 3/22/2018 9:30 AM Printer used: None

REV.	DATE	DESCRIPTION	BY



City of Wichita, KS
 Project #: 468-85239
 OCA: 744452
 Emerald Bay 3rd
 Sanitary Sewer Plans

LIFT STATION
 SANITARY SEWER
 MAIN

JOB NO.: 17264861
 DATE: .
 DESIGNED BY: EJG
 DRAWN BY: EJG

BAR IS ONE INCH ON ORIGINAL DRAWING
 IF NOT ONE INCH ON THIS SHEET, ADJUST SCALES ACCORDINGLY.

DRAWING NUMBER

SHEET NUMBER **02** OF **28**