| FHWA REGION NO. | STATE | PROJECT NO. | YEAR | SHEET NO. | TOTAL SHEETS |
|---|---|---|---|---|---|
| 7 | KS. | 87-U-1362-01 | 1993 | 4 | 149 |

Revised: See B.of.P. of Sheet.

* 51,820 Cu. Yds. Common Excavation (V.M.F.=0.8)
\+ 1,200 Cu. Yds. Rock Excavation
** 5,250 Cu. Yds. Embankment

* Incl. 39,600 Cu. Yds. of Common Excavation From Webb Road
8,020 Cu. Yds of Common Excavation From 21st. Street
4,200 Cu. Yds. of Common Excavation From Drainage Ditch, Rt. Sta. 41+50
45,258 Cu. Yds. of Common Excavation Wasted on Sites Provided by the Contractor (see General Notes) See Sheet No. 3

\+ Incl. 1,200 Cu. Yds. Rock Excavation to be Wasted on Sites Provided by the Contractor (see General Notes) See Sheet No. 3

** Incl. 1,800 Cu.Yds. of Embankment on Webb Road
1,250 Cu. Yds. of Embankment on 21st. Street

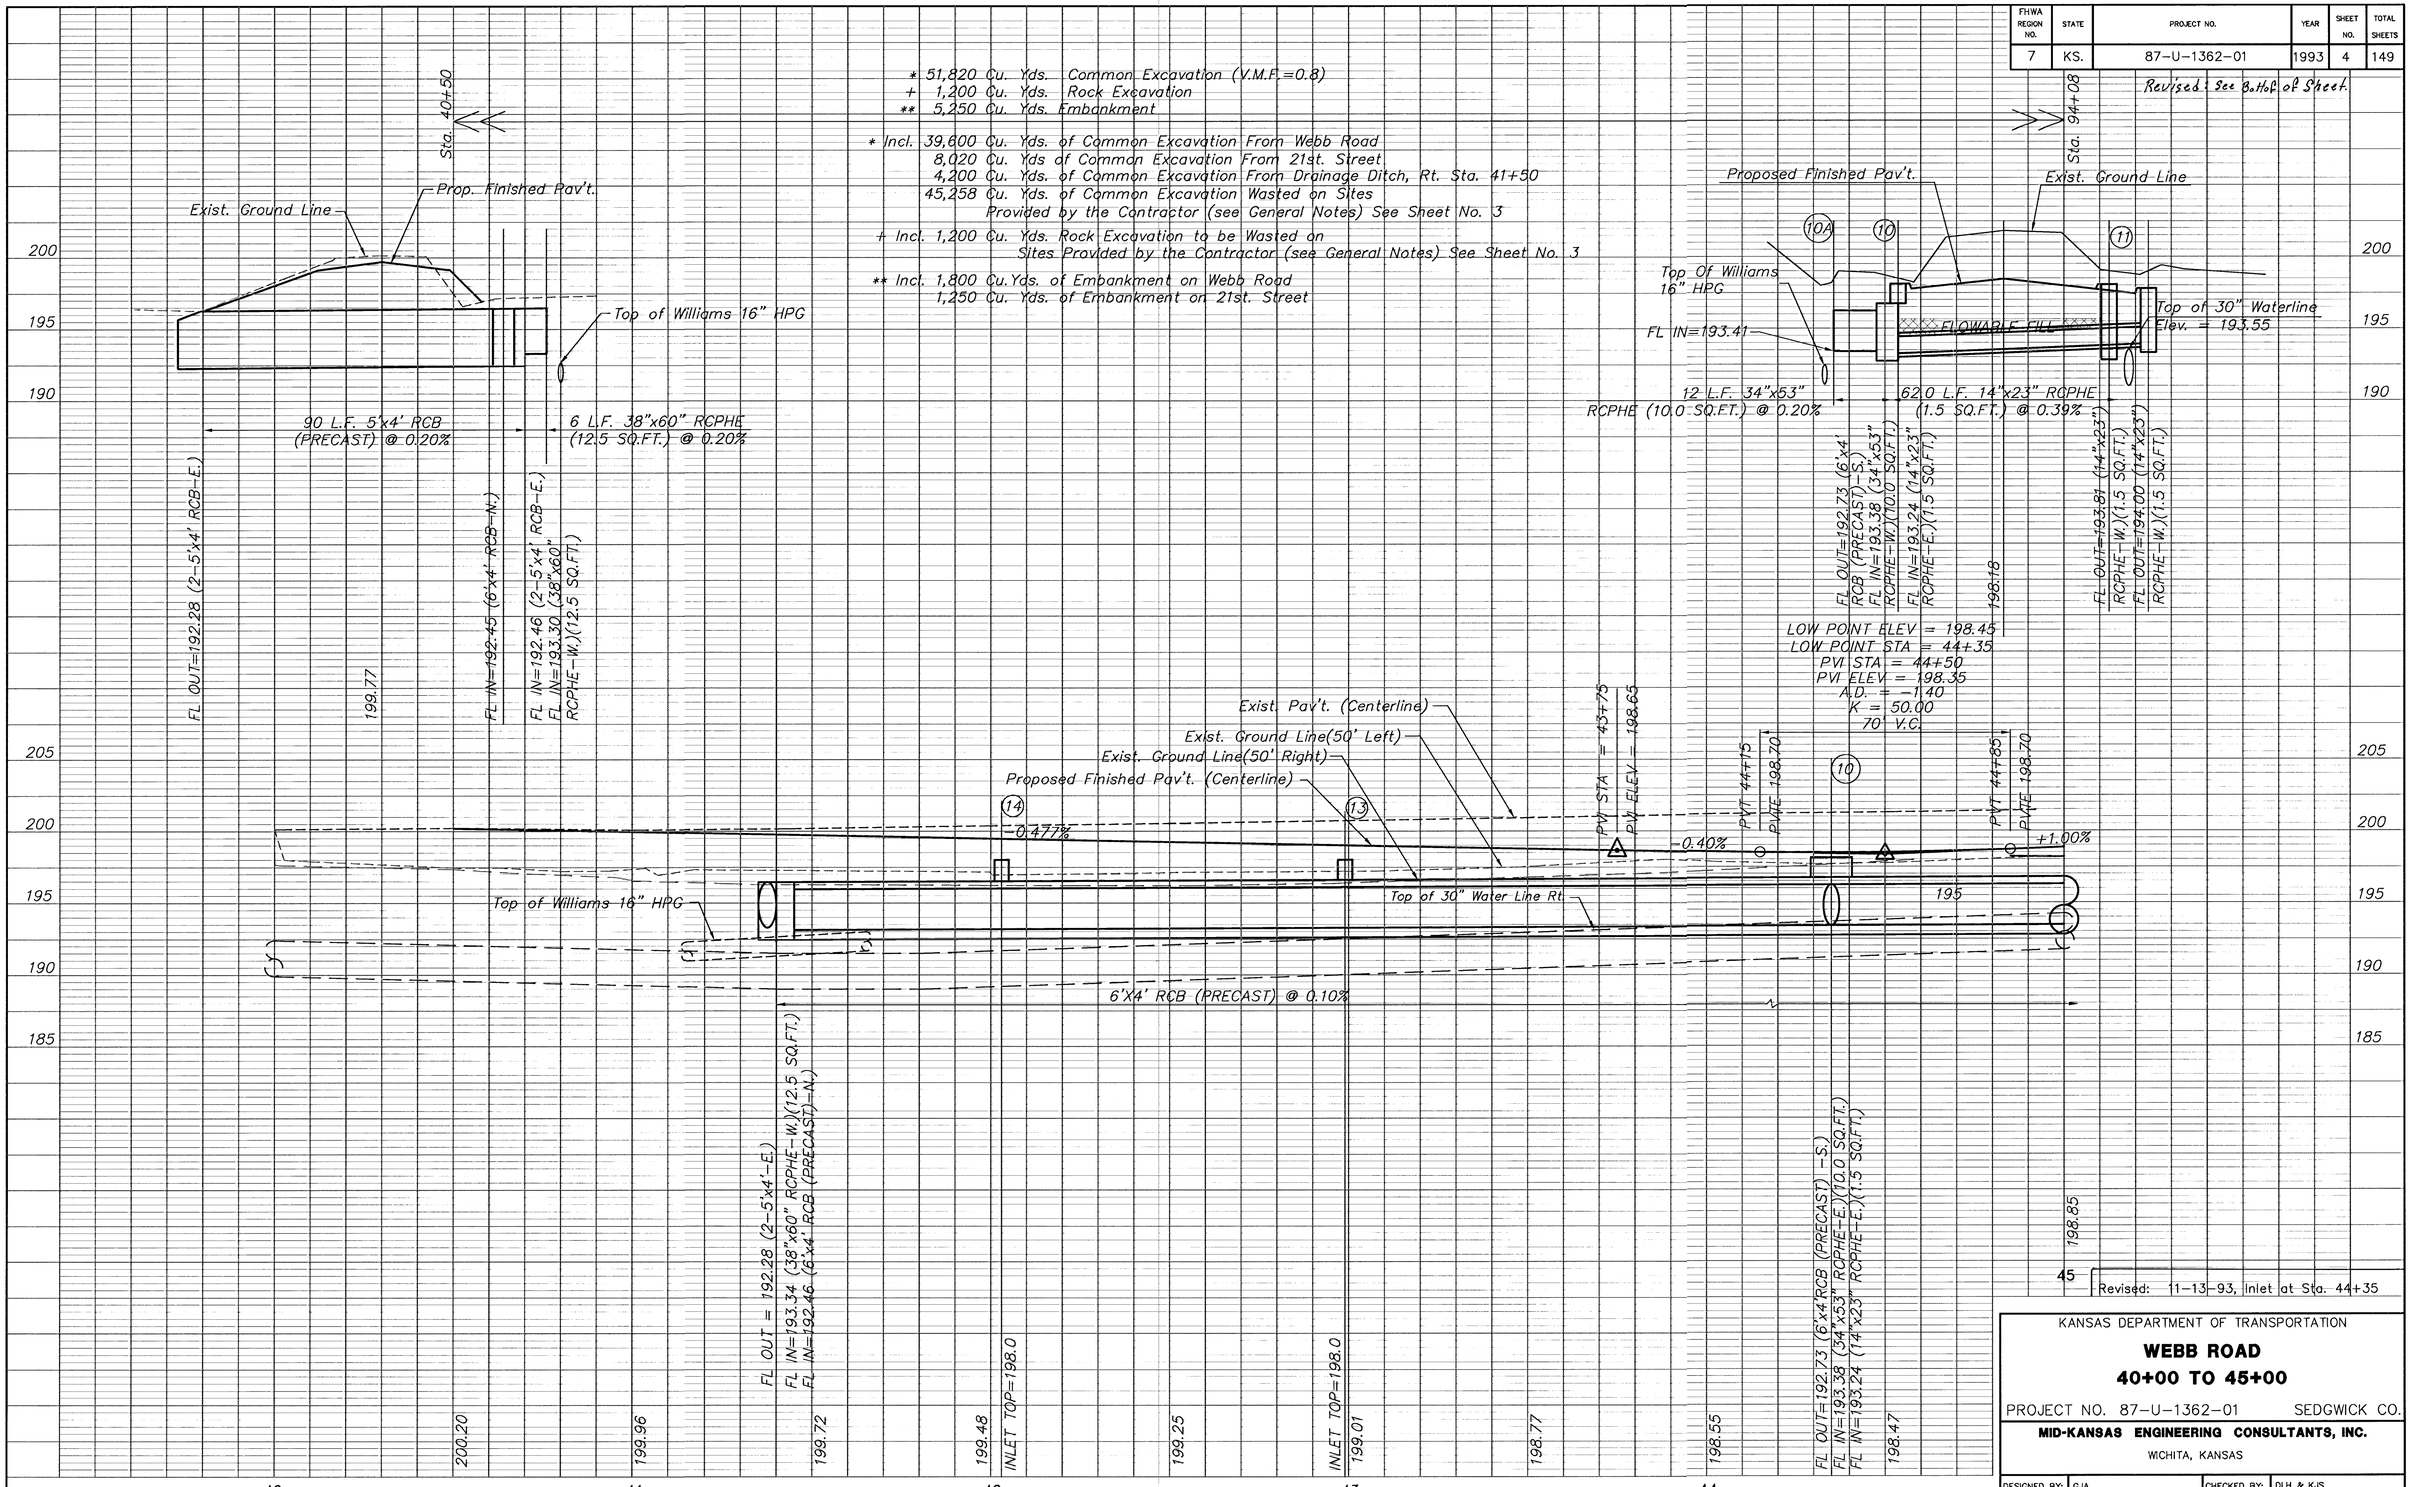


Revised: 11-13-93, Inlet at Sta. 44+35

KANSAS DEPARTMENT OF TRANSPORTATION

**WEBB ROAD**

**40+00 TO 45+00**

PROJECT NO. 87-U-1362-01 SEDGWICK CO.

**MID-KANSAS ENGINEERING CONSULTANTS, INC.**

WICHITA, KANSAS

| DESIGNED BY: GJA | CHECKED BY: DLH & KJS |
|---|---|
| DRAWN BY: ALN | DATE: SHEET 4 OF 149 |

9156-1B