
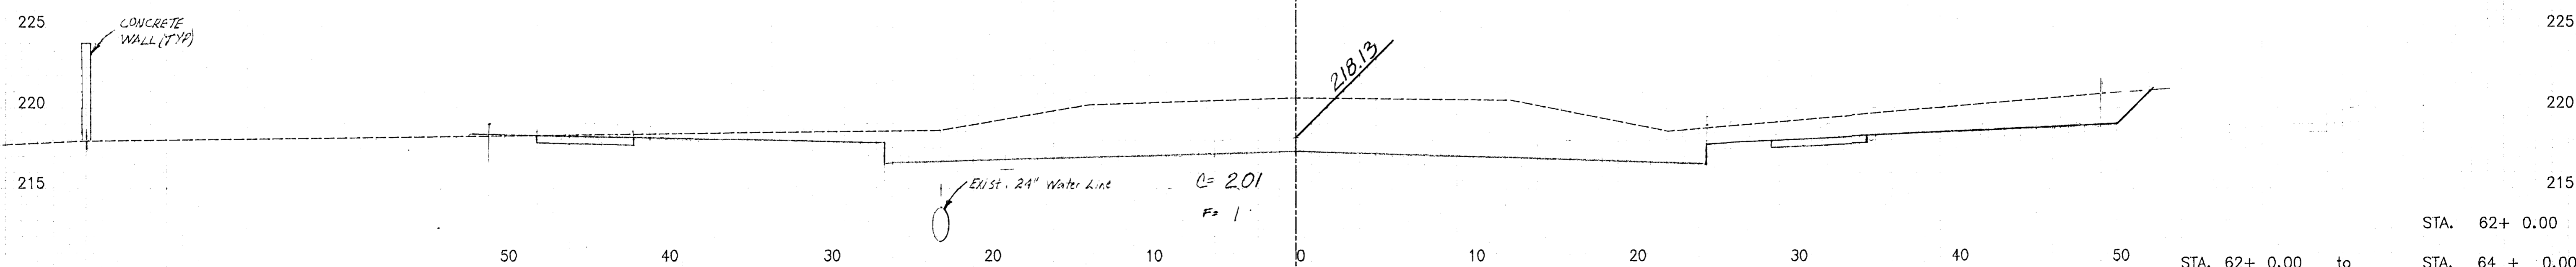
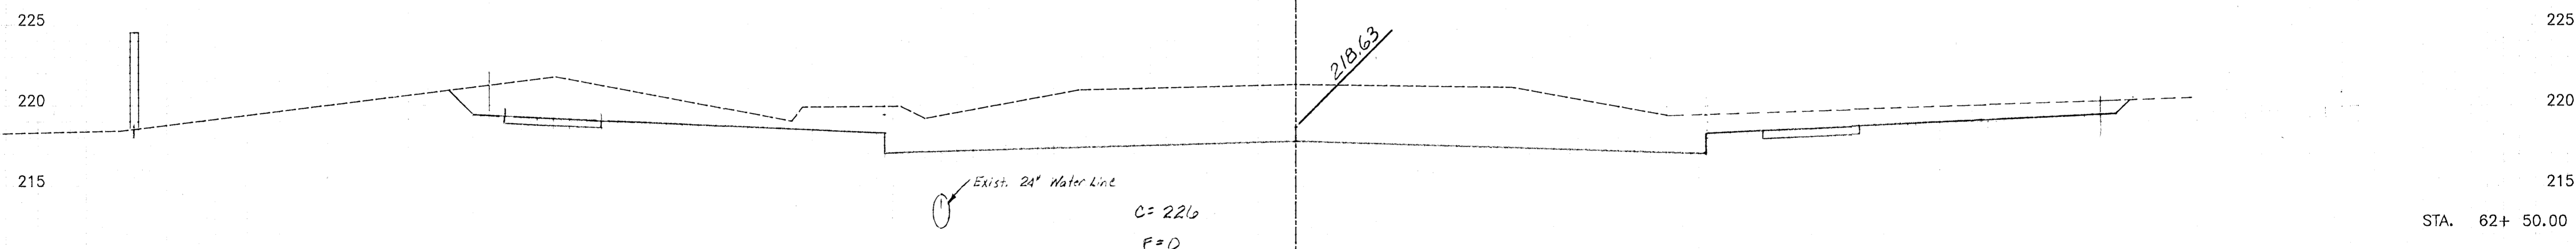
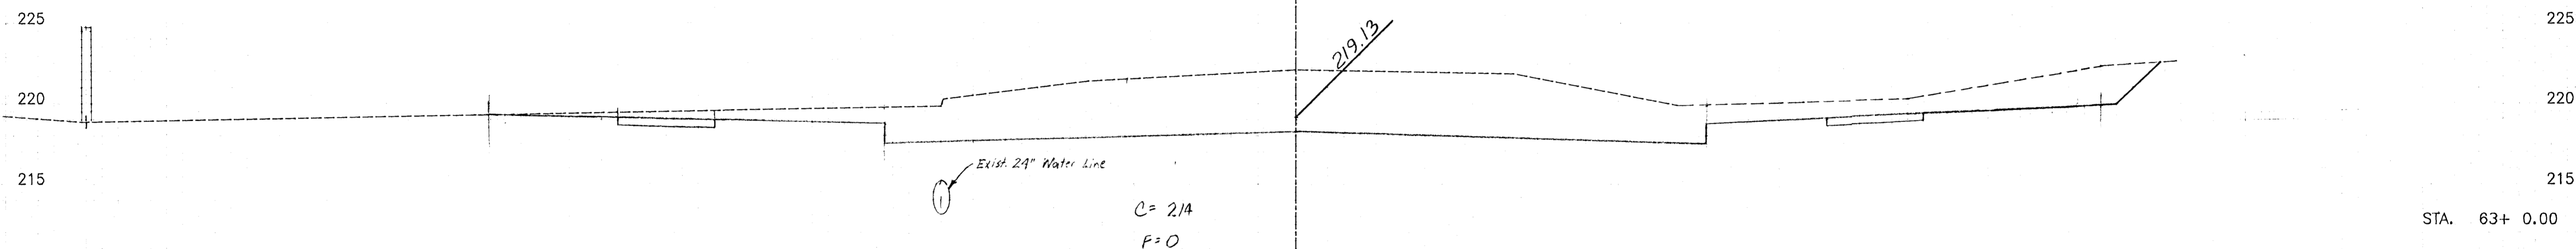
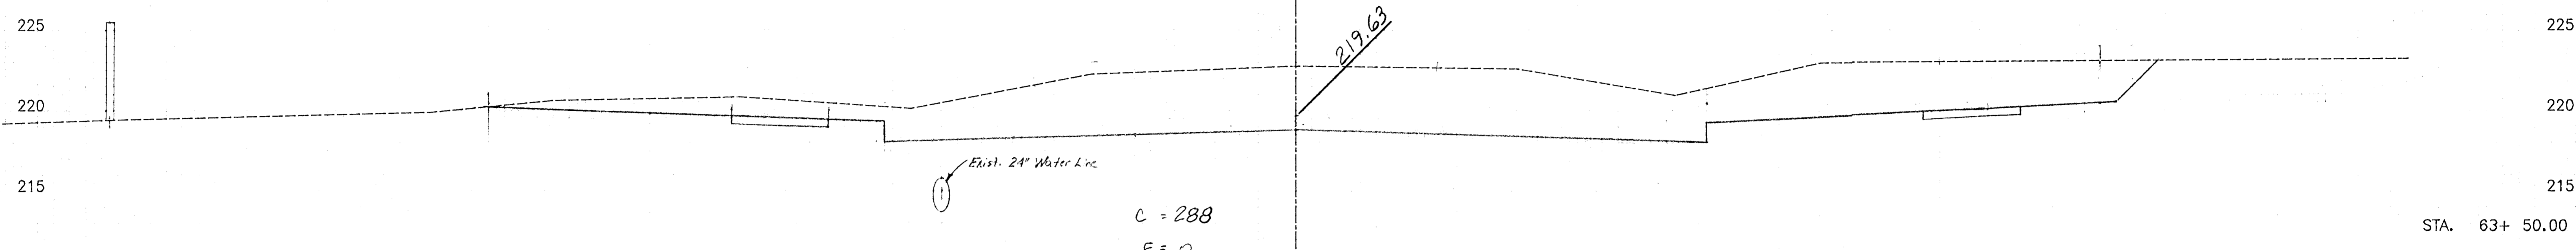


| PROJECT NO. | STATE | PROJECT NAME | YEAR | SHEET NO. | TOTAL SHEETS |
|-------------|--------|--------------|------|-----------|--------------|
| 7 | KANSAS | 87-U1362-01 | 1993 | 124 | 149 |

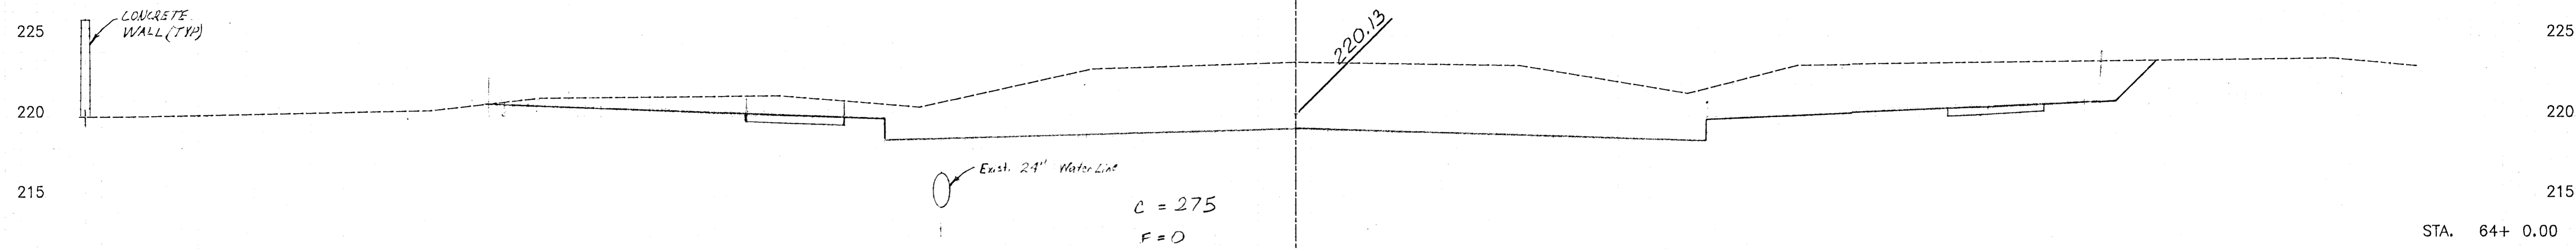

50 40 30 20 10 0 10 20 30 40 50 STA. 62+ 0.00 to STA. 64 + 0.00

WEBB ROAD

124
149