
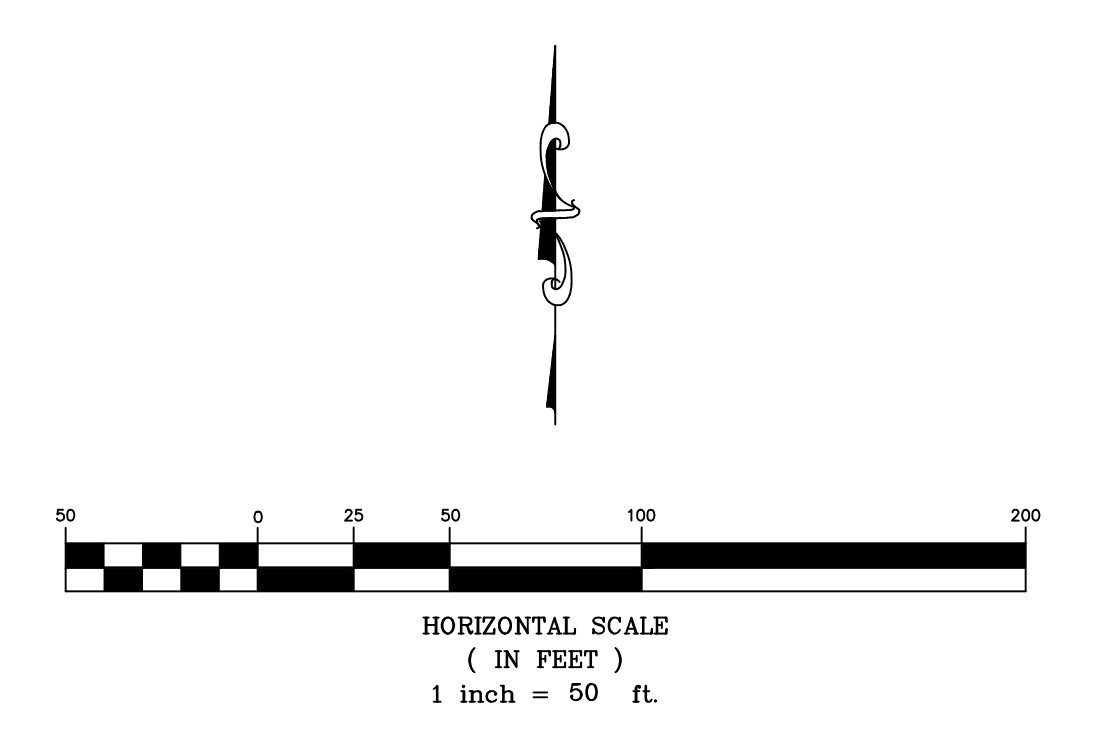



Added stockpile location for waste excavation
05/08/2018

 Stockpile Area

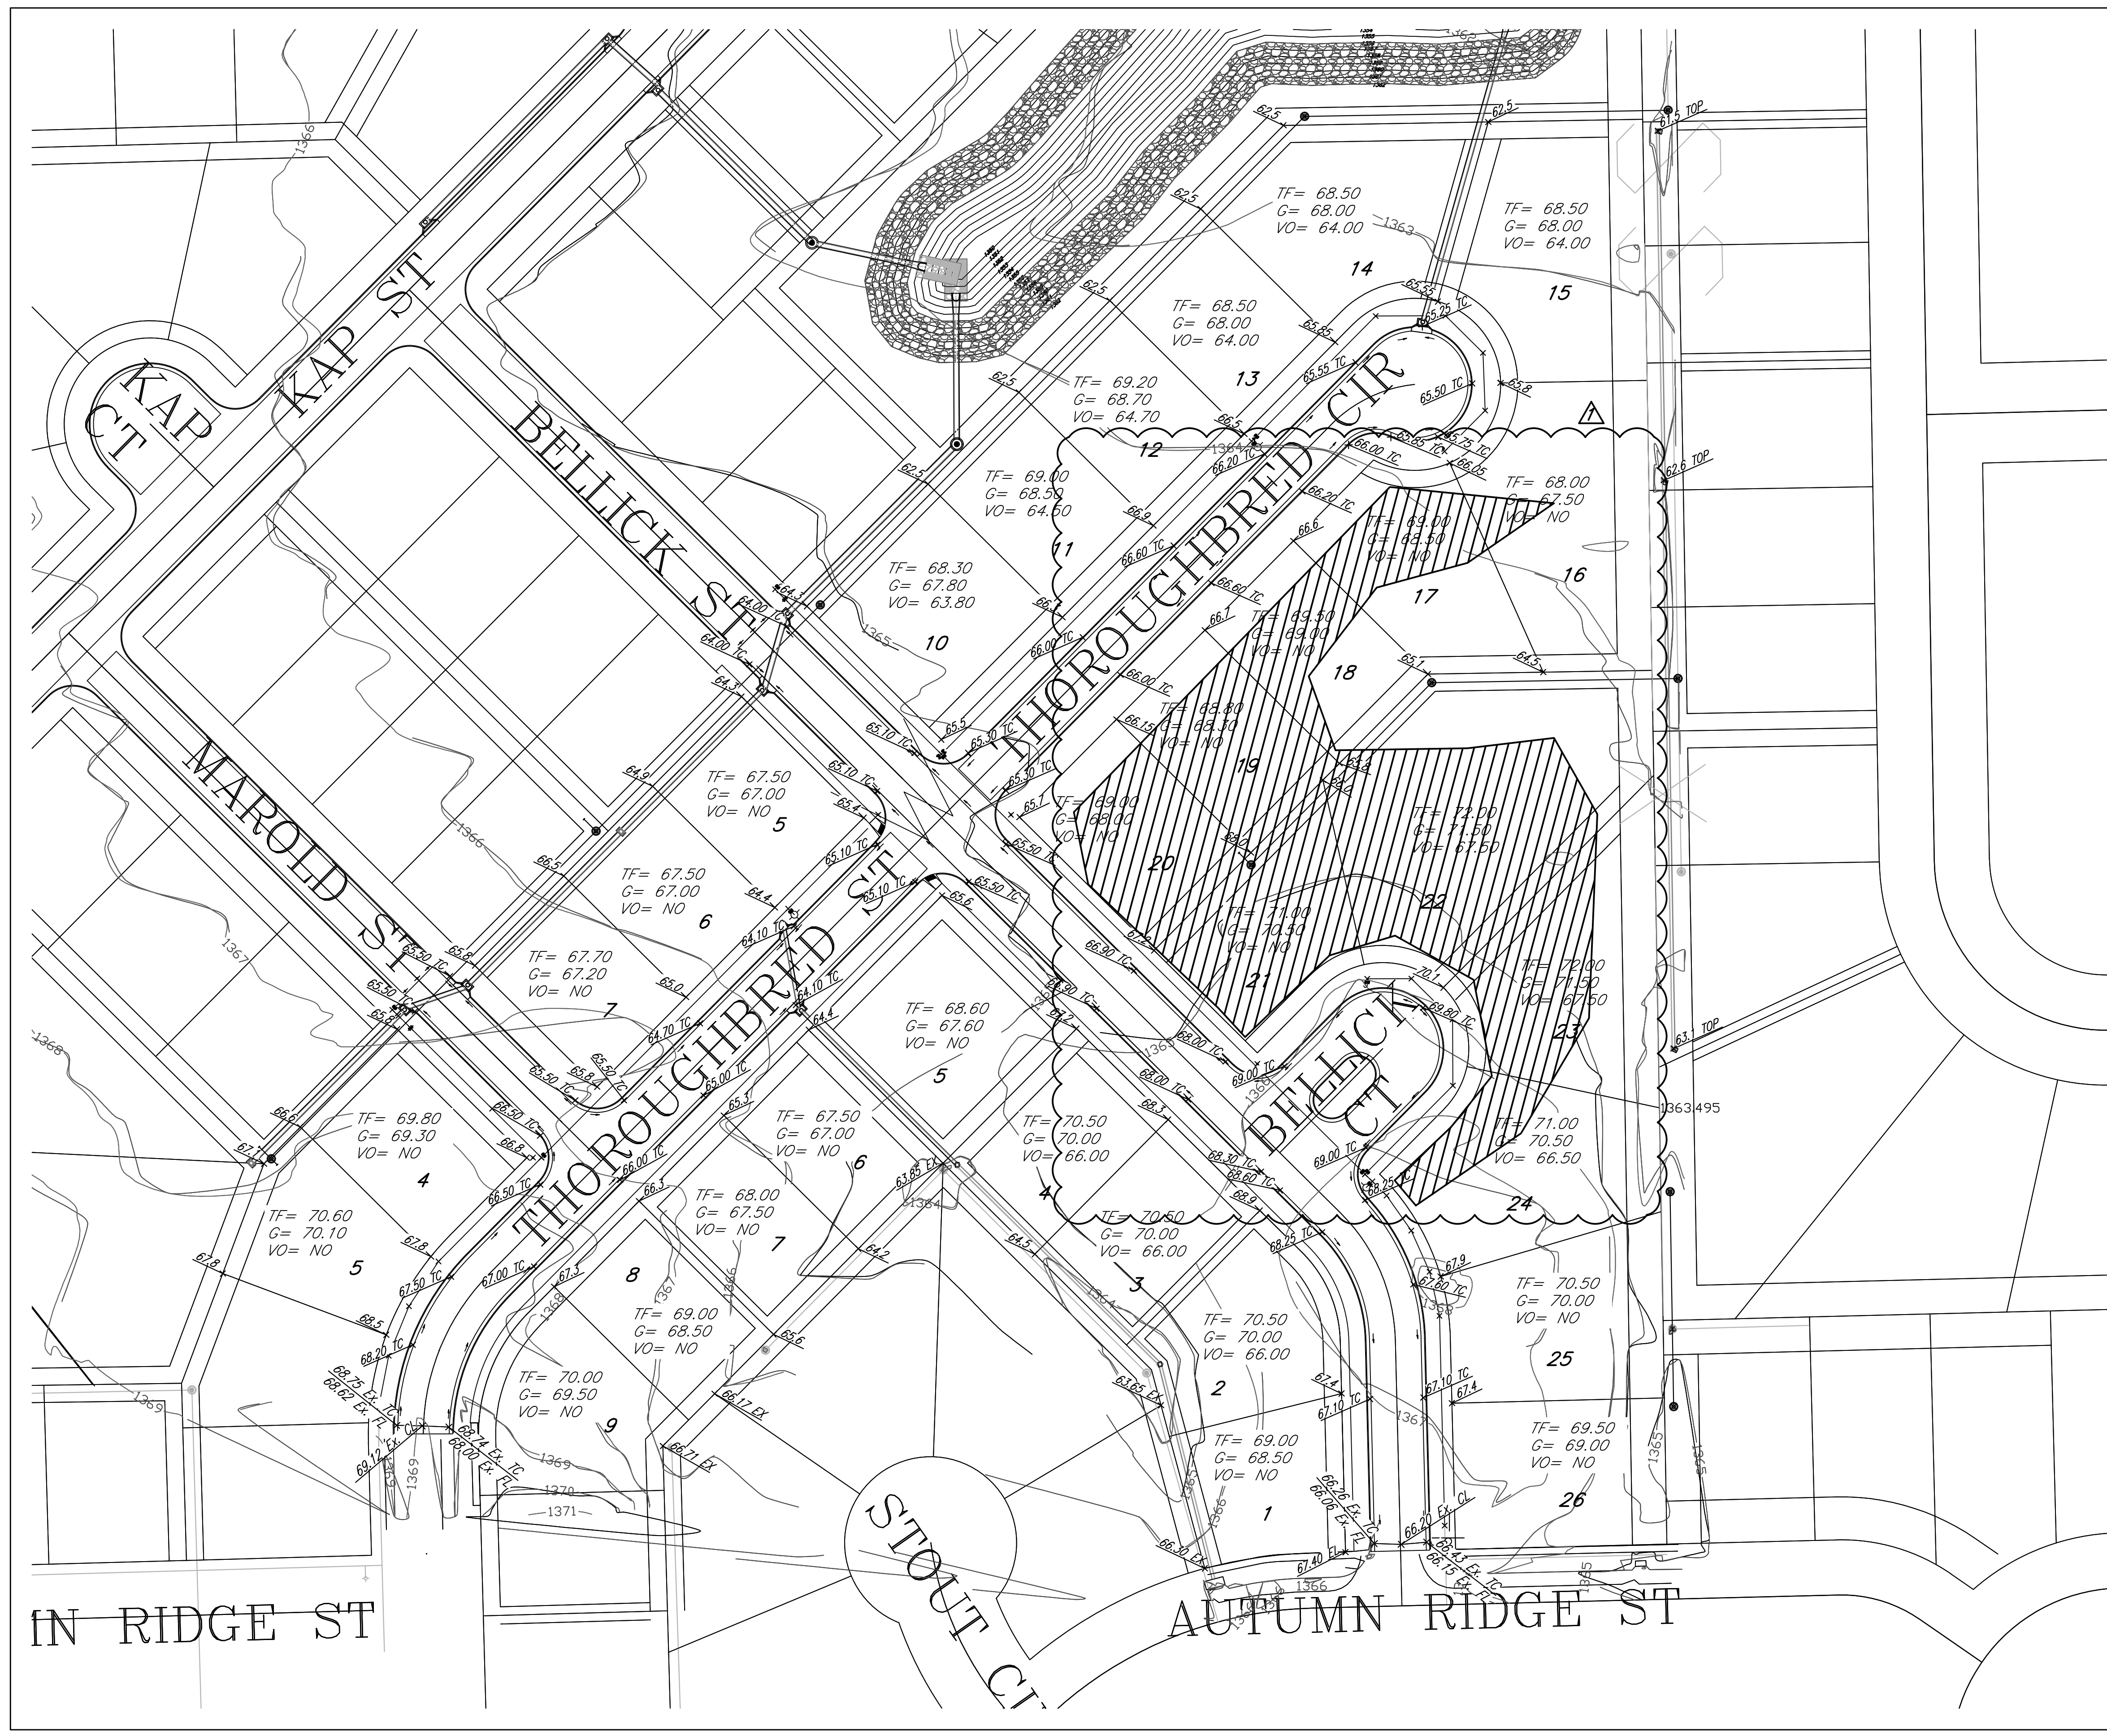

Cheryl's Hollow 2nd Addition - Phase 2
Lot Grading Plan
Wichita, Kansas

	PROJECT NUMBER 472-85405		
	KEM NO. 17104	FILE	DATE 08/2017
DESIGN KM	DRAWN SS	REVISED	SHEET 17.0

05/08/2018