FHWA REGION NO.	STATE	PROJECT NO.	FISCAL YEAR	SHEET NO.	TOTAL SHEETS
7	KANSAS	87N-0094-01	1998	34	202

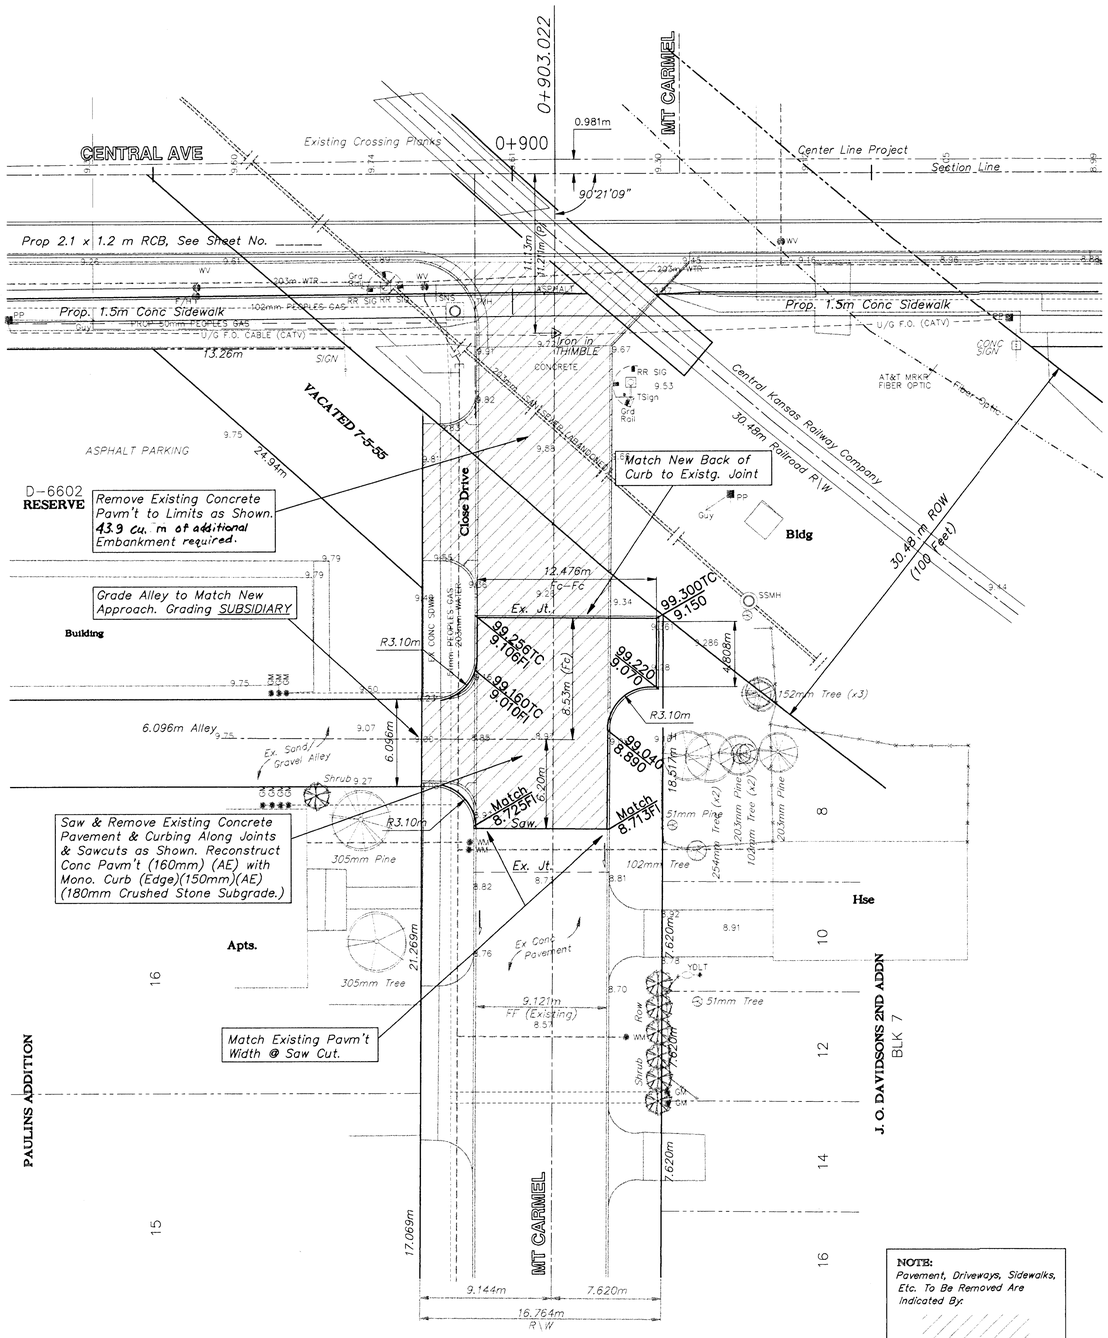

1 0 2 5m

Scale: 1:200

• = Iron

NOTE:
Pavement, Driveways, Sidewalks, Etc. To Be Removed Are Indicated By:

KDOT METRIC

PROJECT NUMBER				
472 - 82906				
DESIGN	DRAWN	APPROVED	DATE	SCALE
STAFF	STAFF	JFB	NOV 98	NOTED

PROJ NUMBER 95 05 E026
DIRECTORY CENTZOO
SHEET NAME PAV15

CAPITAL IMPROVEMENT PROJECT
MT CARMEL
Cul-de-sac South of Central

BAUGHMAN COMPANY P. A.
ENGINEERING, SURVEYING, & PLANNING
316-262-7271 • 315 ELLIS • WICHITA, KANSAS 67211

SHEET 34 OF 202