
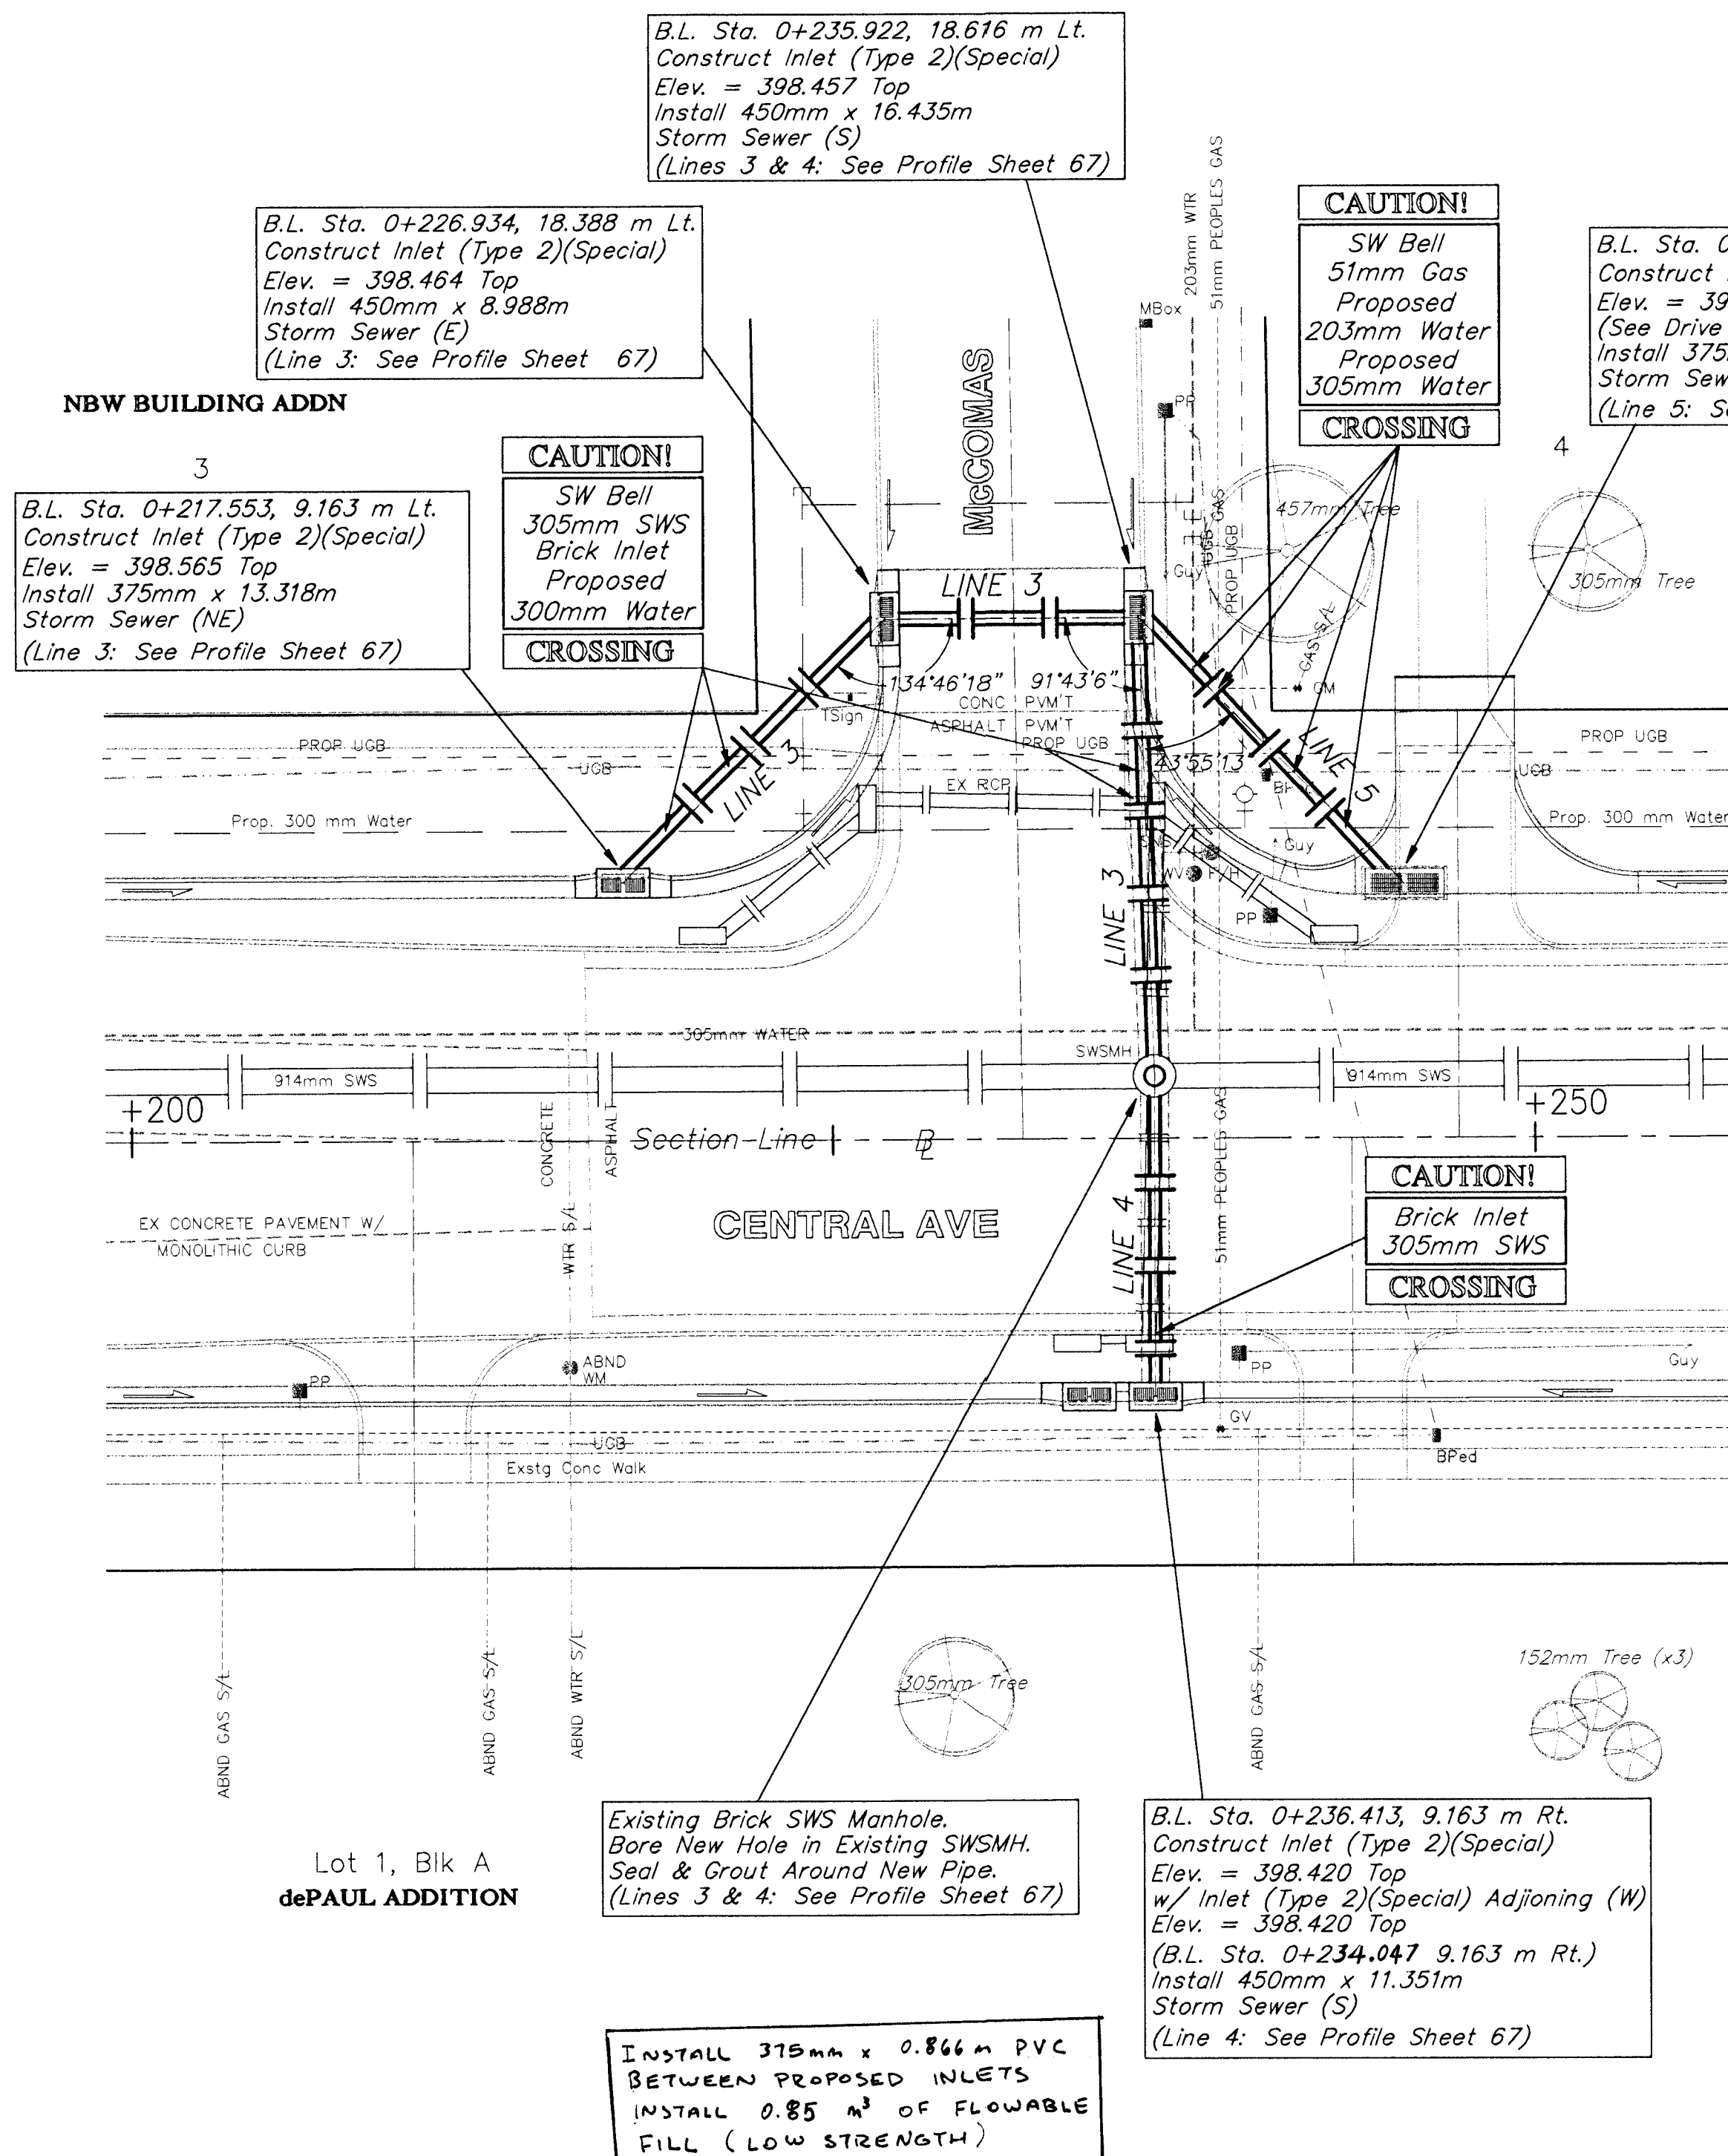




BENCHMARKS

BM #2 - "□" Top of Curb @ 4.72m West
and 27.83m North of the Centerline
of both Central and Kessler.
Elev. = 398.546 SI Units
(1307.55 MSL Datum)

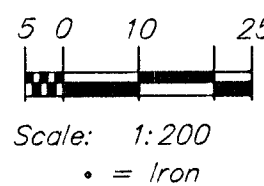

BENCHMARKS

BM #5 - City Disc Located @ 9.14m South
and 12.8m East of the Centerline
of both Sheridan and Central.
Elev. = 399.012 SI Units
(1309.08 MSL Datum)

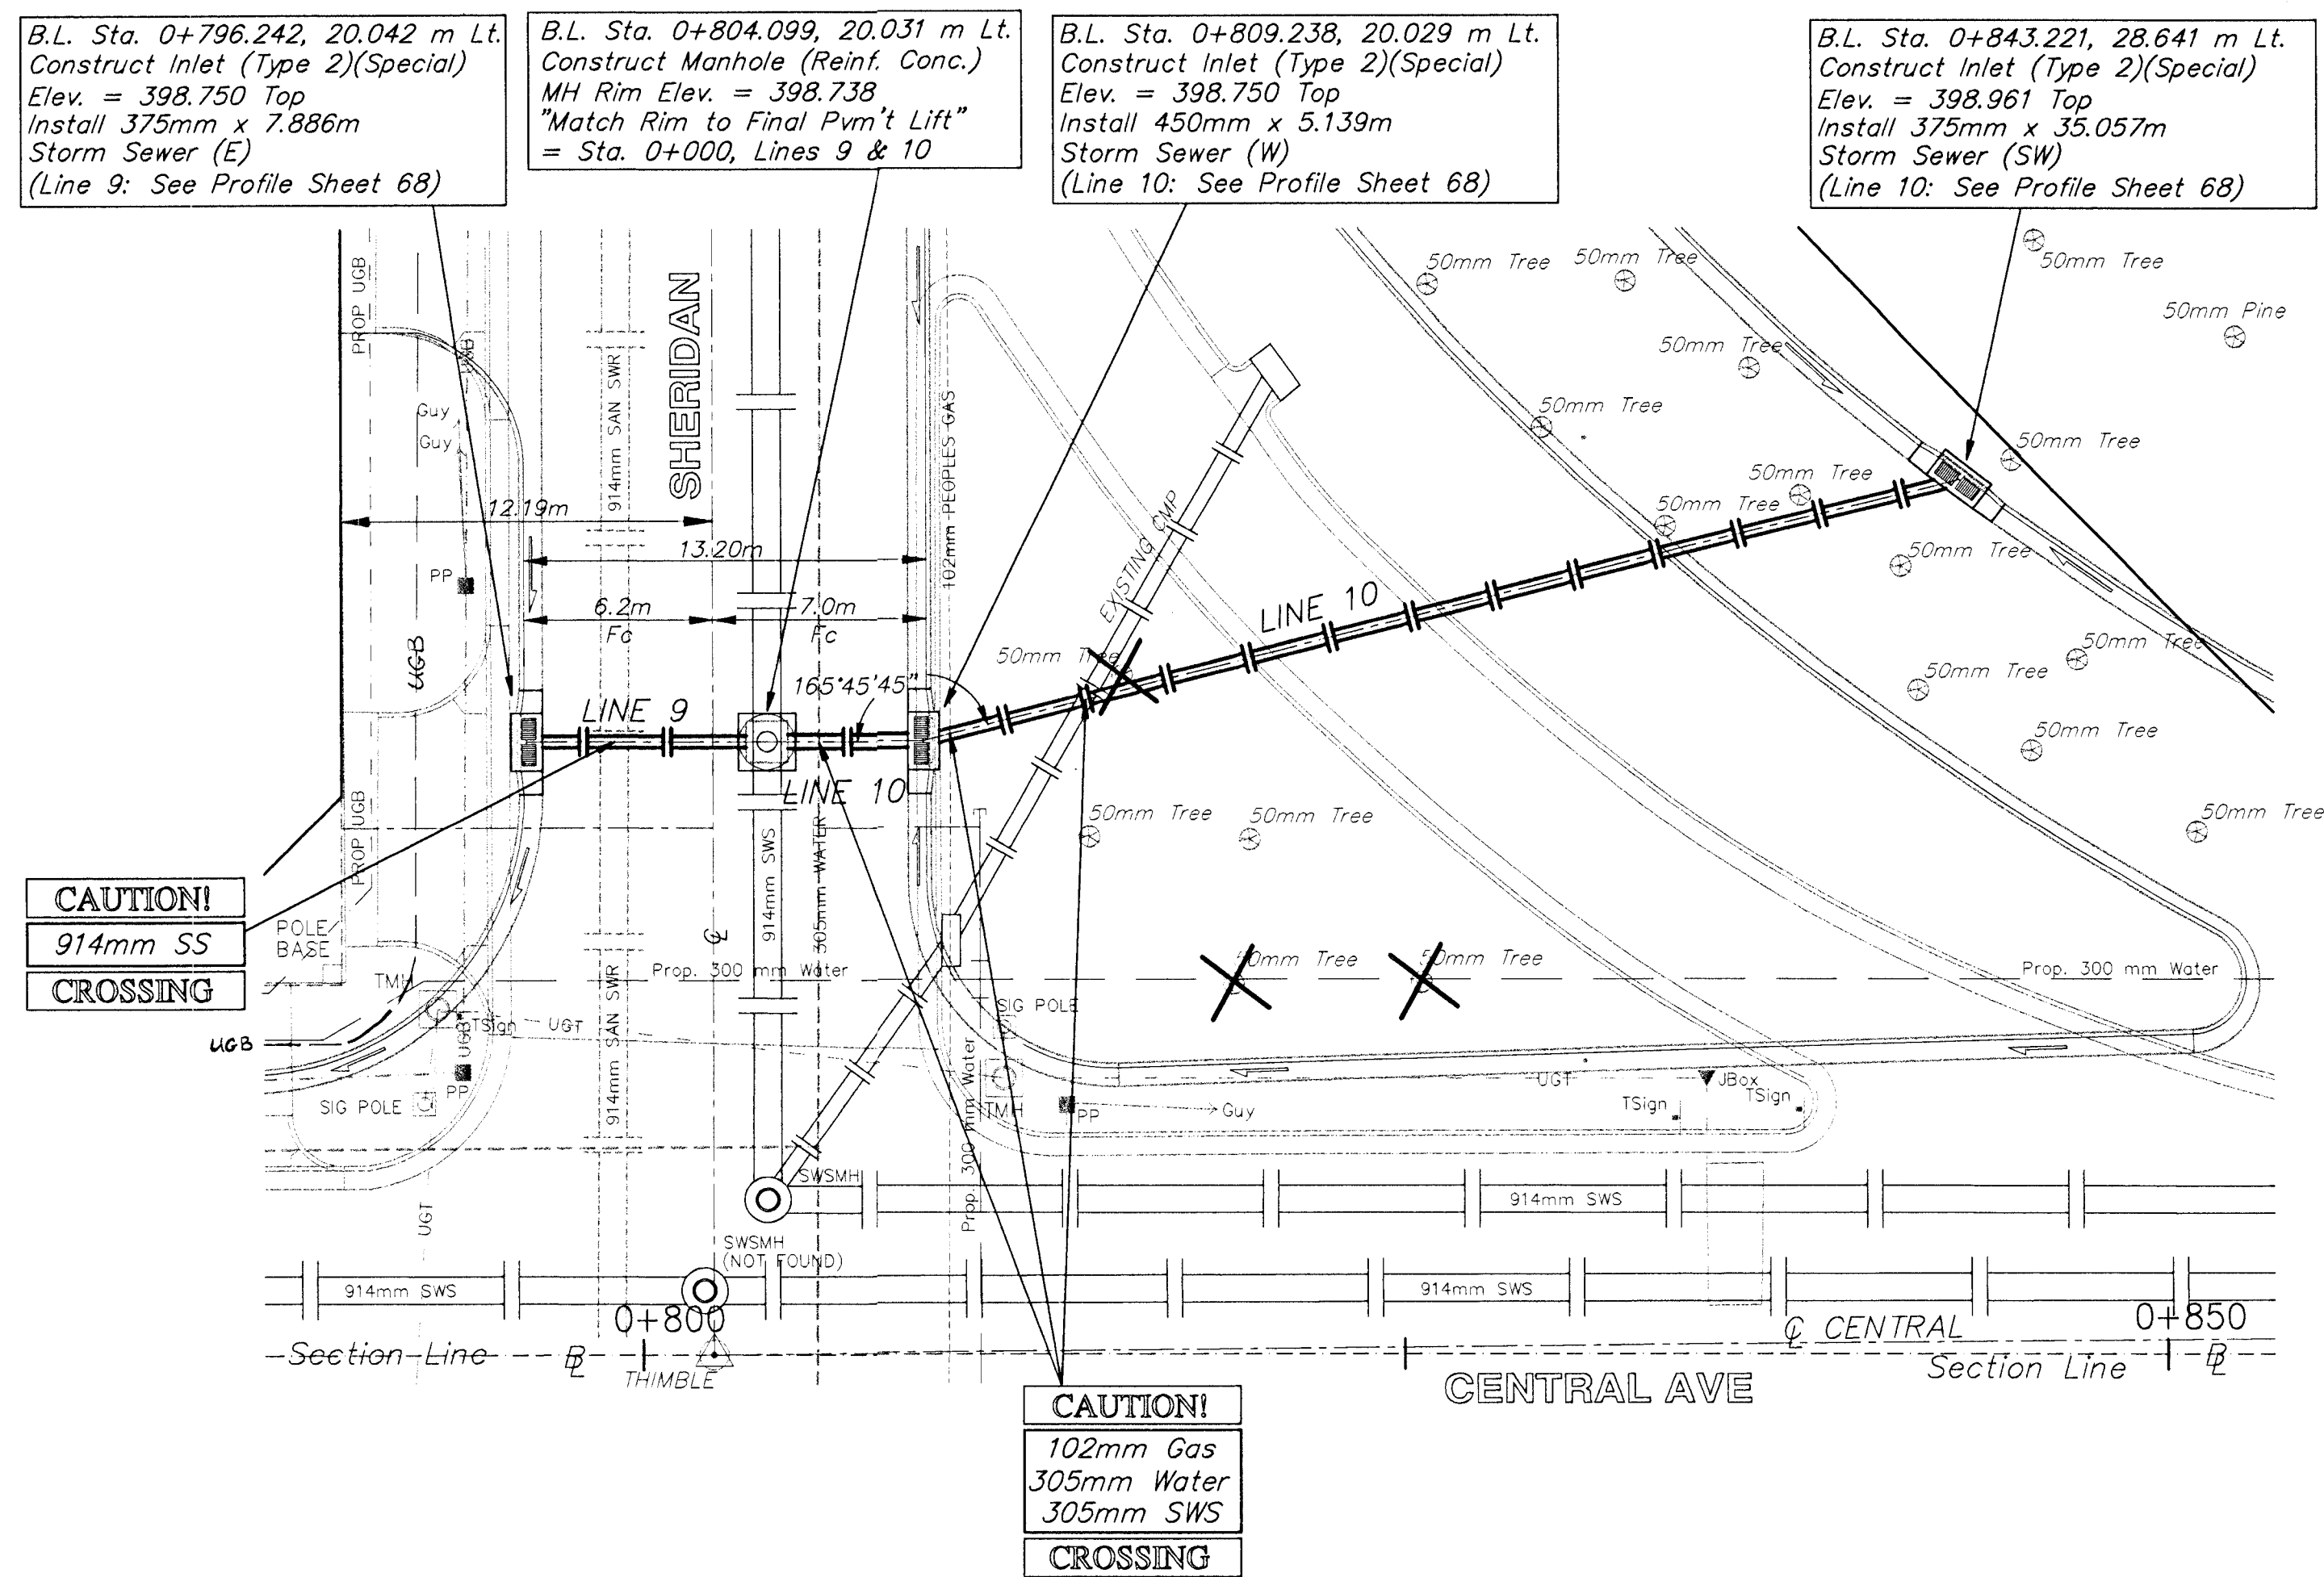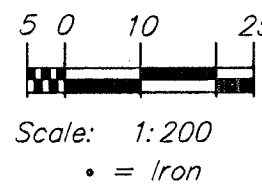

Removal of Existing SWS Inlets
and Existing SWS Pipe To Be
Plugged and Abandoned or
Removed as Required.
To Be Paid For As:
"Removal of Existing Structures"

