



BENCHMARK:  
City of Wichita benchmark at  
the SE corner of intersection  
of 135th Street West and 13th  
Street North.  
Elev. = 167.83 (City Datum)

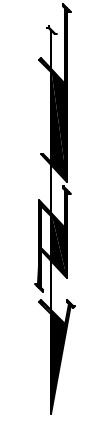

Scale: 1" = 40' Horizontal  
1" = 5' Vertical  
• = Iron

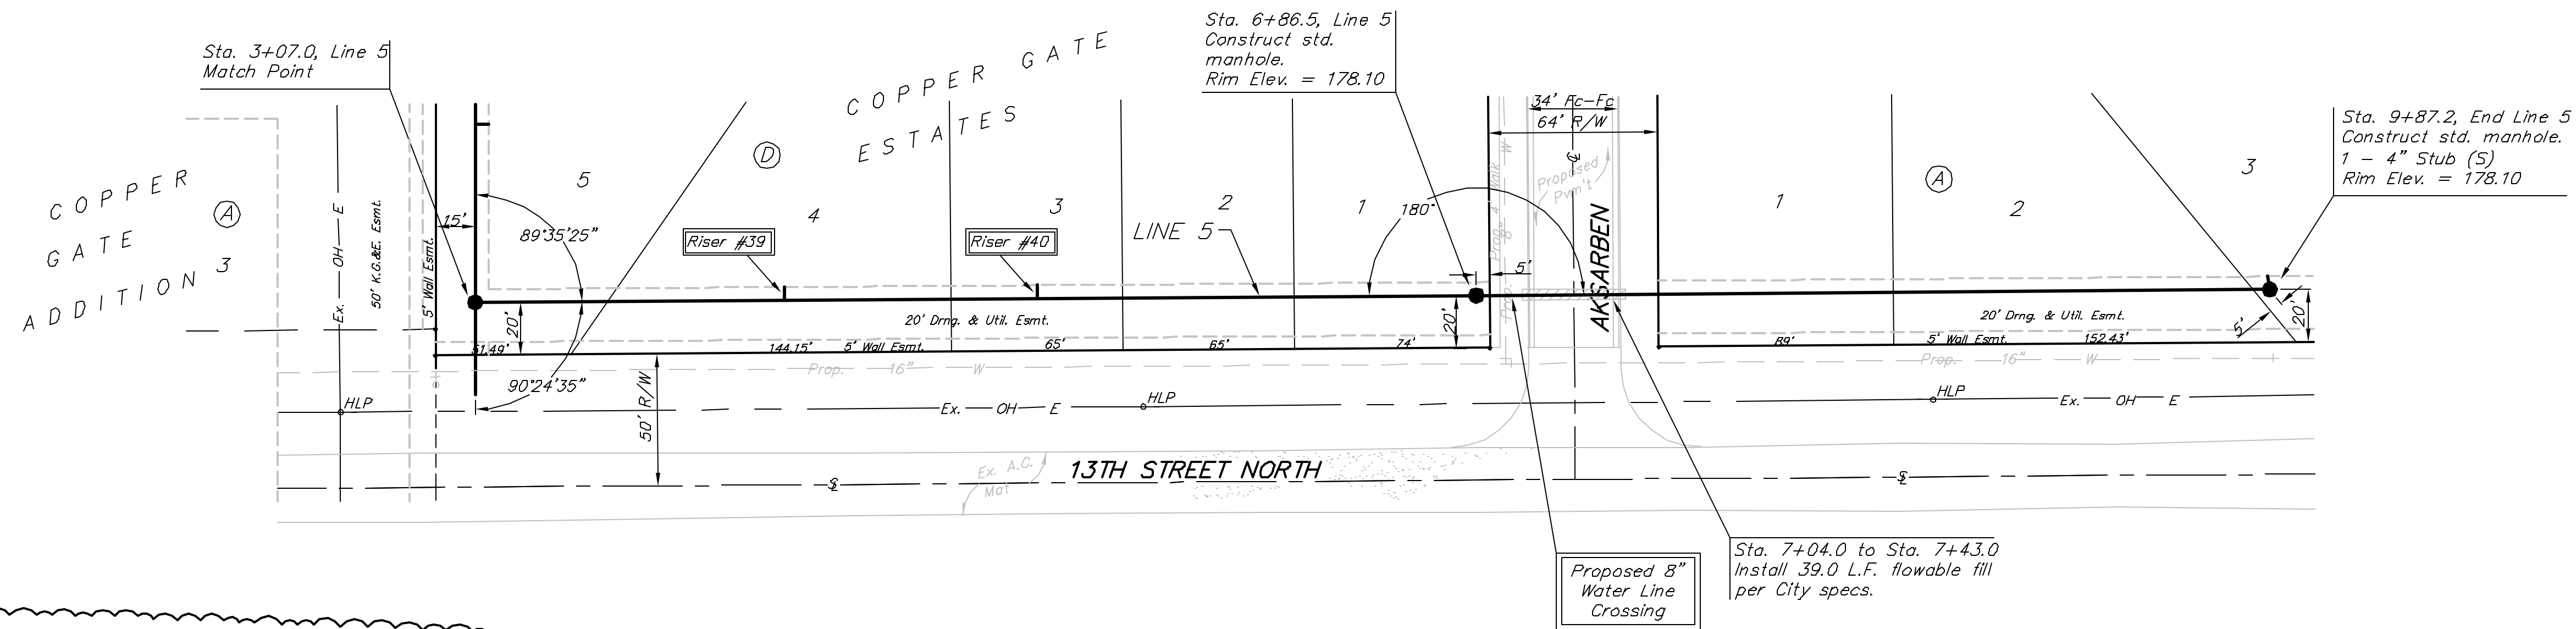


SEWER SERVICE TABLE

NUMBER	TYPE	LOCATION				FOR INFORMATION ONLY	
		LOT NO.	BLOCK NO.	LINE NO.	STATION/DIRECTION	APPROXIMATE LENGTH 4" PIPE	VERTICAL
39	B" X 4" Tee Saddle	4	D	5	4+24/Lt.	11.0'	5.0'
40	B" X 4" Tee Saddle	3	D	5	5+20/Lt.	10.0'	5.0'

NOTE: Vertical Riser Pipe shall be extended to 2' minimum above ground water elevation and 4' maximum below proposed ground elevation.

Revisions:

- 2 Revised Riser Table 2/3/03
- 1 Lowered Manhole Flow Elevation 2/3/03

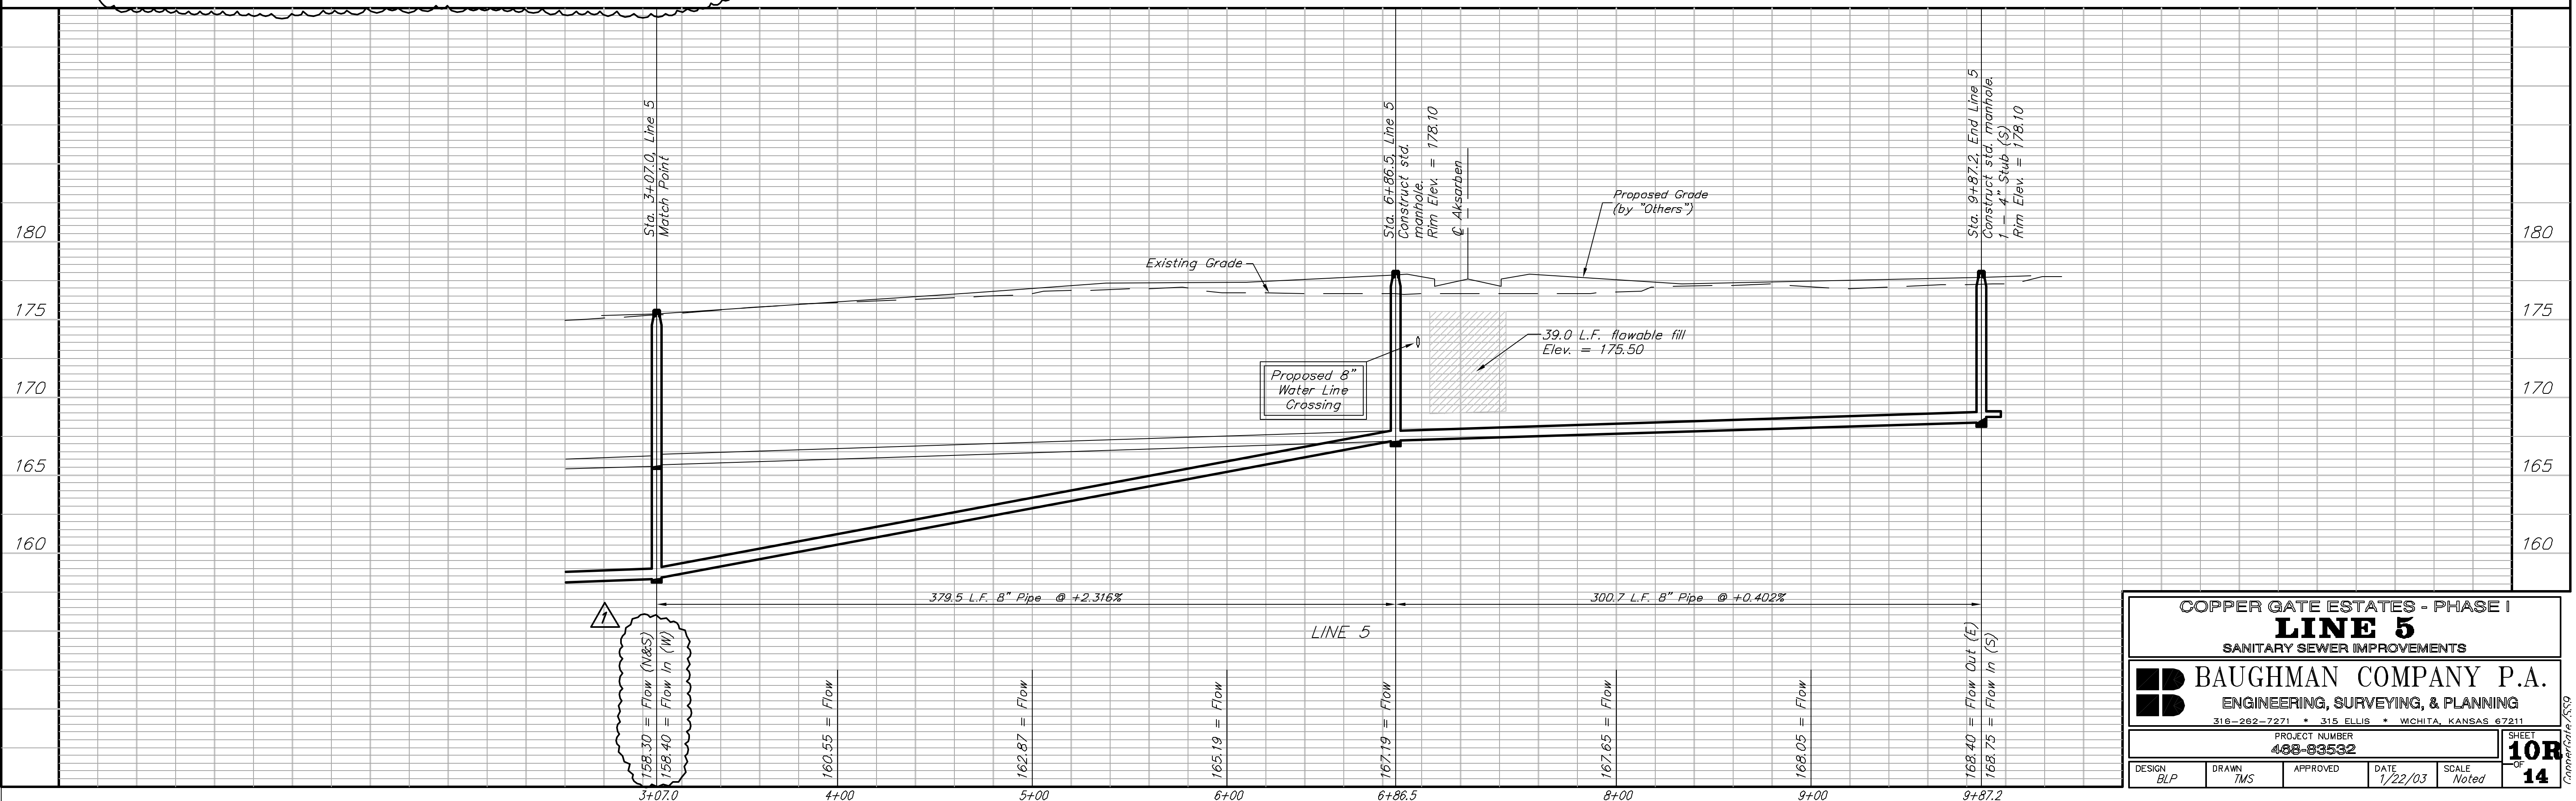

COPPER GATE ESTATES - PHASE I  
**LINE 5**  
SANITARY SEWER IMPROVEMENTS

**BAUGHMAN COMPANY P.A.**  
ENGINEERING, SURVEYING, & PLANNING  
318-262-7271 • 315 ELLIS • WICHITA, KANSAS 67211

PROJECT NUMBER  
**488-93532**

DESIGN: BLP | DRAWN: TMS | APPROVED: [ ] | DATE: 1/22/03 | SCALE: Noted

SHEET **10R** OF **14**