
BENCHMARKS:
BM #1: C.O.W. benchmark disk. 56' E and 55' N of CL 135th St. W. & 13th St. N.
Elev. = 167.83 (City Datum)

BM #2: 60D nail in HLP, 800' W & 31' N of the NE cor., NW1/4, Sec. 13, T-27-S, R-2-W.
Elev. = 162.68 (City Datum)

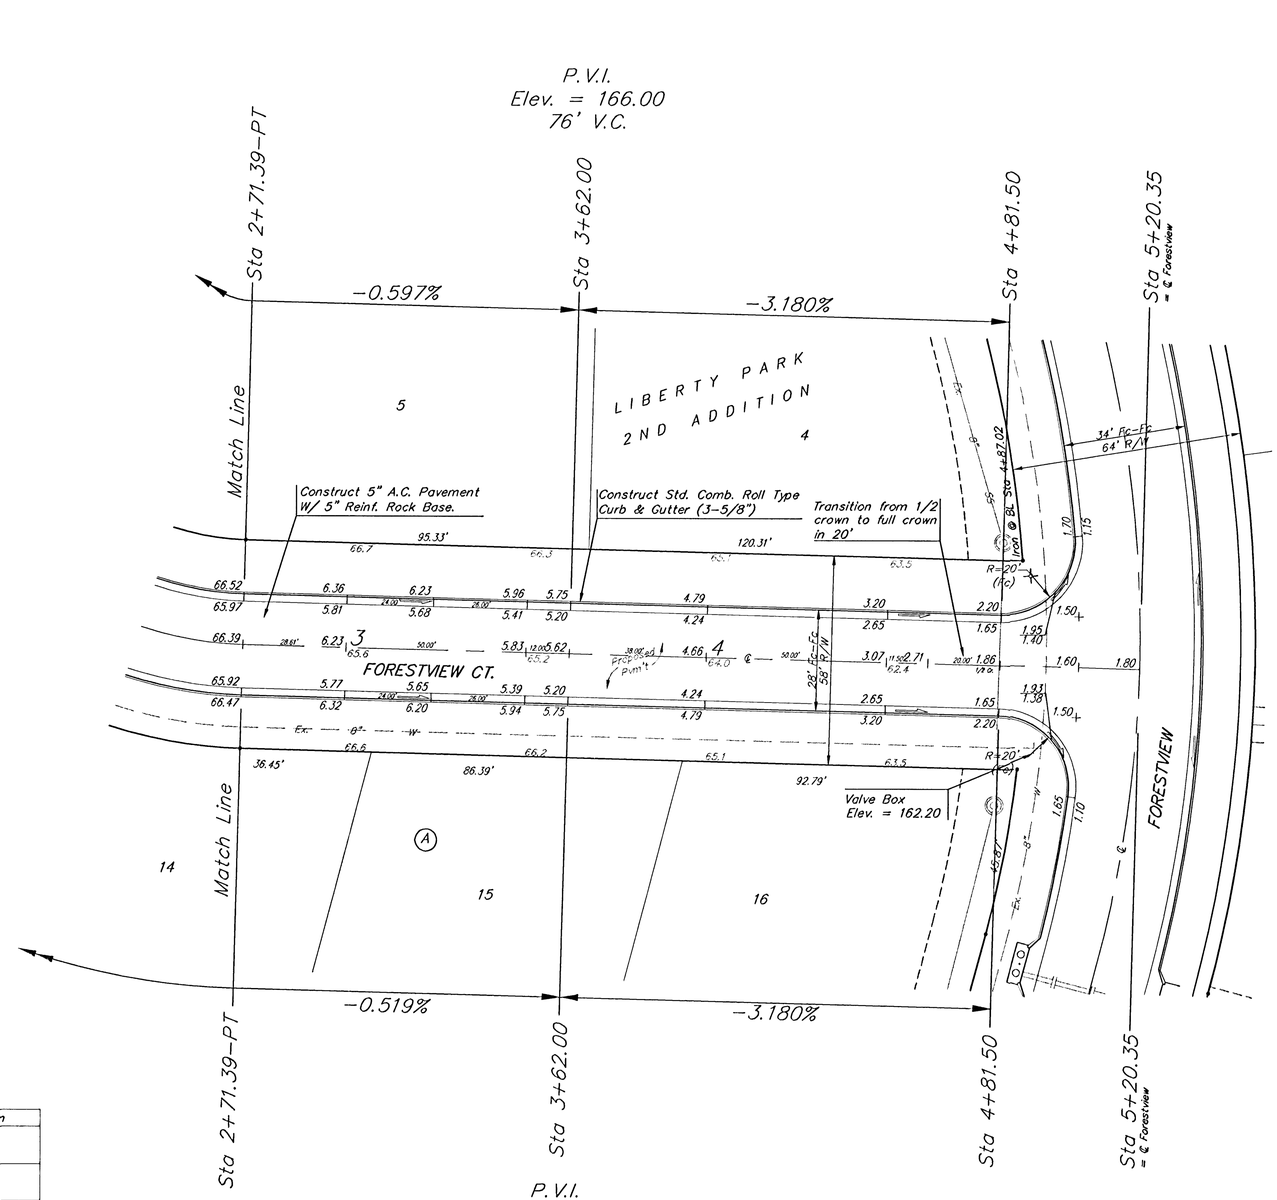

Scale: 1" = 20'
• = Iron

Subdivision Bench Marks

Street & Station	Location Description	Elevation
Forestview 5+29.60, 17.25' Lt.	Adjacent to Fire Hydrant at S. End of SW Curb Return of Forestview & Forestview Ct. (Lots 19-32, Block A)	
Forestview 12+09.35, 17.25' Lt.	Adjacent to Fire Hydrant adjacent to lot corner between Lots 2&3, Block A	
Forestview Ct. (Lots 5-18, Block A) 2+51.78, 14.25' Rt.	Adjacent to Fire Hydrant adjacent to lot corner between Lots 13&14, Block A	
Forestview Ct. (Lots 19-32, Block A) 2+32.86, 14.25' Lt.	Adjacent to Fire Hydrant adjacent to lot corner between Lots 19&20, Block A	
Forestview Ct. (Lots 33-43, Block A) 1+24.47, 14.25' Lt.	Adjacent to Fire Hydrant adjacent to lot corner between Lots 31&32, Block A	

NOTE: ROLL TYPE CURB & GUTTER TO BE CONSTRUCTED ON THE PAVEMENT SHOWN ON THIS SHEET. TOP OF CURB ELEVATIONS ARE GIVEN FOR FULL HEIGHT CURB.

LIBERTY PARK 2ND ADDITION - PHASE I
FORESTVIEW CT.
Lots 5-18, Block A

BAUGHMAN COMPANY P.A.
ENGINEERING, SURVEYING, & PLANNING
316-262-7271 • 315 ELLIS • WICHITA, KANSAS 67211

PROJECT NUMBER					SHEET
DESIGN NBW	DRAWN TMS	APPROVED	DATE 4/30/03	SCALE Noted	11 of 27

Liberty\Sht5 02-10-E423