
RR Spike in N. Face of PP in N. R/W of Maple N. of Nineiron. Elev. = 177.01 (City Datum)

"□" Cut center of north Headwall of RCBC in N. R/W of Maple 570' East of centerline of City View. Elev. = 187.91 (City Datum)

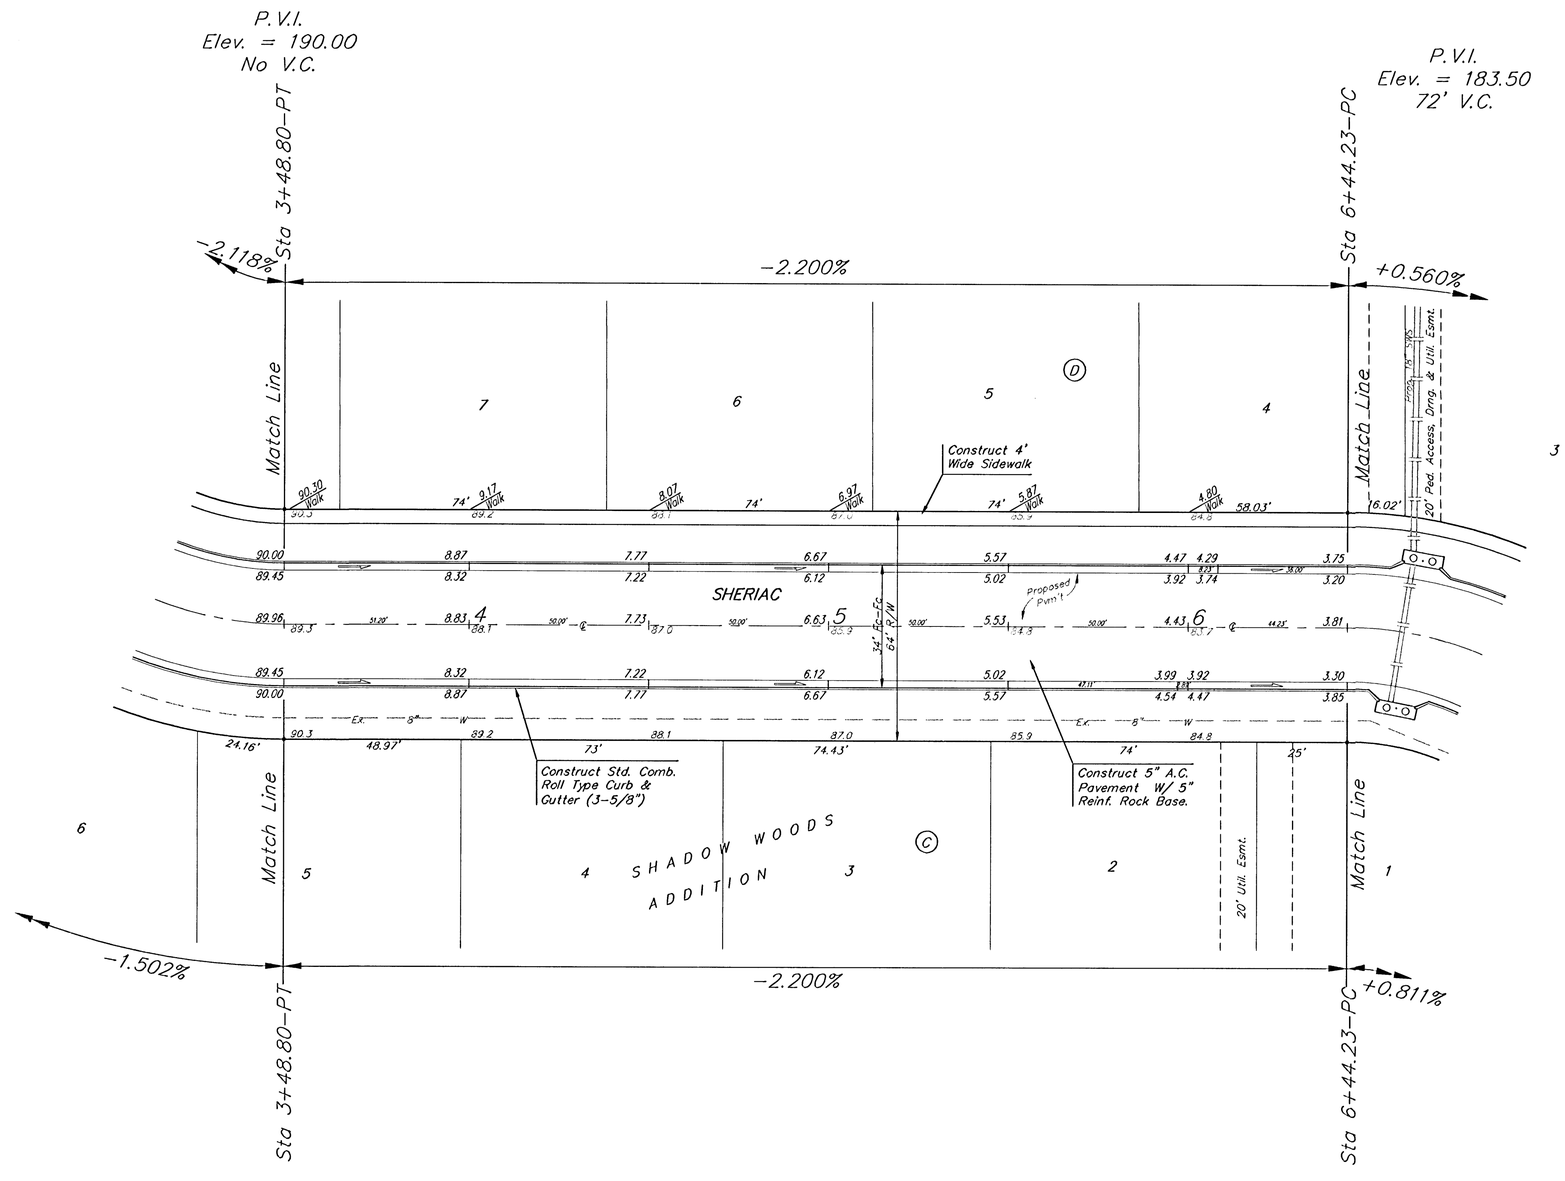

Scale: 1" = 20'
• = Iron

Subdivision Bench Marks

Street & Station	Location Description	Elevation
Sheriac Cir. 1+78.01, 14.25' Lt.	Adjacent to Fire Hydrant between Lots 17-18, Block C.	
Decker 0+31.90, 17.25' Rt.	Adjacent to Fire Hydrant at E. End of S. Curb Return of Sheriac & Decker.	
Decker Ct. 0+32.71, 14.25' Rt.	Adjacent to Fire Hydrant at E. End of S. Curb Return of Decker & Decker Ct.	

NOTE: ROLL TYPE CURB & GUTTER TO BE CONSTRUCTED ON THE PAVEMENT SHOWN ON THIS SHEET. TOP OF CURB ELEVATIONS ARE GIVEN FOR FULL HEIGHT CURB.

As Built

SHADOW WOODS ADDITION - PHASE IA
SHERIAC
STA 3+48.80 TO STA 8+44.23

BAUGHMAN COMPANY P.A.
ENGINEERING, SURVEYING, & PLANNING
316-262-7271 • 315 ELLIS • WICHITA, KANSAS 67211

PROJECT NUMBER	SHEET
472-83721	8 OF 37

DESIGN	DRAWN	APPROVED	DATE	SCALE
NBW	TMS		05-28-03	Noted

ShadowWoods-Sht2 05-01-E498