



RR Spike in N. Face of PP in
N. R/W of Maple N. of Nineiron.
Elev. = 177.01 (City Datum)

" " Cut center of north
Headwall of RCB in N. R/W of
Maple 570' East of centerline
of City View.
Elev. = 187.91 (City Datum)

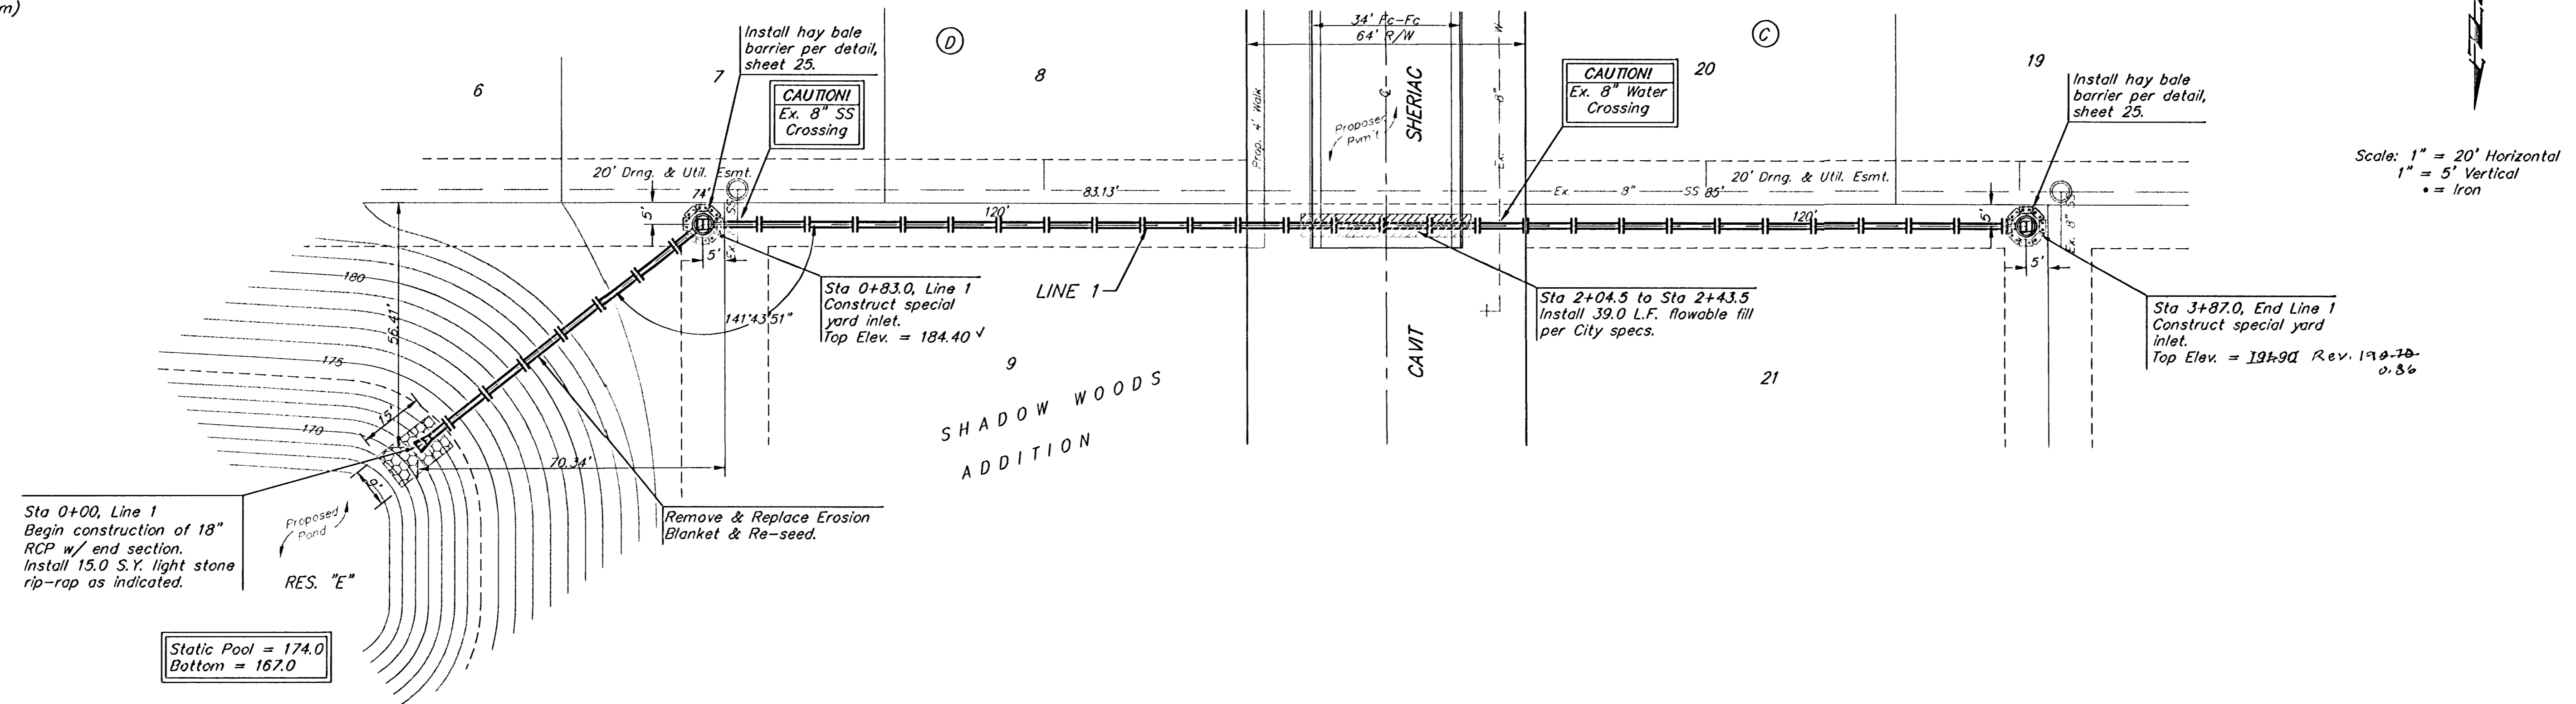

Scale: 1" = 20' Horizontal
1" = 5' Vertical
• = Iron

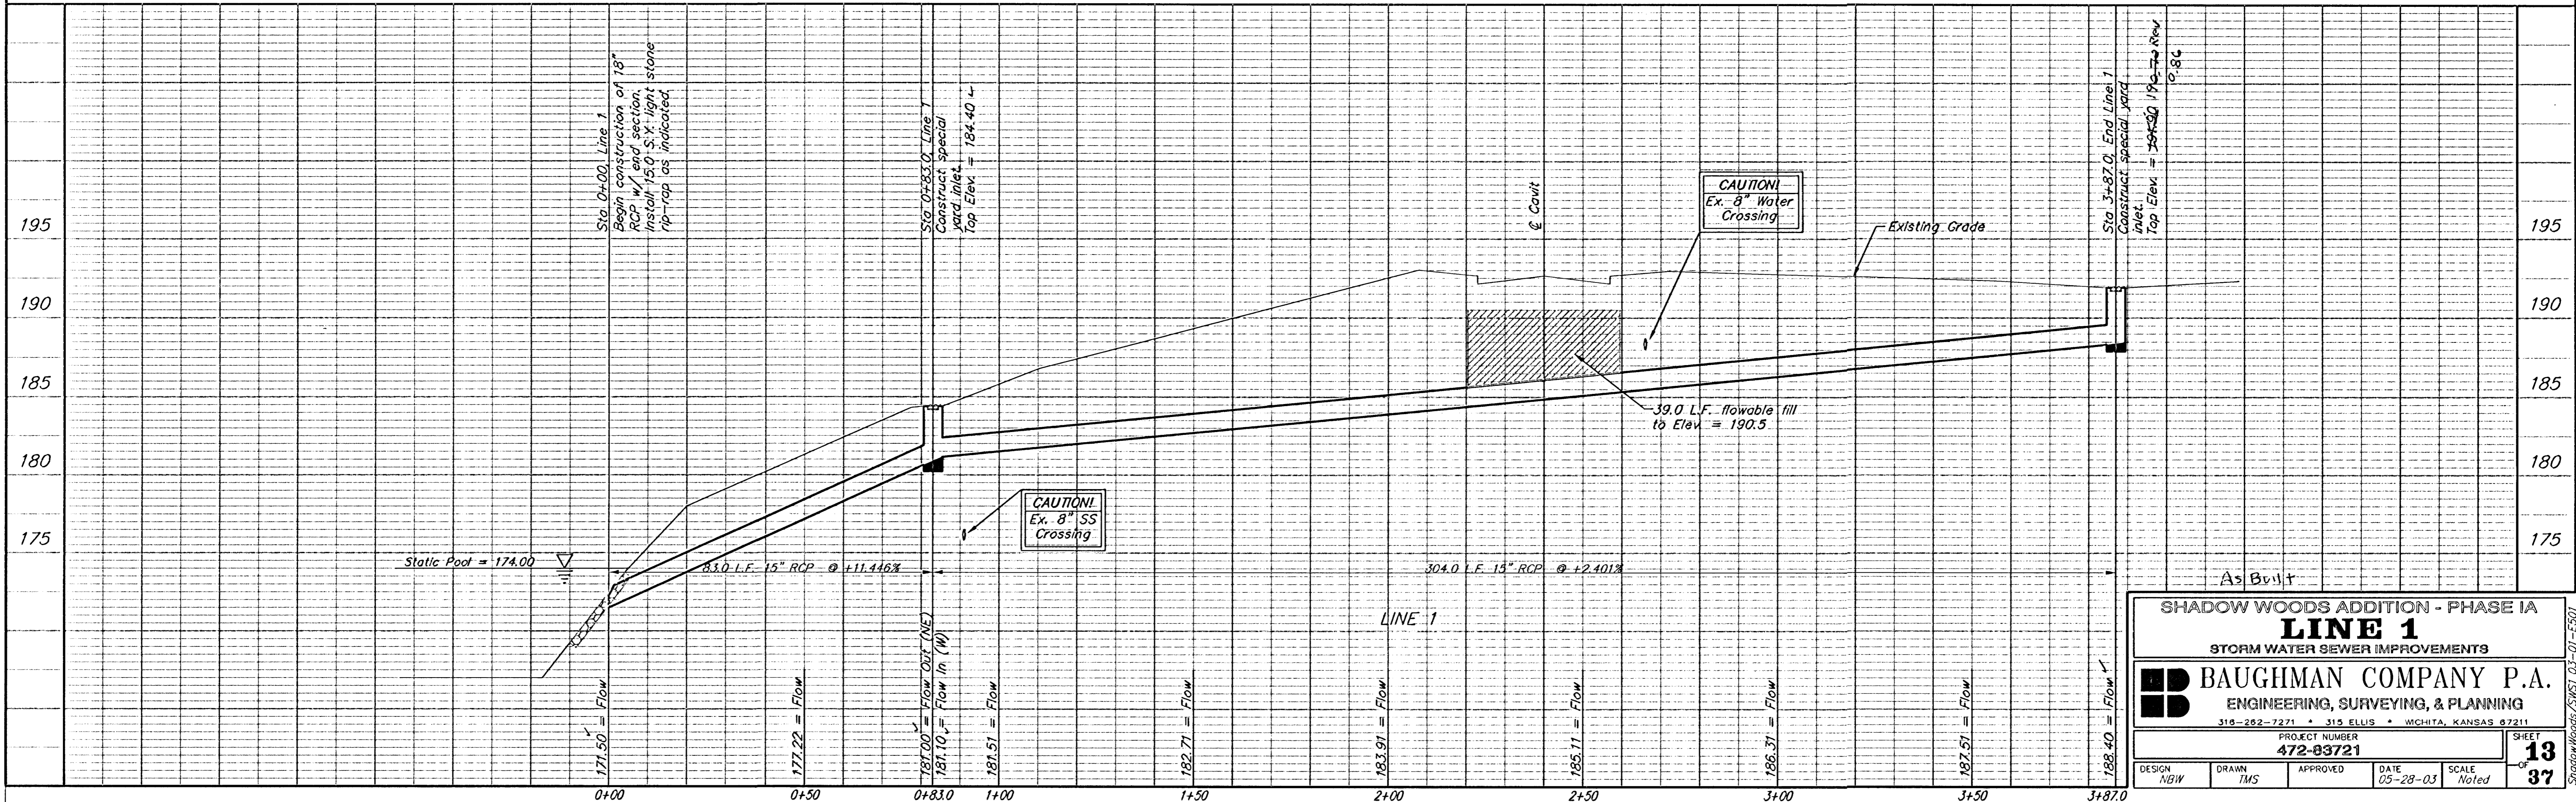

SHADOW WOODS ADDITION - PHASE IA
LINE 1
STORM WATER SEWER IMPROVEMENTS

BAUGHMAN COMPANY P.A.
ENGINEERING, SURVEYING, & PLANNING
318-262-7271 • 315 ELLIS • WICHITA, KANSAS 67211

PROJECT NUMBER
472-83721

DESIGN: NBW | DRAWN: IMS | APPROVED: [Signature] | DATE: 05-28-03 | SCALE: Noted

SHEET OF 37