

RR Spike in N. Face of PP in
N. R/W of Maple N. of Nineiron.
Elev. = 177.01 (City Datum)

" " Cut center of north
Headwall of RCBC in N. R/W of
Maple 570' East of centerline
of City View.
Elev. = 187.91 (City Datum)

Scale: 1" = 20' Horizontal
1" = 5' Vertical
• = Iron

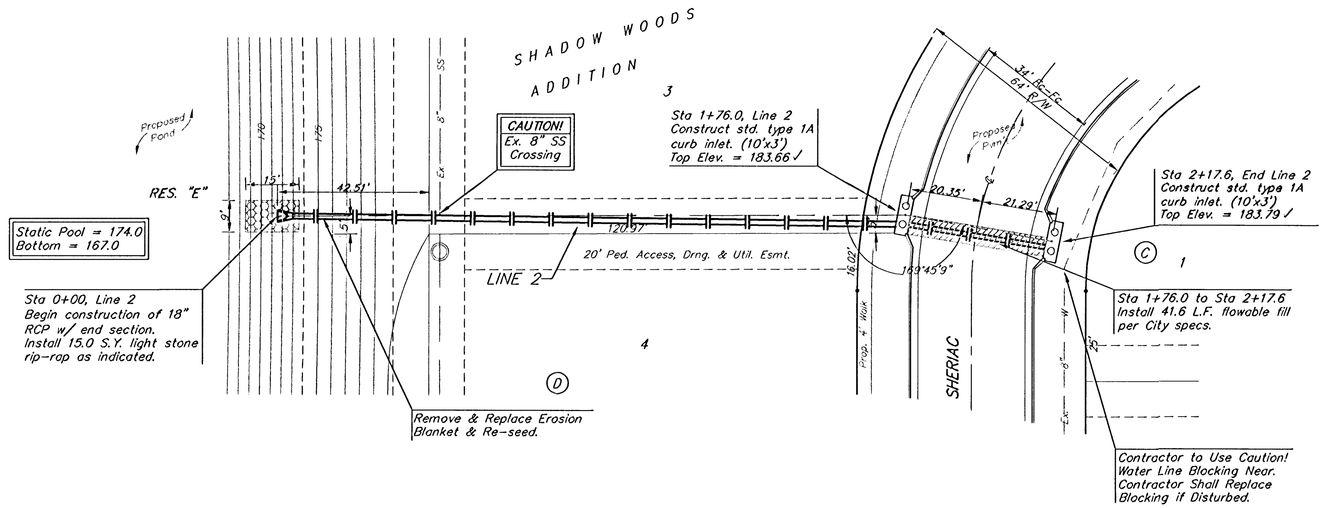

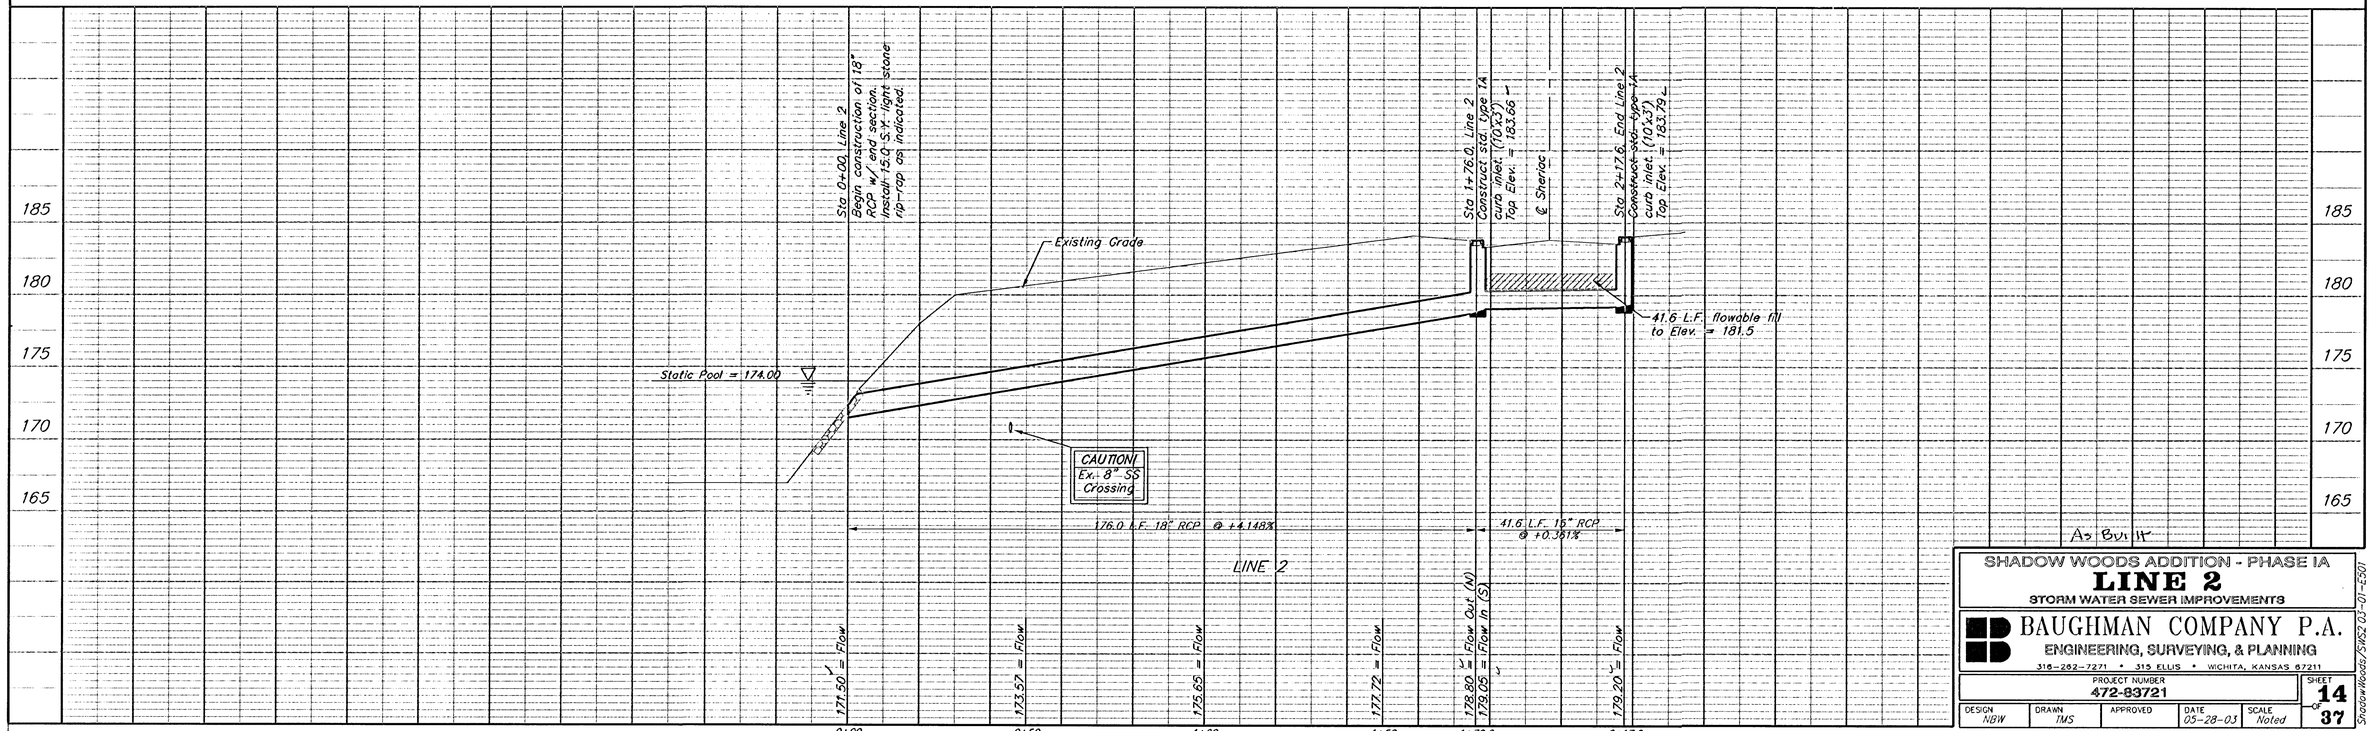

As Built

SHADOW WOODS ADDITION - PHASE IA
LINE 2
STORM WATER SEWER IMPROVEMENTS

BAUGHMAN COMPANY P.A.
ENGINEERING, SURVEYING, & PLANNING
316-262-7271 • 315 ELLIS • WICHITA, KANSAS 67211

PROJECT NUMBER	SHEET
472-83721	14 OF 37

DESIGN	DRAWN	APPROVED	DATE	SCALE
NBW	TMS		05-28-03	Noted

ShadowWoods/SHS2 03-01-2501