

RR Spike in N. Face of PP in N. R/W of Maple N. of Nineiron. Elev. = 177.01 (City Datum)

" " Cut center of north Headwall of RCBC in N. R/W of Maple 570' East of centerline of City View. Elev. = 187.91 (City Datum)

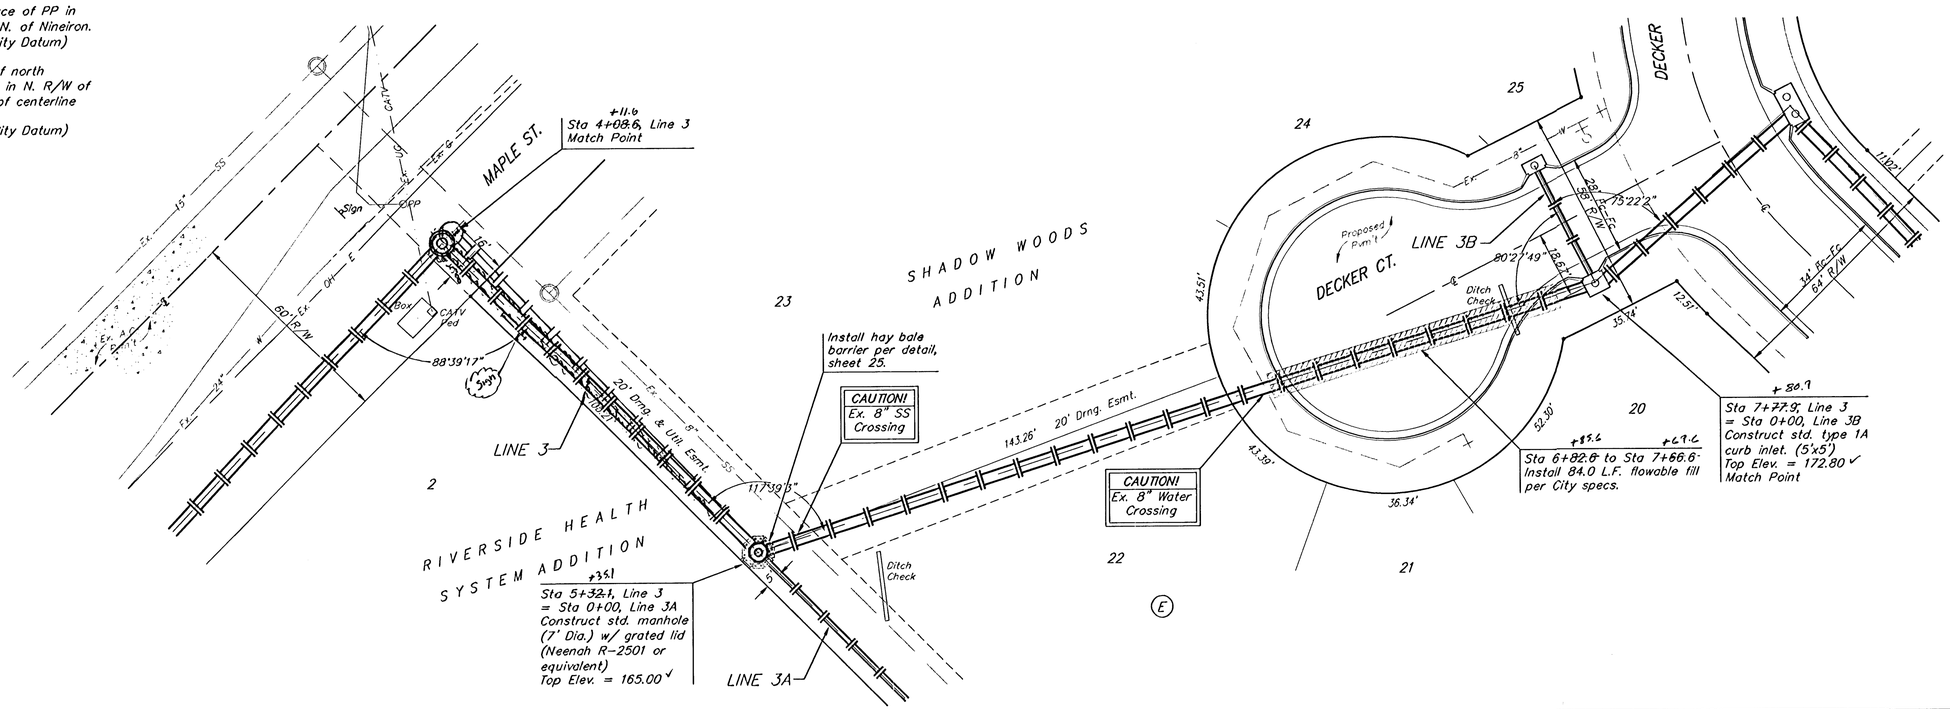

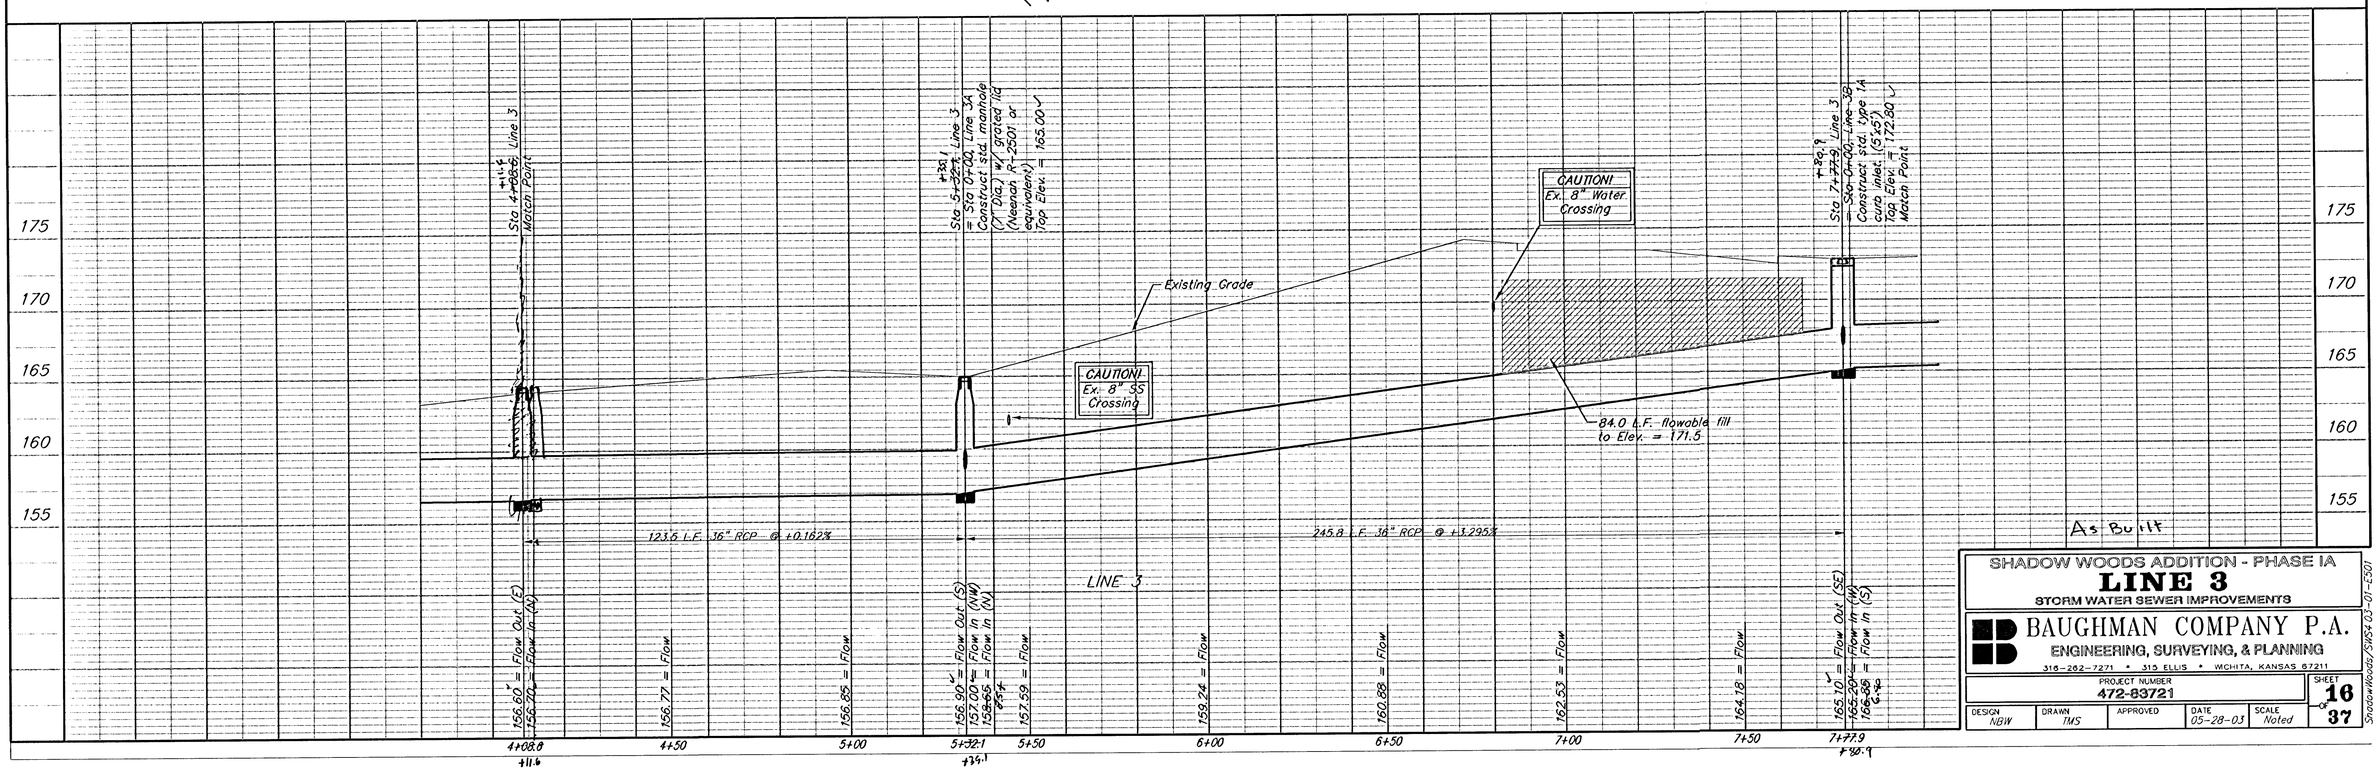

SHADOW WOODS ADDITION - PHASE IA

LINE 3

STORM WATER SEWER IMPROVEMENTS

BAUGHMAN COMPANY P.A.
ENGINEERING, SURVEYING, & PLANNING
316-262-7271 • 315 ELLIS • WICHITA, KANSAS 67211

PROJECT NUMBER					SHEET
472-83721					16 OF 37
DESIGN	DRAWN	APPROVED	DATE	SCALE	
NBW	TMS		05-28-03	Noted	

ShadowWoods/SWS4.03-01-ES01