
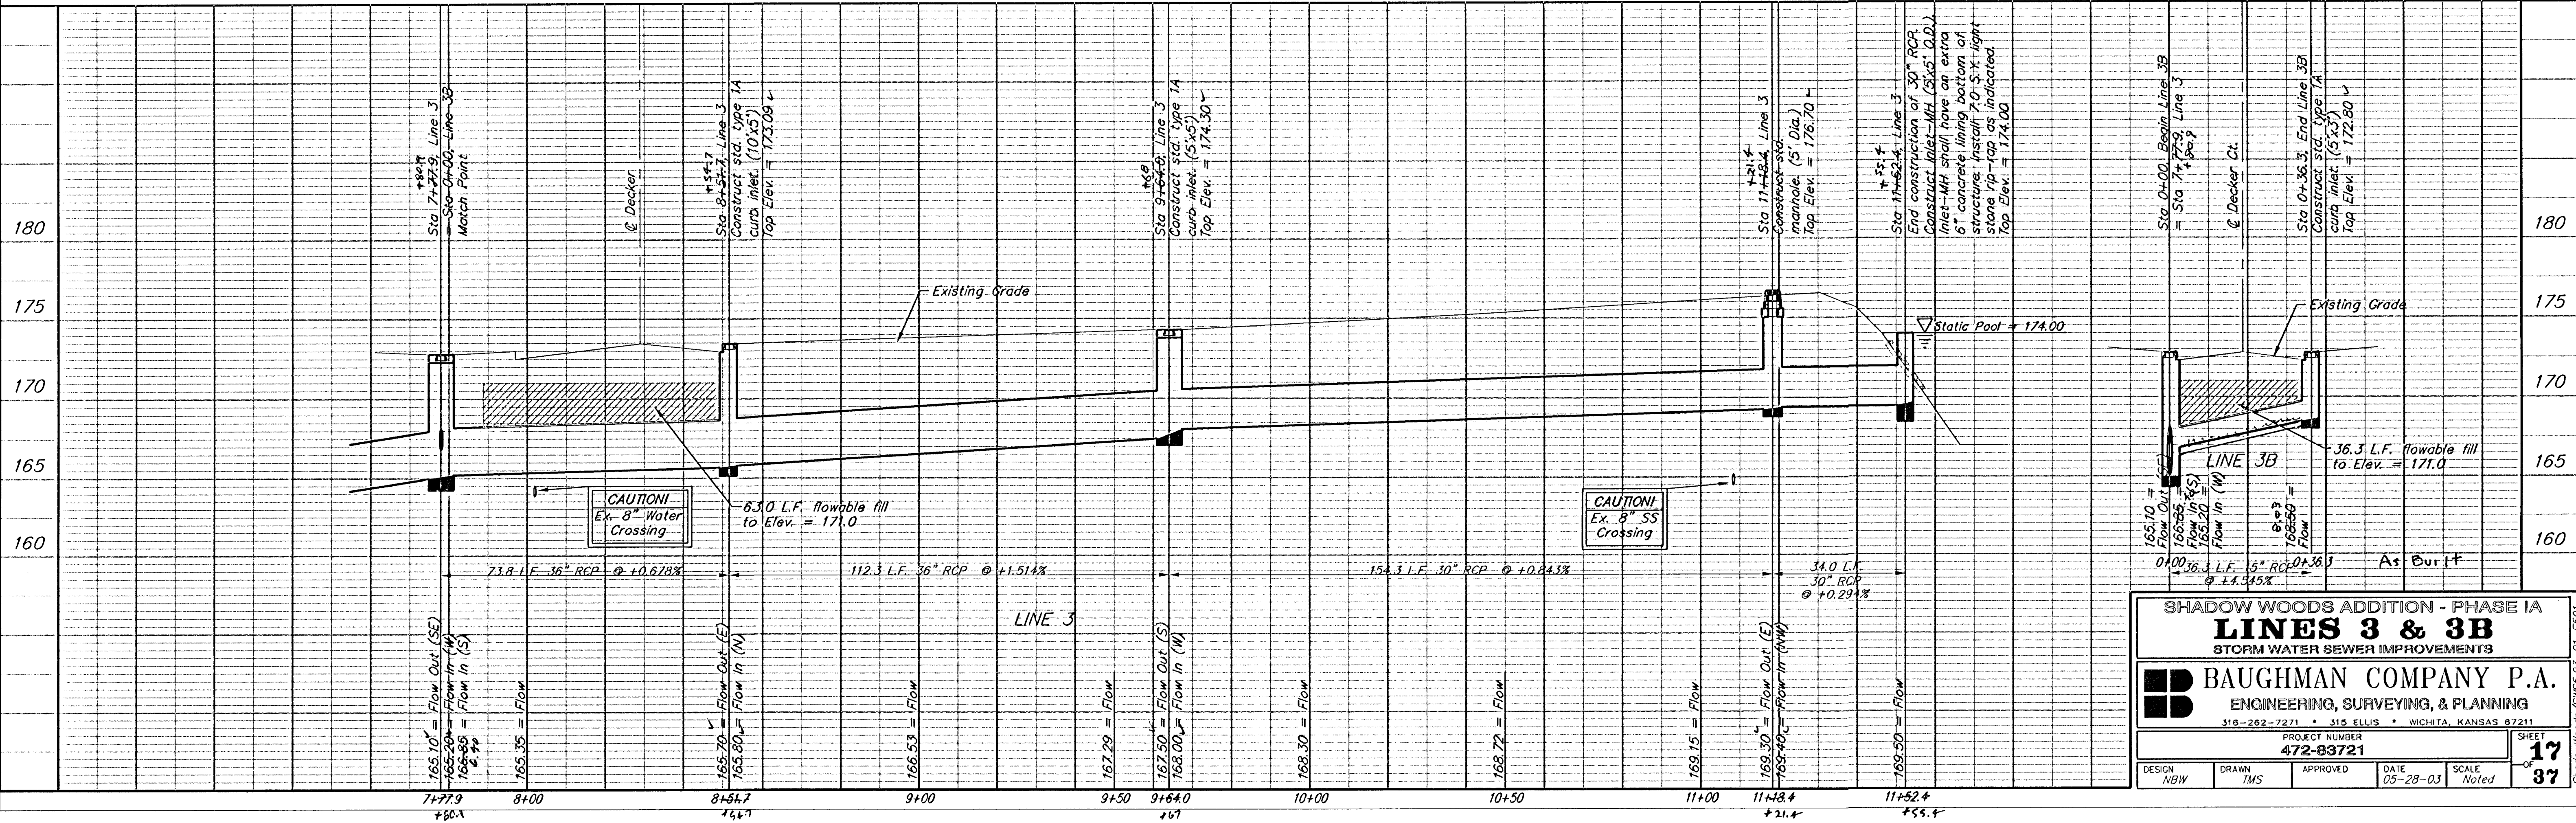


RR Spike in N. Face of PP in N. R/W of Maple N. of Nineiron. Elev. = 177.01 (City Datum)

"□" Cut center of north Headwall of RCBC in N. R/W of Maple 570' East of centerline of City View. Elev. = 187.91 (City Datum)

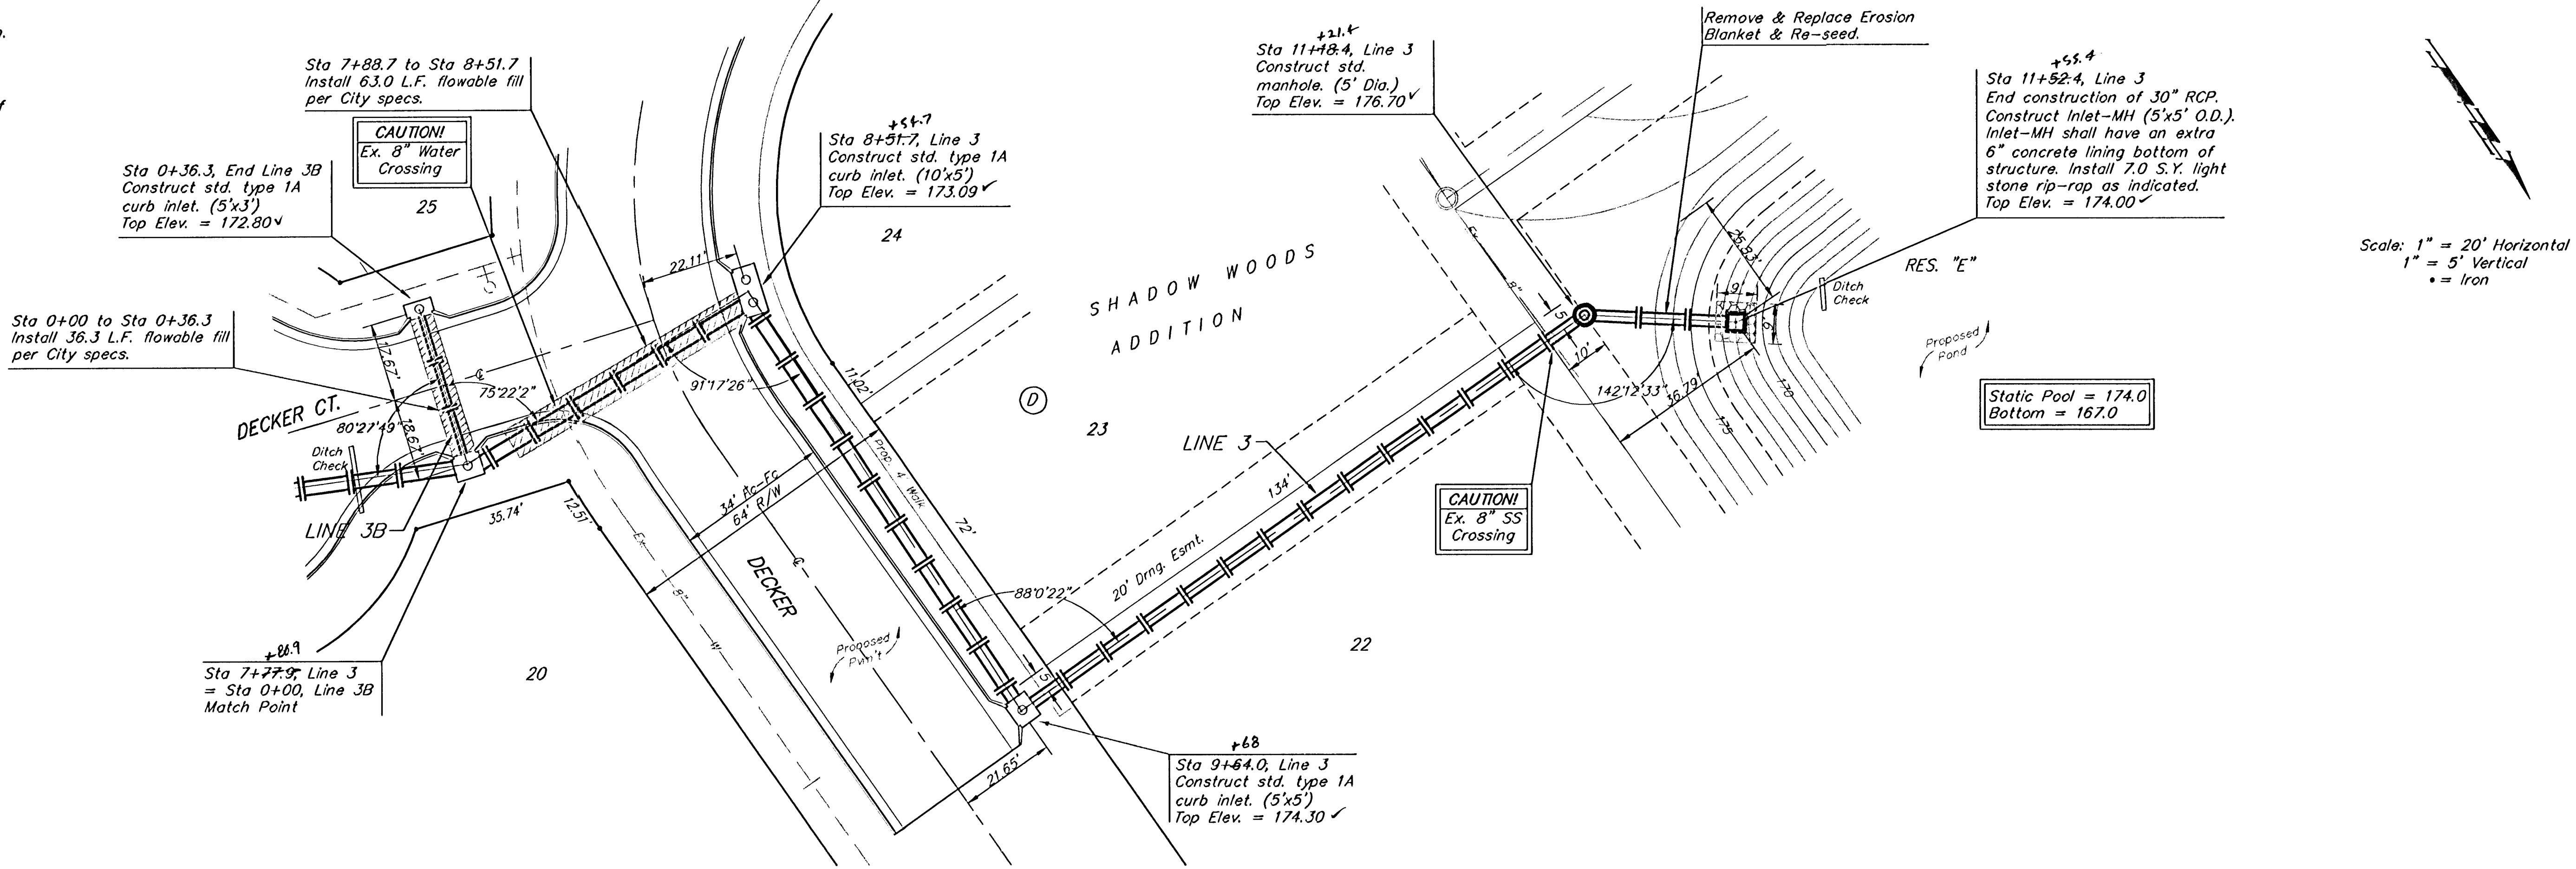

SHADOW WOODS ADDITION - PHASE IA
LINES 3 & 3B
 STORM WATER SEWER IMPROVEMENTS

BAUGHMAN COMPANY P.A.
 ENGINEERING, SURVEYING, & PLANNING
 318-262-7271 • 315 ELLIS • WICHITA, KANSAS 67211

PROJECT NUMBER: 472-83721
 SHEET: 17 OF 37

DESIGN: NGW | DRAWN: TMS | APPROVED: [Signature] | DATE: 05-28-03 | SCALE: Noted