

RR Spike in N. Face of PP in N. R/W of Maple N. of Nineiron. Elev. = 177.01 (City Datum)

"□" Cut center of north Headwall of RCBC in N. R/W of Maple 570' East of centerline of City View. Elev. = 187.91 (City Datum)

Scale: 1" = 20' Horizontal
1" = 5' Vertical
• = Iron

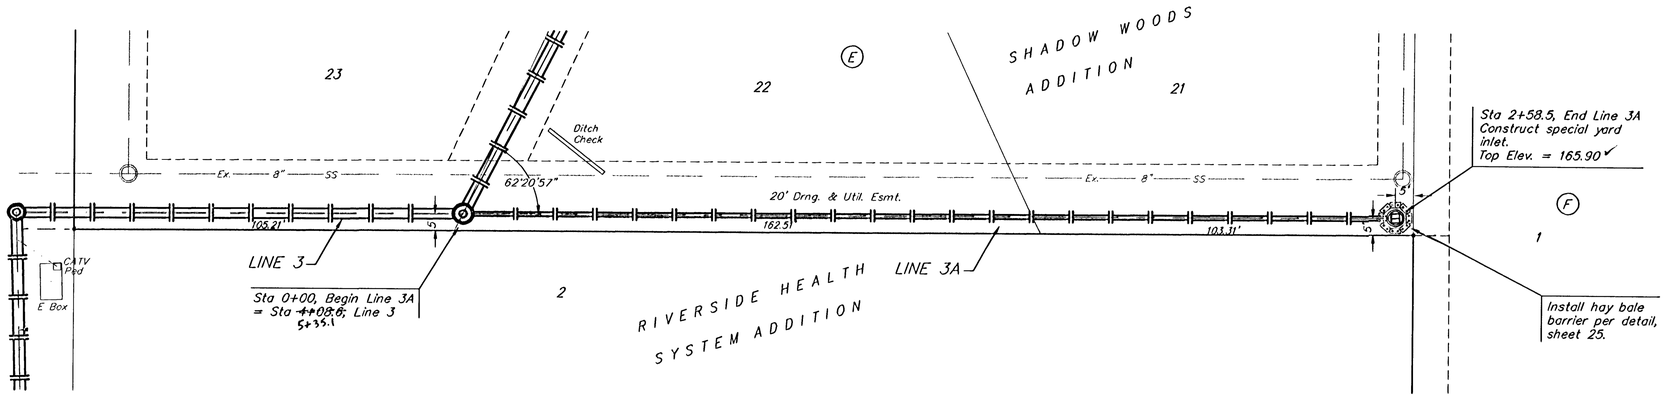

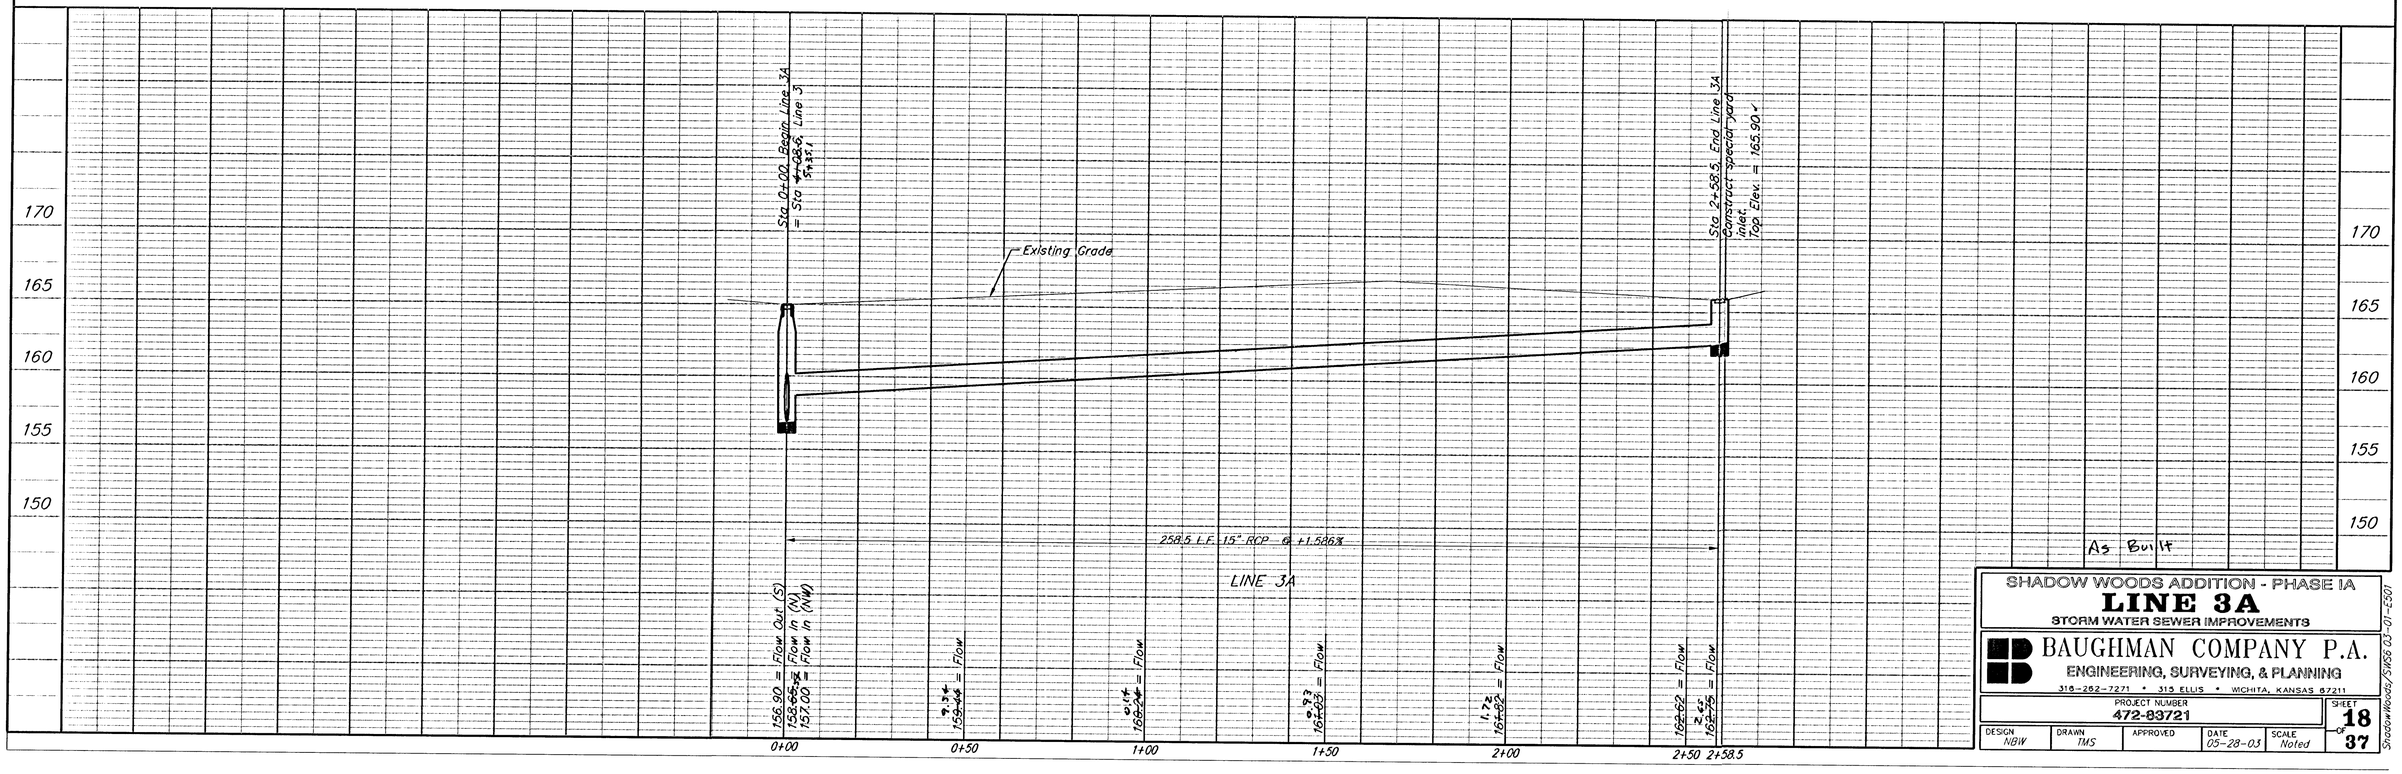

SHADOW WOODS ADDITION - PHASE IA

LINE 3A

STORM WATER SEWER IMPROVEMENTS

BAUGHMAN COMPANY P.A.
ENGINEERING, SURVEYING, & PLANNING
316-262-7271 • 315 ELLIS • WICHITA, KANSAS 67211

PROJECT NUMBER	SHEET
472-83721	18 of 37

DESIGN	DRAWN	APPROVED	DATE	SCALE
NBW	TMS		05-28-03	Noted

ShadowWoods/SWS6 03-01-E501