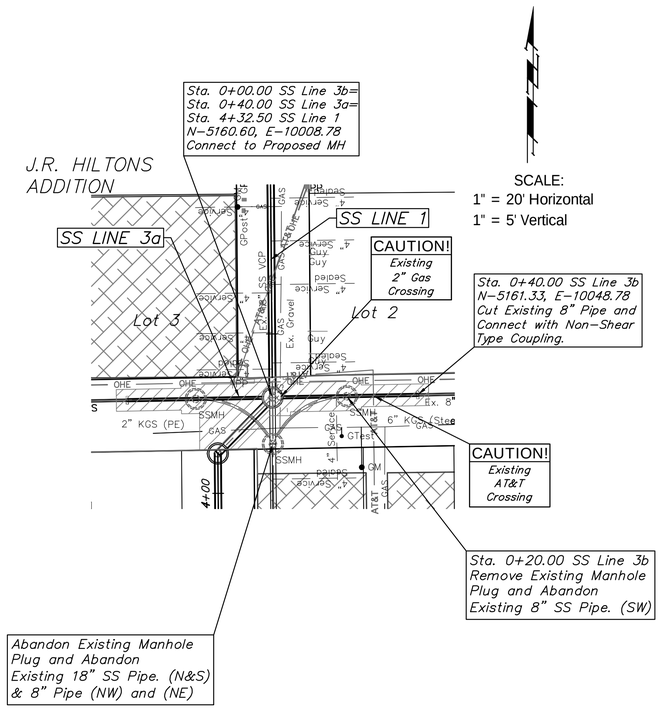

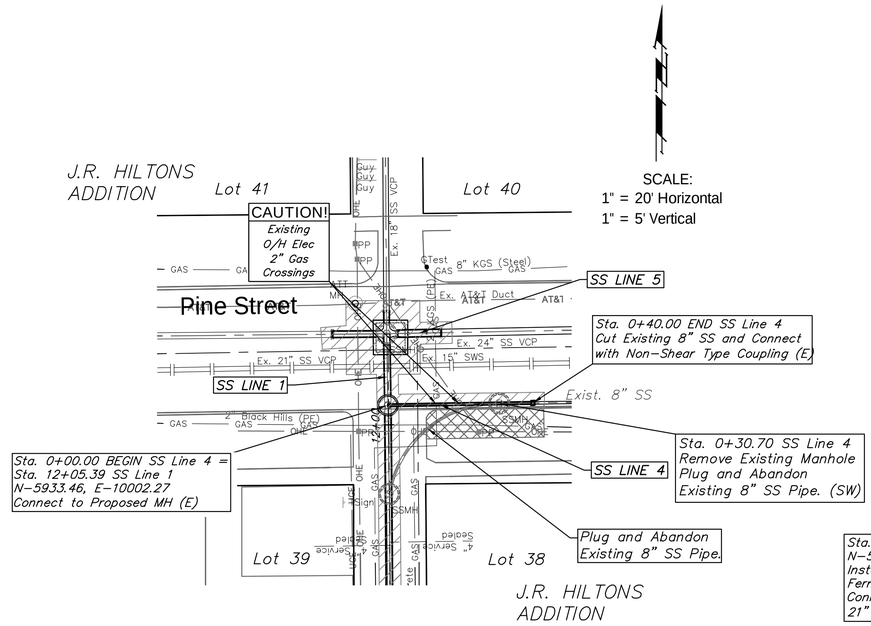

BUILT PER PLAN

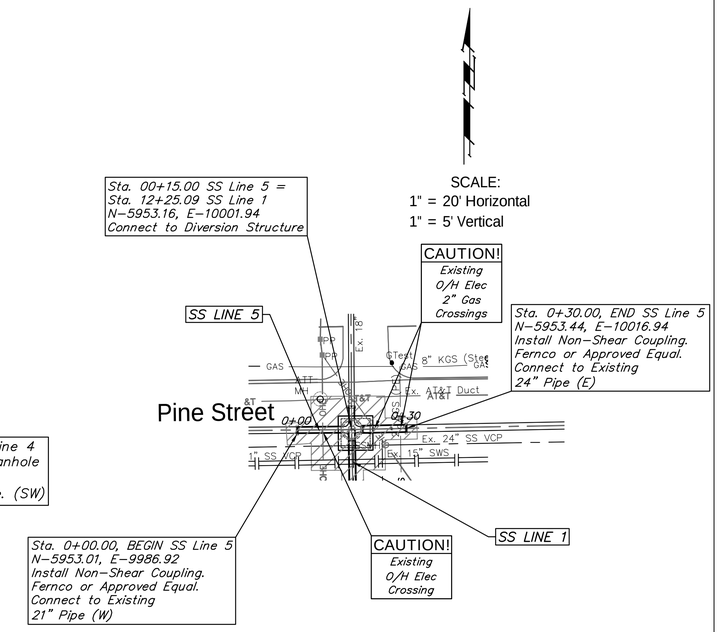

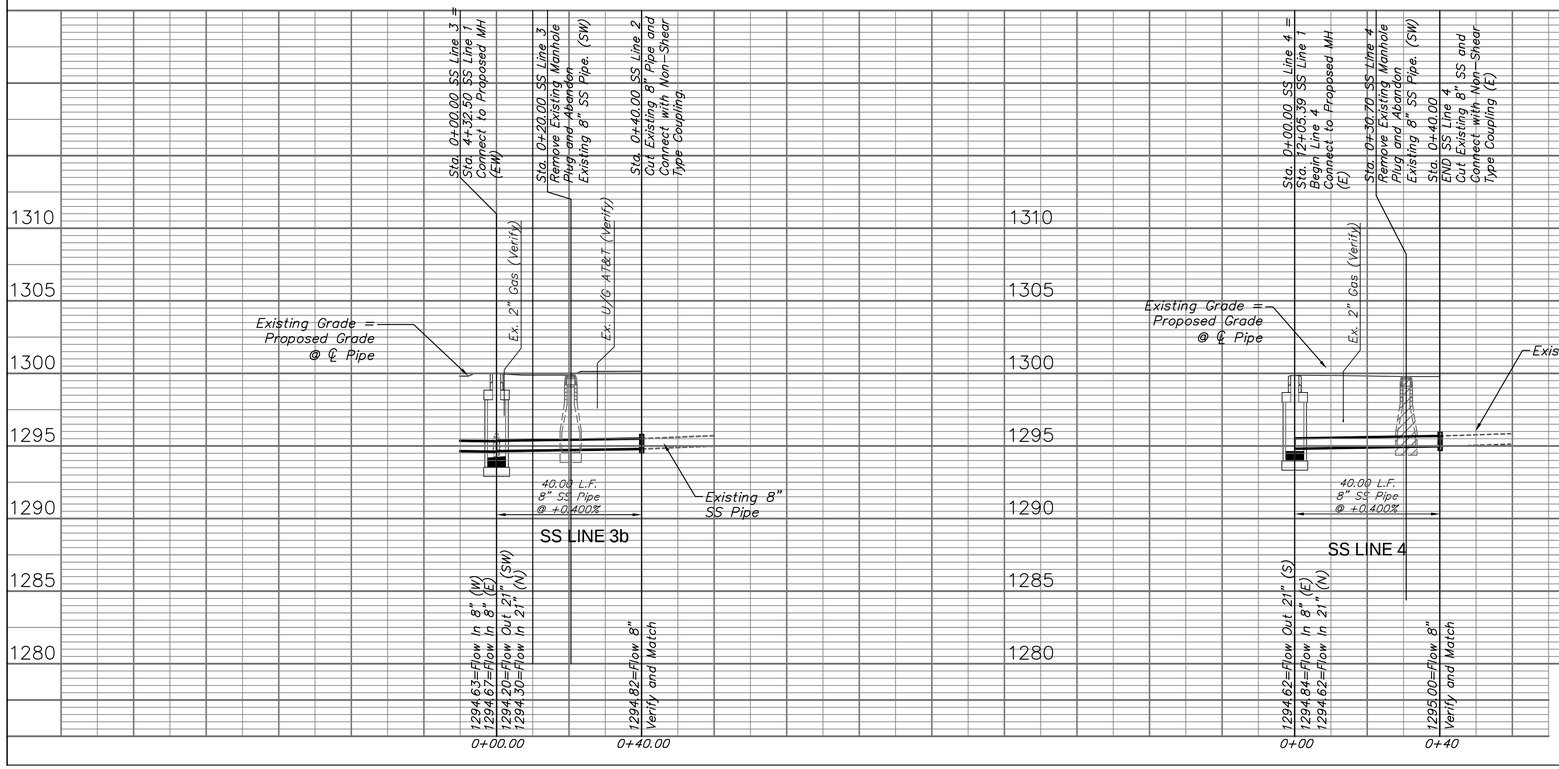

Drawing File: E:\Projects\St. Francis Relief SS\Civil 3d\Emporia St Francis SS Phase 1.dwg {SS01}

Design: KEK
Drawn: JDM
Approved: TPV
Scale: NOTED

Project No. 1309-E969 CAPITAL IMPROVEMENT PROJECT

ST. FRANCIS RELIEF SANITARY SEWER
SS Line 4 & SS Line 5
ST. FRANCIS RELIEF SANITARY SEWER - PHASE 1

Baughman Company , P.A.
315 Ellis St. Wichita, KS 67211 P 316-262-7271 F 316-262-0149
ENGINEERING | SURVEYING | PLANNING | LANDSCAPE ARCHITECTURE

December 2016

SHEET 6 OF 26