

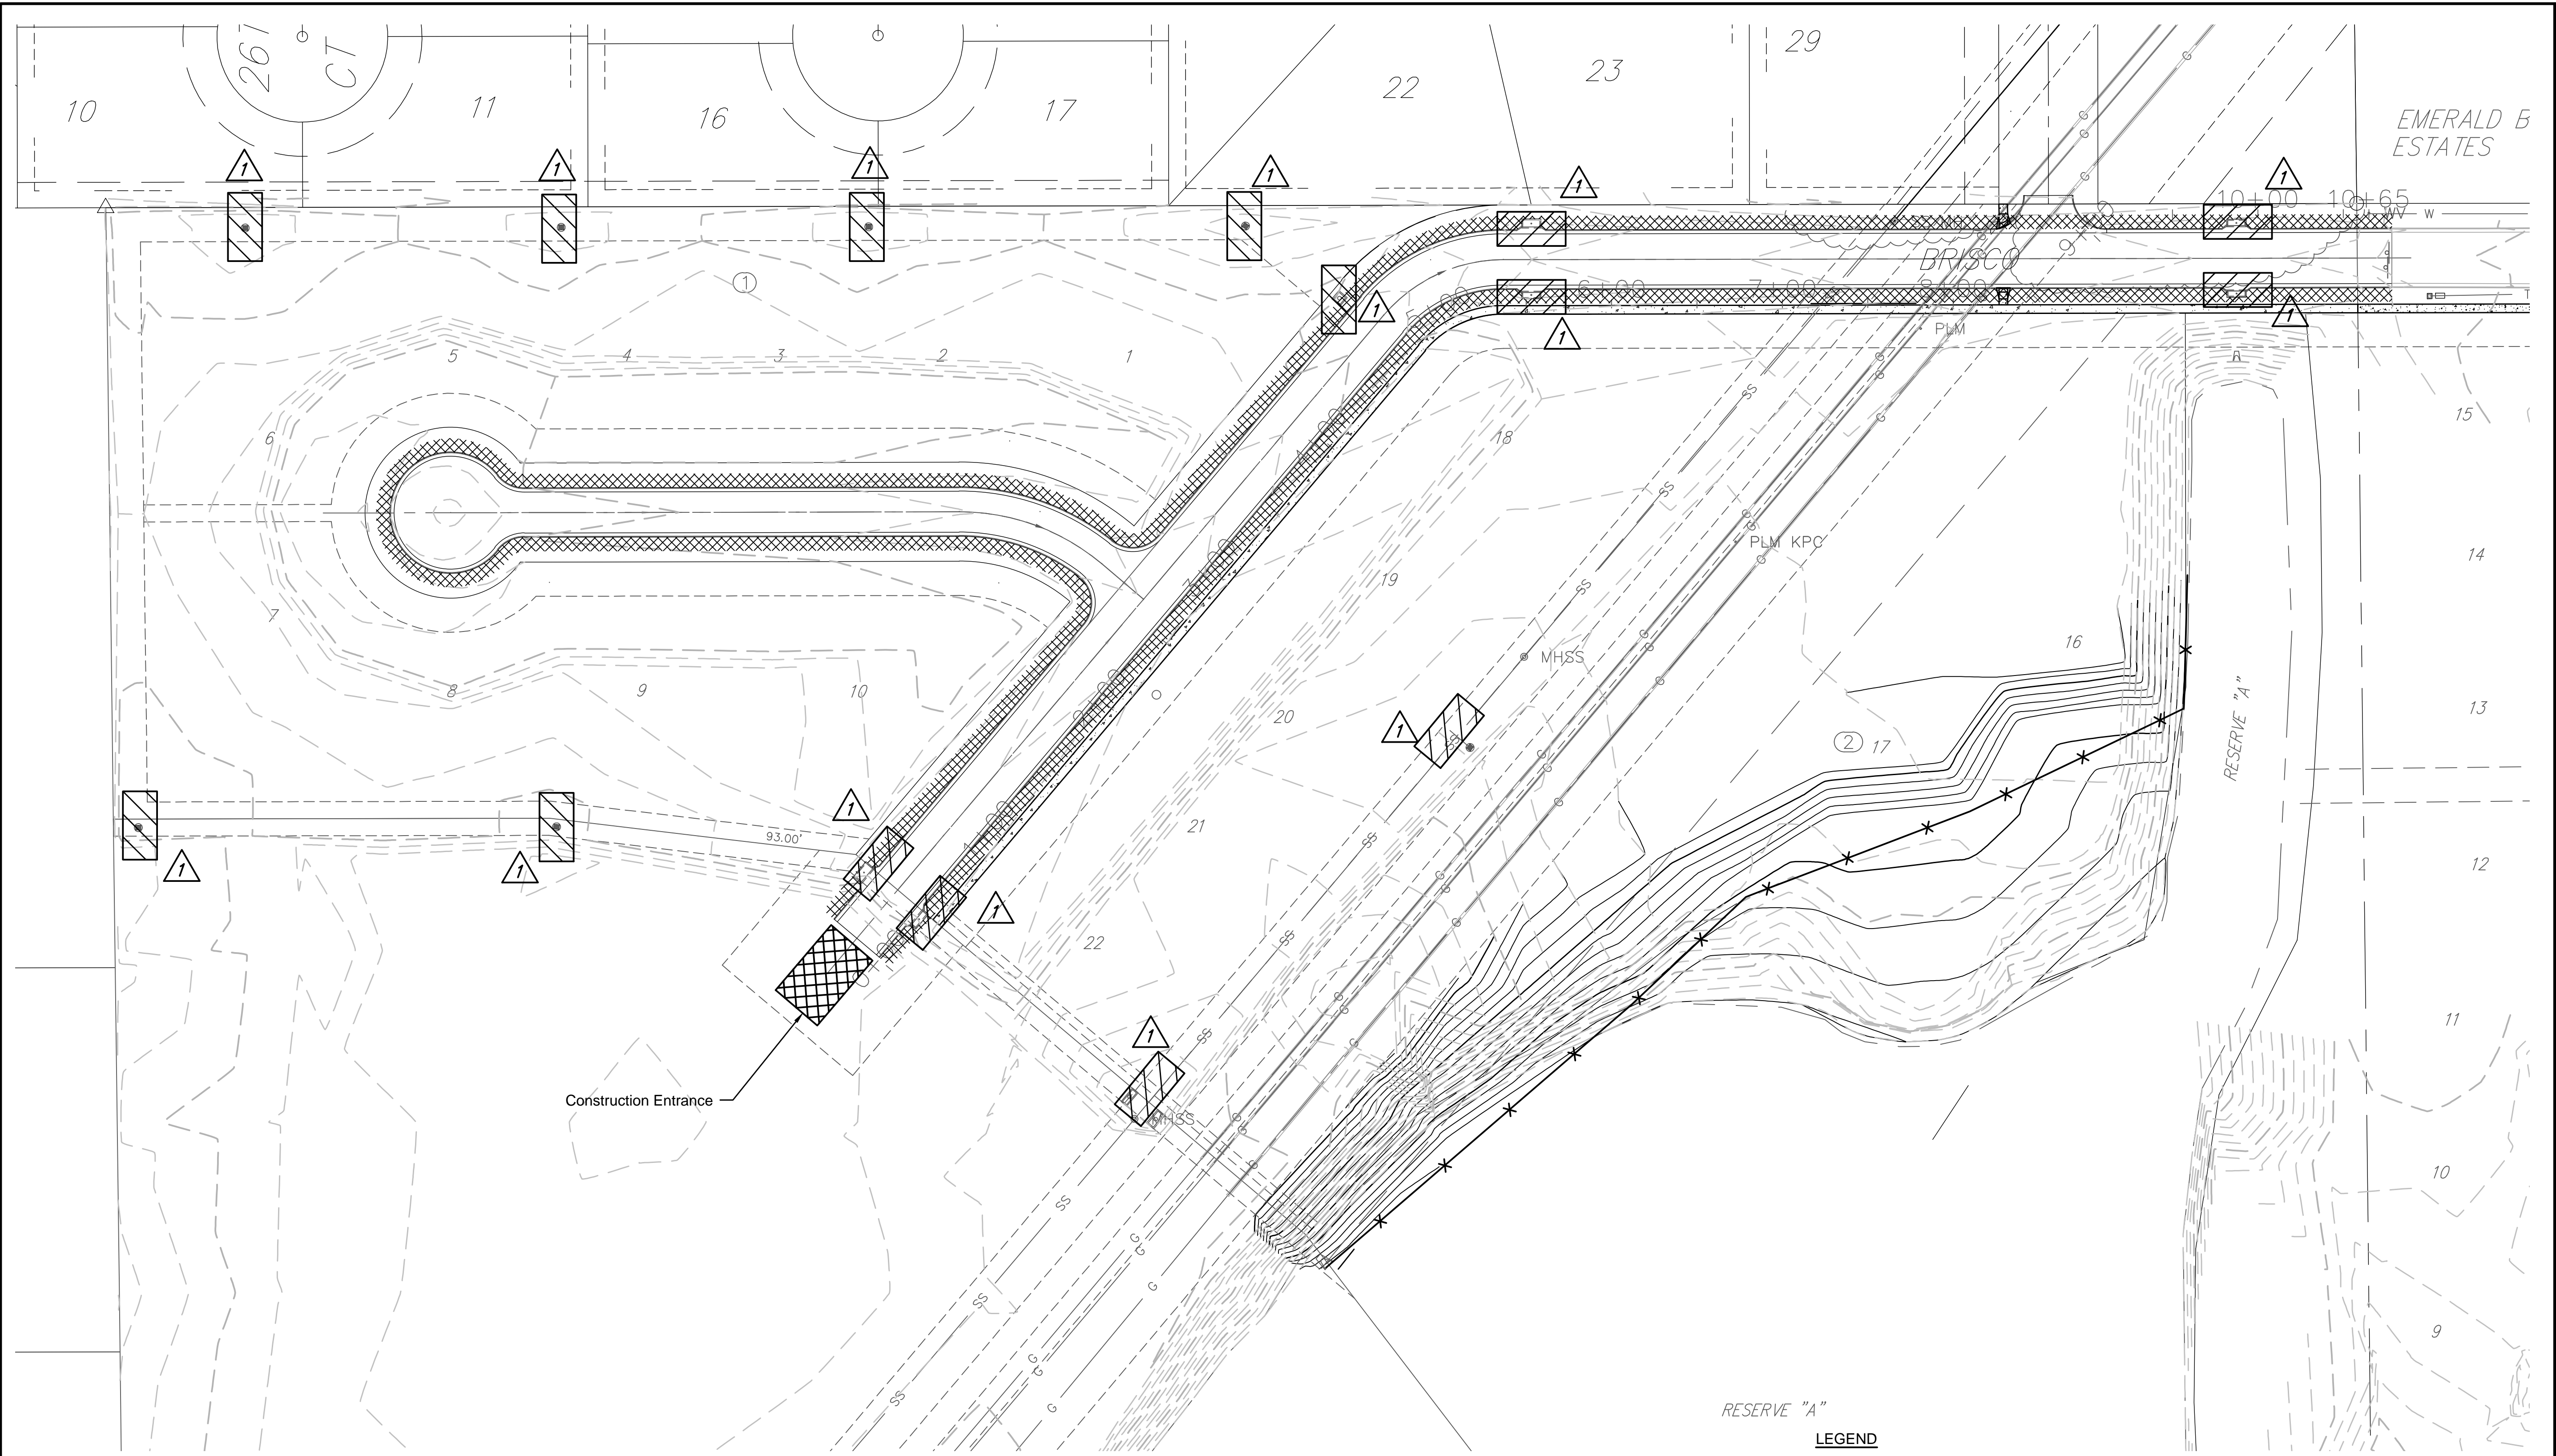
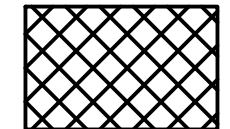
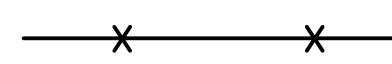



File: L:\2017\17264883 - Emerald Bay 3rd Improvements\Drawings\C3D\SVD\Erosion Control Plan-Paving.dwg Last Save: 7/10/2018 4:08 PM Last saved by: DRStandrich
 Last plotted by: Standrich, Dairy R Plot Style: --- Plot Scale: 1:2,5849 Plot Date: 7/10/2018 4:38 PM Plotter used: None

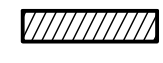


RESERVE "A"
 LEGEND

-  INSTALL CONSTRUCTION ENTRANCE (1 EACH)
-  MAINTAIN SILT FENCE (4350 L.F.)
-  MAINTAIN LINEAR SEDIMENT BARRIER (155 L.F.)
-  MAINTAIN INLET PROTECTION (15 EACH)
-  INSTALL EROSION BLANKET (2,654 SQ. YDS.)

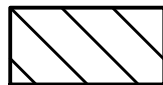

© 2018 GARVER, LLC
 THIS DOCUMENT, ALONG WITH THE IDEAS AND DESIGNS CONVEYED HEREIN, SHALL BE CONSIDERED INSTRUMENTS OF PROFESSIONAL SERVICE AND ARE PROPERTY OF GARVER, LLC. ANY USE, REPRODUCTION, OR DISTRIBUTION OF THIS DOCUMENT, ALONG WITH THE IDEAS AND DESIGN CONTAINED HEREIN, IS PROHIBITED UNLESS AUTHORIZED IN WRITING BY GARVER, LLC OR EXPLICITLY ALLOWED IN THE GOVERNING PROFESSIONAL SERVICES AGREEMENT FOR THIS WORK.

REV.	DATE	DESCRIPTION	BY


 City of Wichita, KS
 Project #: 472-85408
 OCA: 766397
 Emerald Bay 3rd
 Paving Plans

Erosion Control
 Plan-Paving

JOB NO.: 17264883
 DATE: May 2018
 DESIGNED BY: EJJ
 DRAWN BY: DRS

BAR IS ONE INCH ON ORIGINAL DRAWING
 0 1"
 IF NOT ONE INCH ON THIS SHEET, ADJUST SCALES ACCORDINGLY.

DRAWING NUMBER
 SHEET NUMBER **14 OF 21**