PRIVATE STORM WATER SEWER IMPROVEMENTS


TO SERVE

UNIVERSITY PLACE, LOTS 49, 51, and 53
FRIENDS UNIVERSITY PARKING LOT

PRIVATE PROJECT NO. 1672 PPS (607861)

CITY OF WICHITA, KANSAS

JAMES L. ARMOUR, P.E. - CITY ENGINEER

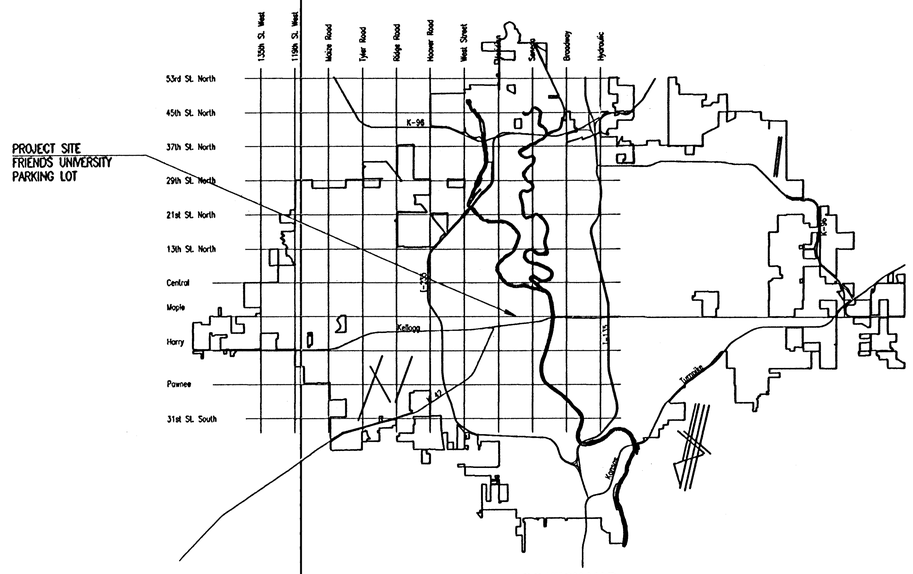

LOCATION MAP

INDEX OF SHEETS

SHEET NO. 1	TITLE SHEET
SHEET NO. 2	KEY MAP AND GENERAL NOTES
SHEET NO. 3	SWS PLAN AND PROFILE
SHEET NO. 4	AREA INLET DETAILS
SHEET NO. 5	TYPE "P" & "C" SHALLOW MANHOLES
SHEET NO. 6	MANHOLE FRAME & COVER
SHEET NO. 7	EROSION CONTROL BMP
SHEET NO. 8	EROSION CONTROL BMP
SHEET NO. 9	EROSION CONTROL BMP
SHEET NO. 10	EROSION CONTROL BMP

1

APPROVED AS NOTED
By CITY ENGINEER OF WICHITA

Storm Sewers JCK 6-22-06

NOTE TO CONTRACTOR

INSPECTION AND TESTING FOR THIS PROJECT IS TO BE PROVIDED BY A LICENSED CONSULTING ENGINEERING FIRM CONTRACTED BY THE OWNER/DEVELOPER. SAID INSPECTION TO BE IN ACCORDANCE WITH THE CITY OF WICHITA STANDARD CONSTRUCTION ENGINEERING PRACTICES AND CERTIFIED BY A LICENSED PROFESSIONAL ENGINEER. NO WORK SHALL BE PERFORMED IN DEDICATED EASEMENTS OR PUBLIC RIGHT-OF-WAY BY THE CONTRACTOR UNTIL SUCH INSPECTION IS ARRANGED FOR AND REQUIRED BONDS HAVE BEEN SUBMITTED TO AND APPROVED BY THE CITY NOR SHALL ANY WORK BE COMMENCED IN DEDICATED EASEMENTS OR PUBLIC RIGHT-OF-WAY WITHOUT WRITTEN AUTHORIZATION BY THE CITY ENGINEER. IMPROVEMENTS PERFORMED UNDER THIS PROJECT SHALL NOT BE ACCEPTED BY THE CITY UNTIL ALL APPLICABLE DOCUMENTATION HAS BEEN SUBMITTED TO THE CITY ENGINEER. THIS MAY INCLUDE: RECORD DRAWINGS, INSPECTION LOGS, TEST DOCUMENTATION, TV TAPES, AND A CERTIFICATE OF COMPLETION. THE ABOVE SHALL BE PERFORMED BY THE CONSULTING FIRM CONTRACTED TO INSPECT THIS PROJECT.

AS-BUILT
8/1/06
Date K.E. Miller
Engr

1 06/22/06 Revised for PW Signature

DAVID W. HERRMAN LICENSED 16758 06-22-06 KANSAS PROFESSIONAL ENGINEER

MAY 2006

PLANS PREPARED BY

PROFESSIONAL ENGINEERING CONSULTANTS, P.A.

ENGINEERS

WICHITA, KANSAS

Saved 06-22-2006 15:42:4 PM by KEE
Plotted 11 Jul 2006 2:24:54 PM by KEE
Q:\2006\1619\003\06193-003-04a 1-SWS-Title-Rev-1-06-22-06