

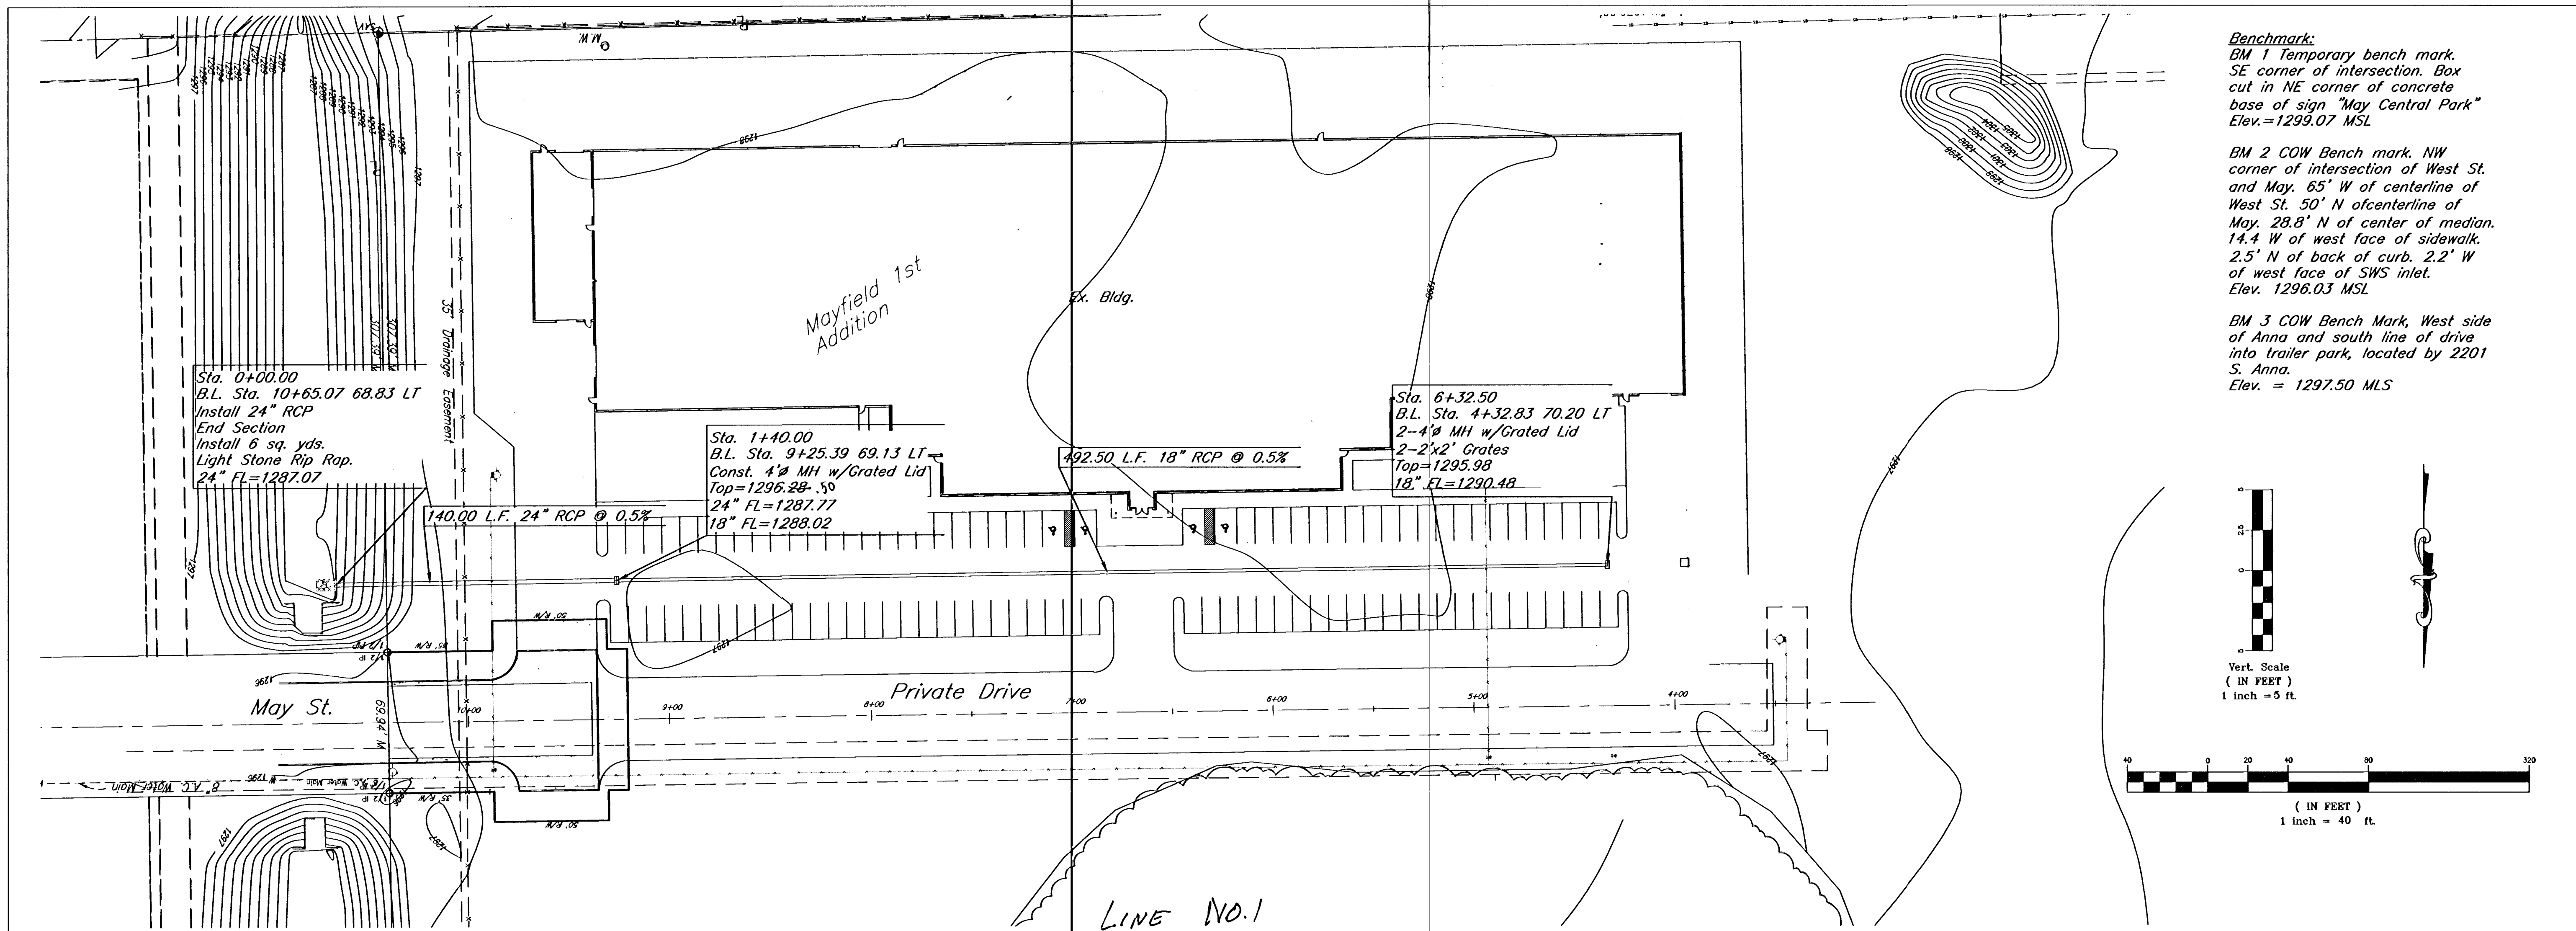


2411701
LW2

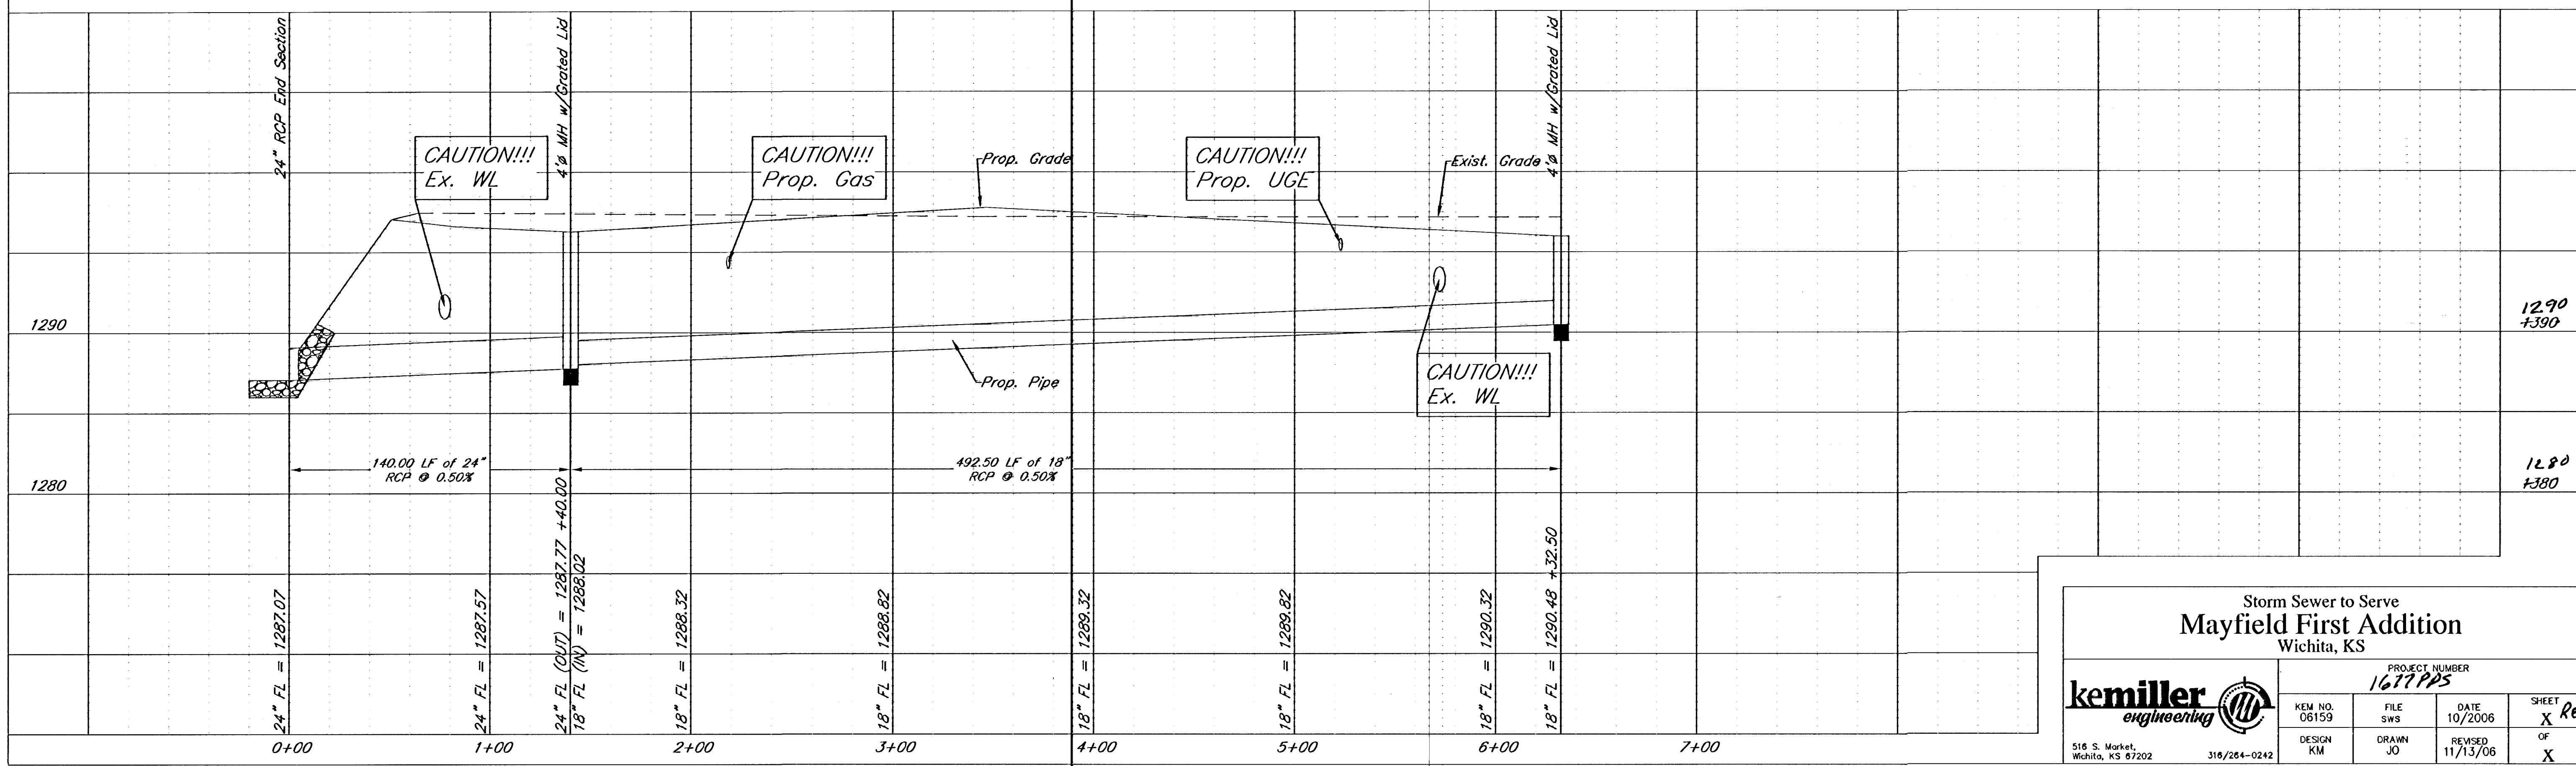

Benchmark:
 BM 1 Temporary bench mark. SE corner of intersection. Box cut in NE corner of concrete base of sign "May Central Park" Elev. = 1299.07 MSL
 BM 2 COW Bench mark. NW corner of intersection of West St. and May. 65' W of centerline of West St. 50' N of centerline of May. 28.8' N of center of median. 14.4' W of west face of sidewalk. 2.5' N of back of curb. 2.2' W of west face of SWS inlet. Elev. 1296.03 MSL
 BM 3 COW Bench Mark, West side of Anna and south line of drive into trailer park, located by 2201 S. Anna. Elev. = 1297.50 MSL

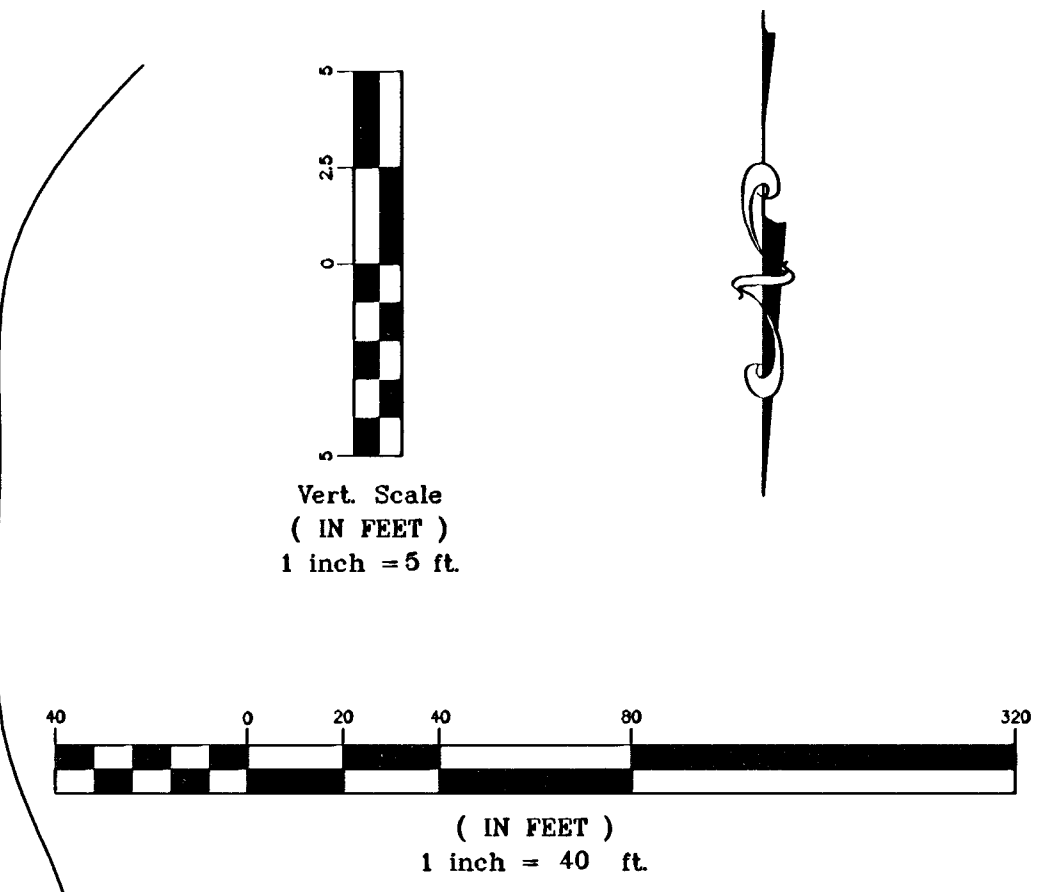

Storm Sewer to Serve
Mayfield First Addition
 Wichita, KS

kemiller engineering		PROJECT NUMBER 1677PPS	
		KEM NO. 06159	DATE 10/2006
DESIGN KM	DRAWN JO	REVISED 11/13/06	SHEET X

516 S. Market, Wichita, KS 67202 316/264-0242

Revised sheet
2
of 8