


**PLAN LINE 1**

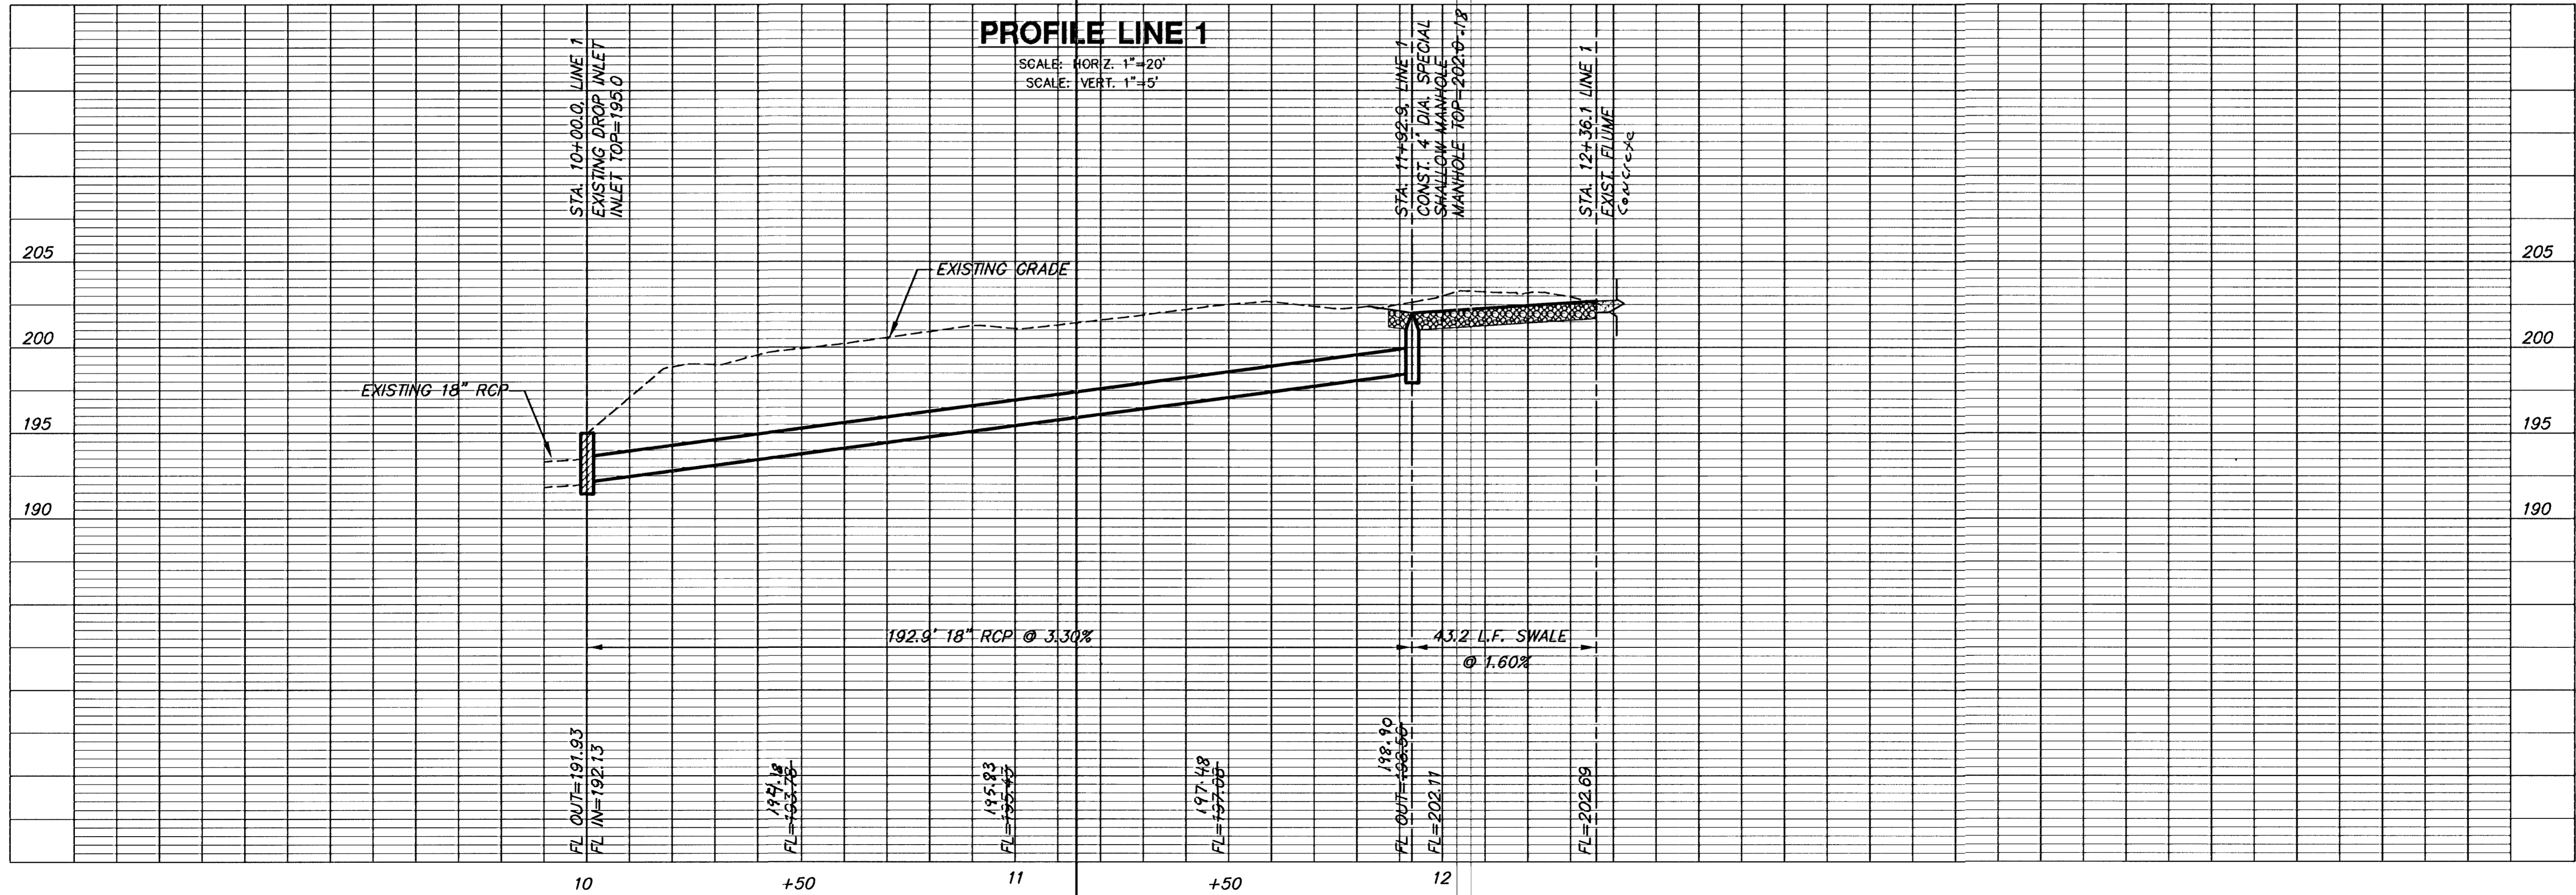

PRIVATE STORM WATER PLANS  
**PRAIRIE VIEW**  
PHASE 1

**LINE 1**  
SHEET TITLE  
PROJECT NUMBER  
1650 PPS

DESIGN BY  
DFL  
DRAWN BY  
MKEC  
CHECKED BY  
GJA

ISSUED  
APRIL 2006  
REVISED

SHEET NO.  
3 of 5

PLOTTED: Monday, April 24, 2006 @ 02:02PM