1675 PPS

PRIVATE SANITARY AND STORM SEWER IMPROVEMENTS

TO SERVE

CHEDDAR'S RESTAURANT SITE

LOT 10 and 11, BLOCK 1, THE GATEWAY CENTER 2ND ADDITION

PRIVATE PROJECT NO. 1675 PPS (607861)

CITY OF WICHITA, KANSAS

JAMES L. ARMOUR, P.E. - CITY ENGINEER

Sanitary Sewer
McCullough Excavation, Inc. - Contractor
Gann, KE Miller - Inspector
Released 9/25/06
As-Built
.pdf by JDL 9/25/06

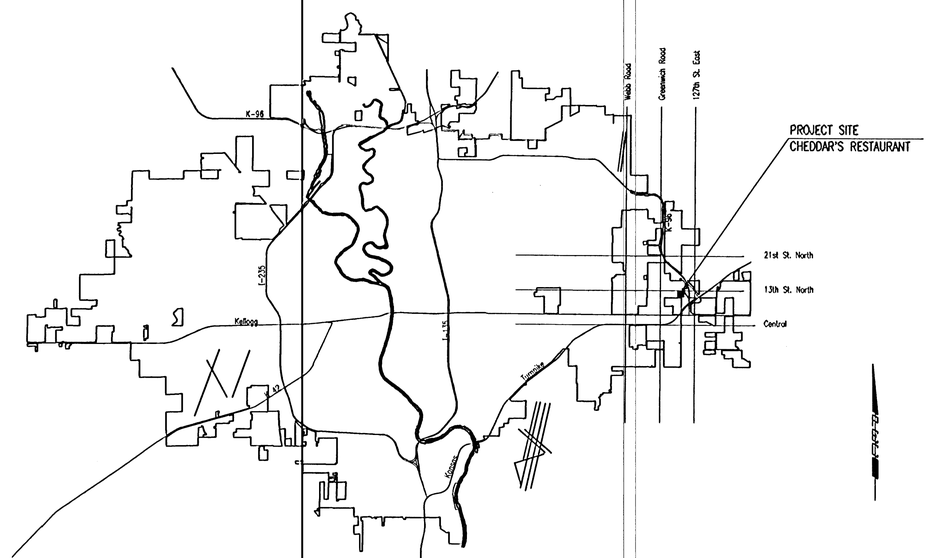

LOCATION MAP

INDEX OF SHEETS

SHEET NO. C4.1	TITLE SHEET
SHEET NO. C4.2	KEY MAP AND GENERAL NOTES
SHEET NO. C4.3	S.S. PLAN/PROFILE
SHEET NO. C4.4	SWS PLAN/PROFILE
SHEET NO. C4.5	STANDARD TYPE 'P' MANHOLE DETAILS
SHEET NO. C4.6	FRAME & COVER DETAILS
SHEET NO. C4.7	TYPE 1 CURB INLET DETAILS
SHEET NO. C4.8	MANHOLE ADJUSTMENT DETAILS
SHEET NO. C5.2-C5.5	SOIL EROSION BMP DETAILS
SHEET NO. 6.1	PLAT

AS-BUILT
9/19/06
KE Miller

APPROVED AS NOTED
By CITY ENGINEER OF WICHITA

Sanitary Sewers 6/28/06

Storm Sewers 6-22-06

Driveway Approaches

Paving

DAVID W. HERBERGER
LICENSED
16758
06-19-06
KANSAS
PROFESSIONAL ENGINEER

NOTE TO CONTRACTOR

INSPECTION AND TESTING FOR THIS PROJECT IS TO BE PROVIDED BY A LICENSED CONSULTING ENGINEERING FIRM CONTRACTED BY THE OWNER/DEVELOPER. SAID INSPECTION TO BE IN ACCORDANCE WITH THE CITY OF WICHITA STANDARD CONSTRUCTION ENGINEERING PRACTICES AND CERTIFIED BY A LICENSED PROFESSIONAL ENGINEER. NO WORK SHALL BE PERFORMED IN DEDICATED EASEMENTS OR PUBLIC RIGHT-OF-WAY BY THE CONTRACTOR UNTIL SUCH INSPECTION IS ARRANGED FOR AND REQUIRED BONDS HAVE BEEN SUBMITTED TO AND APPROVED BY THE CITY NOR SHALL ANY WORK BE COMMENCED IN DEDICATED EASEMENTS OR PUBLIC RIGHT-OF-WAY WITHOUT WRITTEN AUTHORIZATION BY THE CITY ENGINEER. IMPROVEMENTS PERFORMED UNDER THIS PROJECT SHALL NOT BE ACCEPTED BY THE CITY UNTIL ALL APPLICABLE DOCUMENTATION HAS BEEN SUBMITTED TO THE CITY ENGINEER. THIS MAY INCLUDE: RECORD DRAWINGS, INSPECTION LOGS, TEST DOCUMENTATION, TV TAPES, AND A CERTIFICATE OF COMPLETION. THE ABOVE SHALL BE PERFORMED BY THE CONSULTING FIRM CONTRACTED TO INSPECT THIS PROJECT.

JUNE 2006

PLANS PREPARED BY

PROFESSIONAL ENGINEERING CONSULTANTS, P.A.

ENGINEERS

WICHITA, KANSAS