



Irons			
Point #	Northing	Easting	Description
1	10,286.11	7,366.83	SI/4
2	10,287.77	10,011.21	SI/4
3	7,621.31	10,024.71	Iron
4	4,984.65	10,034.16	SI/4
5	8,954.54	10,017.96	Iron
6	8,971.98	8,828.86	Iron
9	8,777.93	8,895.85	Iron
10	8,093.96	8,899.31	Iron
11	7,974.25	8,954.50	Iron
12	7,801.33	8,954.50	Iron
13	7,720.59	8,954.50	Iron
15	7,223.15	8,915.78	Iron
16	4,969.33	7,411.52	SI/4
17	7,626.78	7,391.60	STONE
18	8,956.75	7,379.06	3/4IP
19	8,973.26	7,378.72	1-1/4IP
20	7,111.00	8,960.57	Iron
21	7,075.46	8,910.30	Iron
22	7,163.26	8,810.20	Iron
23	7,124.84	8,736.50	Iron
24	6,524.47	8,741.00	Iron
25	6,460.47	8,741.48	Iron
26	6,459.17	8,567.31	Iron
27	6,523.16	8,566.83	Iron
28	6,558.73	8,530.74	Iron
29	6,558.25	8,466.74	Iron
30	6,662.41	8,465.96	Iron
31	6,686.79	8,465.70	Iron
32	6,775.65	8,445.37	Iron
33	6,998.41	7,396.31	Iron
34	6,657.56	7,817.88	Iron
35	7,001.55	7,815.30	Iron
36	7,399.41	7,393.31	Iron
37	8,841.68	7,380.29	Iron
39	7,463.41	7,392.83	Iron
40	8,777.68	7,380.88	Iron
41	8,841.98	8,829.52	Iron
42	8,777.98	8,829.47	Iron
43	6,836.59	8,485.12	Iron
44	6,934.41	8,463.92	Iron
45	6,931.08	8,018.84	Iron
46	7,142.59	7,954.25	Iron
47	7,143.07	8,018.25	Iron
48	7,143.68	8,098.92	Iron
49	7,207.67	8,098.44	Iron
50	7,205.00	7,741.78	Iron
51	7,272.49	7,673.27	Iron
52	7,401.02	7,608.30	Iron
53	7,465.02	7,607.82	Iron
54	7,870.51	7,688.60	Iron
55	7,886.42	7,677.65	Iron
56	7,926.01	7,607.14	Iron
57	8,841.15	8,026.12	Iron
58	7,926.31	7,665.14	Iron
59	7,879.98	7,736.72	Iron
60	8,807.34	8,108.23	Iron
61	7,815.98	7,737.20	Iron
62	7,817.37	7,922.60	Iron
63	8,696.59	8,295.49	Iron
64	8,737.39	8,254.27	Iron
65	7,881.37	7,922.12	Iron
66	7,939.44	8,004.02	Iron
67	7,896.73	8,051.68	Iron
68	8,413.60	7,604.67	Iron
69	8,413.89	7,662.67	Iron
70	8,550.56	8,276.65	Iron
71	8,010.08	8,021.09	Iron
72	8,505.84	8,277.29	Iron
73	8,453.50	8,266.48	Iron
74	8,060.38	7,998.47	Iron
75	8,482.60	8,330.43	Iron
76	7,702.87	8,268.02	Iron
77	7,664.17	8,311.22	Iron
78	7,480.11	8,022.65	Iron
79	7,538.11	8,022.21	Iron

Irons			
Point #	Northing	Easting	Description
80	7,551.41	8,437.05	Iron
81	8,510.86	8,586.48	Iron
82	8,470.39	8,599.40	Iron
83	8,470.68	8,657.40	Iron
84	8,544.21	8,633.93	Iron
85	8,258.00	8,267.47	Iron
86	8,645.51	8,595.51	Iron
87	8,645.84	8,659.51	Iron
88	8,709.40	8,595.19	Iron
89	8,709.72	8,659.19	Iron
90	8,842.07	8,727.30	Iron
91	8,778.07	8,727.24	Iron
92	8,234.27	8,600.59	Iron
93	8,234.56	8,658.59	Iron
94	8,258.29	8,325.47	Iron
95	8,453.80	8,324.48	Iron
96	8,667.76	7,970.05	Iron
97	8,514.76	8,344.49	Iron
98	8,574.23	7,931.86	Iron
99	8,512.37	8,370.18	Iron
100	8,513.17	8,528.18	Iron
101	8,523.14	8,577.85	Iron
102	8,060.06	7,934.47	Iron
103	8,556.50	8,625.30	Iron
104	8,577.17	8,527.86	Iron
105	7,962.42	7,978.38	Iron
106	8,576.37	8,369.86	Iron
107	8,596.04	8,321.68	Iron
108	7,861.28	8,019.92	Iron
109	7,903.99	7,972.25	Iron
110	8,658.90	8,258.18	Iron
111	8,699.70	8,216.96	Iron
112	8,574.55	7,995.86	Iron
113	8,622.76	8,015.56	Iron
114	7,853.54	7,629.87	Iron
115	8,777.15	8,026.07	Iron
116	8,761.86	8,063.20	Iron
117	8,716.83	8,108.69	Iron
118	8,767.68	8,274.25	Iron
119	8,757.47	8,332.15	Iron
120	7,747.00	7,605.71	Iron
121	7,747.48	7,669.71	Iron
124	7,272.01	7,608.27	Iron
127	7,141.00	7,742.25	Iron
132	6,930.60	7,955.84	Iron
134	6,863.59	8,088.34	Iron
135	6,799.59	8,088.82	Iron
137	6,697.27	8,529.70	Iron
138	6,806.17	8,501.62	Iron
140	6,801.90	8,396.91	Iron
143	6,865.90	8,396.43	Iron
145	6,934.88	8,527.92	Iron
146	7,501.28	8,459.67	Iron
147	7,501.76	8,523.67	Iron
148	7,599.07	8,479.76	Iron
152	7,523.52	8,185.19	Iron
153	7,562.23	8,141.99	Iron
154	7,538.61	8,089.65	Iron
155	7,480.61	8,090.08	Iron
203	4,983.72	7,432.93	N
204	7,937.65	9,446.21	N
205	8,316.30	8,730.67	R
206	7,605.06	7,715.03	R
207	8,970.15	7,446.21	N
220	7,607.02	8,954.50	Iron
244	7,379.32	8,954.50	Iron
245	7,399.53	8,954.50	Iron

SWS Points			
Point #	Northing	Easting	Description
7001	6,326.14	7,843.15	End Sec
7002	6,466.43	7,824.65	CL 1/S FC
7003	6,504.77	7,824.37	CL 1/S FC
7004	6,662.59	7,822.84	MH
7005	7,006.58	7,820.26	MH
7006	7,004.19	7,501.27	INLET
7007	7,451.37	7,497.92	CL 1/S FC
7008	7,539.19	7,497.26	INLET
7009	7,476.12	7,620.57	CL 1/S FC
7010	7,514.39	7,658.62	CL 1/S FC
7011	6,663.91	7,999.04	MH
7012	6,664.19	8,035.93	END
7013	6,818.12	8,052.46	CL 1/S FC
7014	6,854.85	8,063.84	CL 1/S FC
7015	7,010.28	8,313.93	BEGIN
7016	7,008.72	8,104.93	INLET
7017	7,413.03	7,498.21	CL 1/S FC

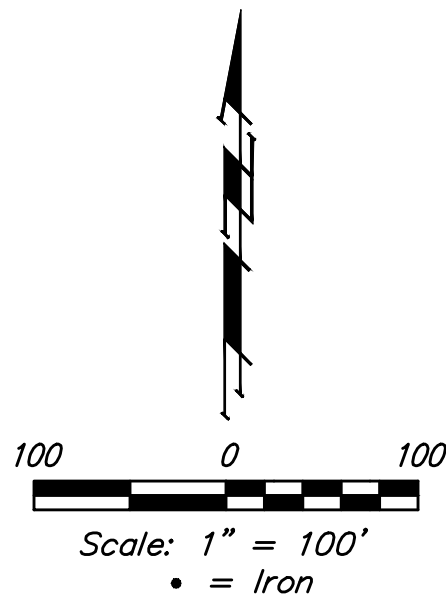

BENCHMARKS:
BM #1: "□" Top of Curb NE of the most easterly corner of Lot 28, Block E, Falcon Falls 2nd Addition
Elev. = 1361.23 (NGVD29)
BM #2: "□" Top of Curb North of the NE corner of Lot 2, Block D, Falcon Falls 3rd Addition
Elev. = 1351.76 (NGVD29)



Falcon Falls 2nd Addition - Phase 4A

COORDINATES

Storm Water Sewer Improvements #731

Baughman Company, P.A. 315 Ellis St. Wichita, KS 67211 P 316-262-7271 F 316-262-0149
ENGINEERING | SURVEYING | PLANNING | LANDSCAPE ARCHITECTURE

PROJECT NUMBER
468-85340

DESIGN
DMV

DRAWN
JAK

APPROVED
DATE
8/30/18

SCALE
Noted

SHEET
22 OF 24

REVISIONS:

C:\Projects\Falcon Falls 2nd\Phase 4A\SWS 1805-E010\SWS PLANS.DWG