





**BENCHMARKS:**

BM #6 - City of Wichita Benchmark Disc on the Northwest Corner of the Traffic Signal Base at the Southwest Corner of Douglas and Hydraulic.  
Elev. = 1296.82 (NAVD 88)

BM #7 - Chiseled "C" 4' South of the Northwest Curb Return at the Intersection Douglas and Kansas, 41.2' North & 16.2' East of the Centerline of Both.  
Elev. 1297.67 (NAVD 88)

FHWA REGION NO.	STATE	PROJECT NO.	FISCAL YEAR	SHEET NO.	TOTAL SHEETS
7	KANSAS	U-0639-01	2017	19	58

HSIP-N063(801)

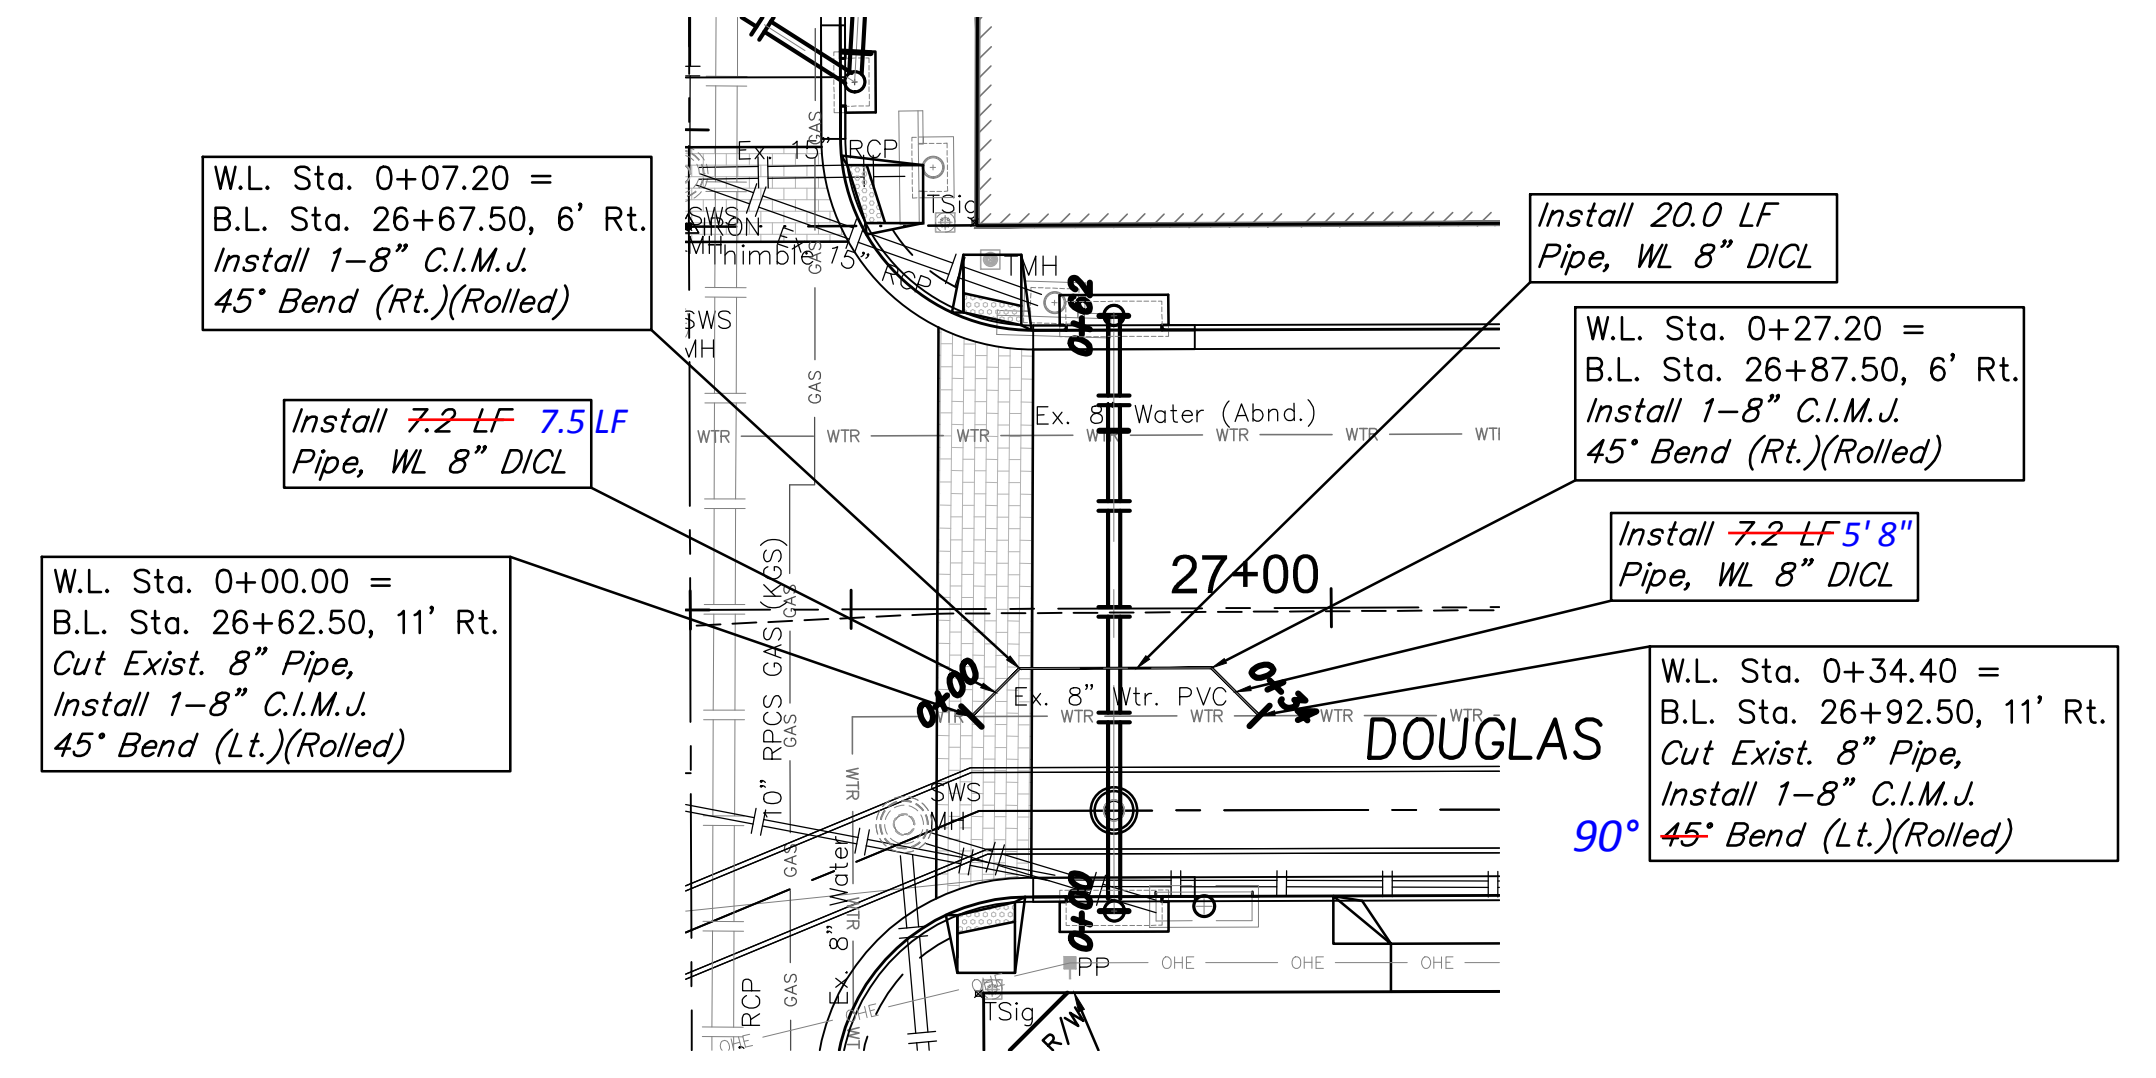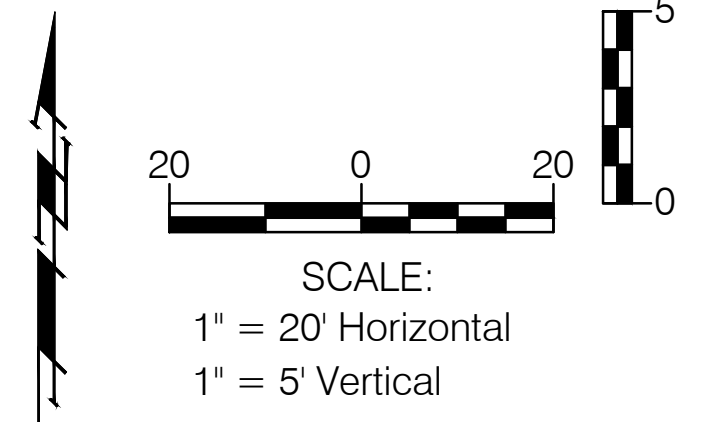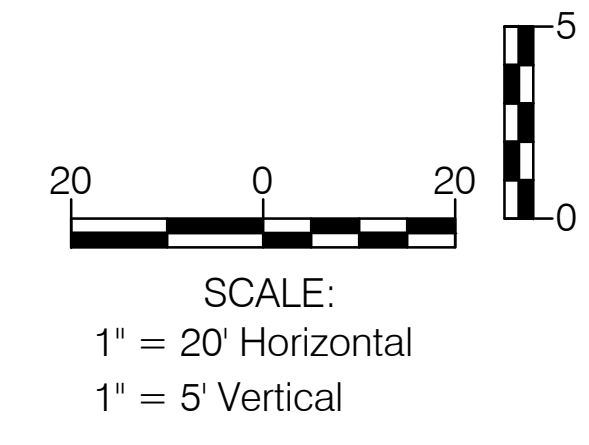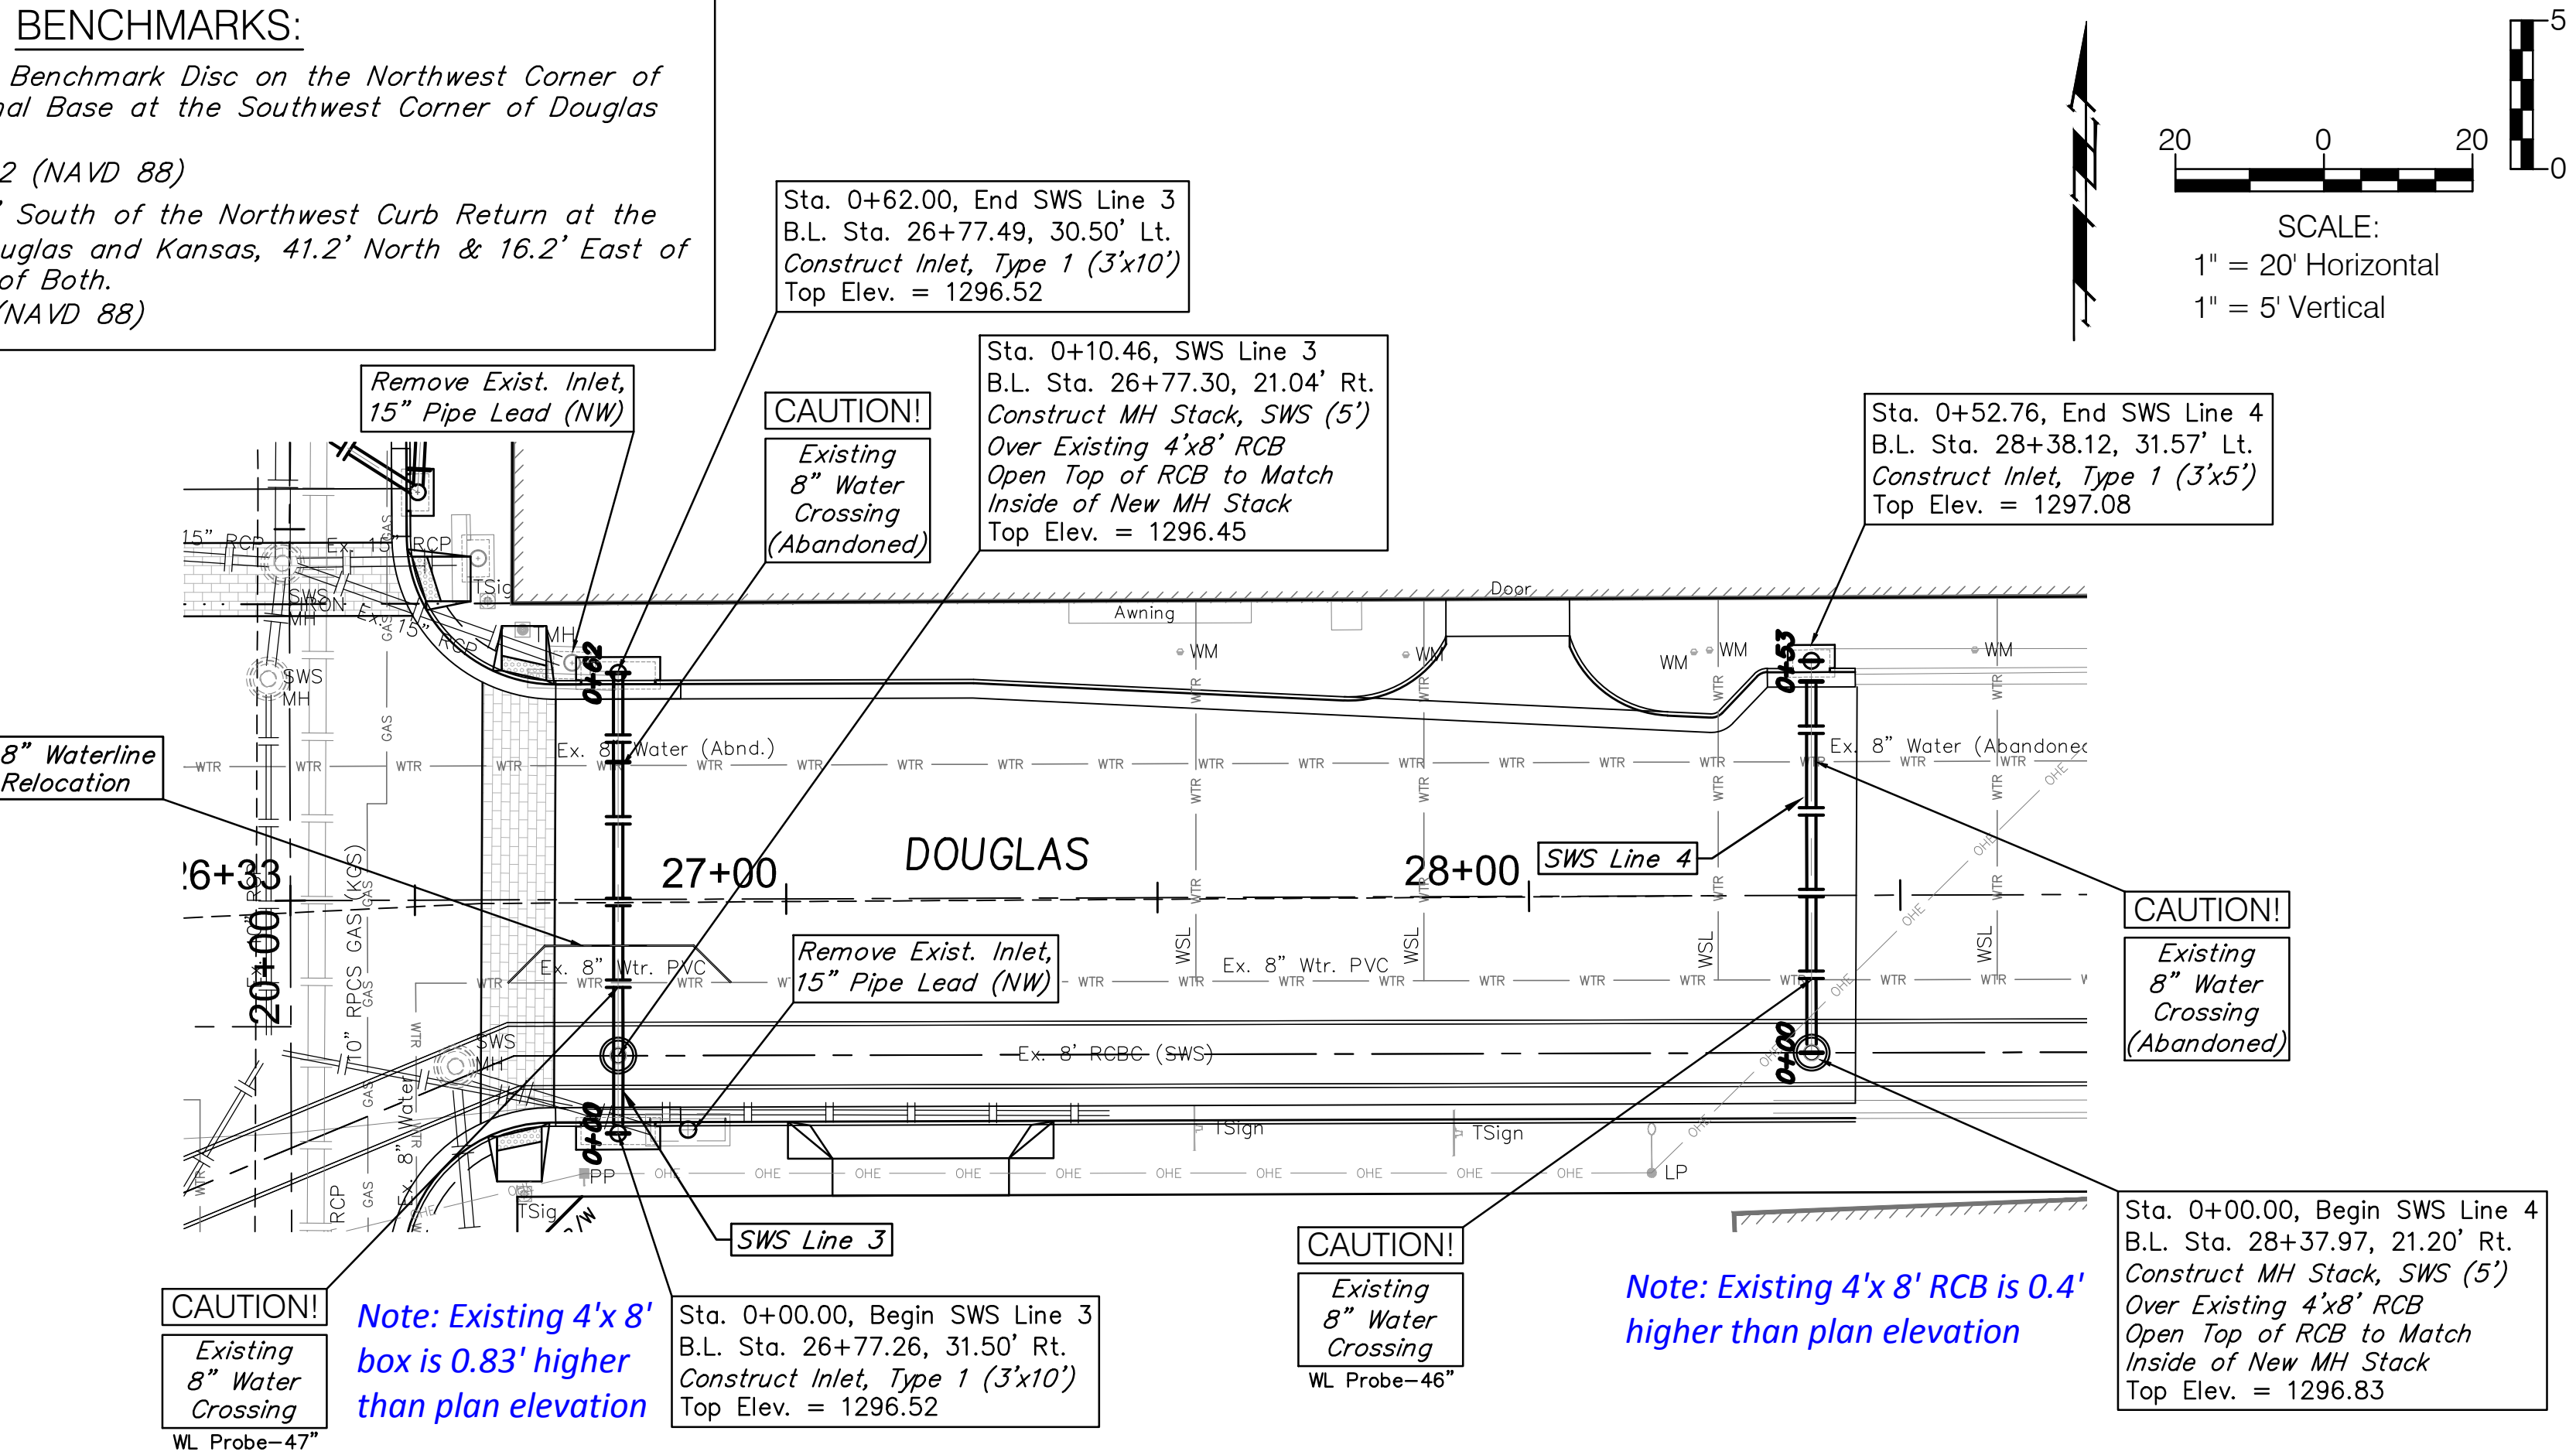

SWS Line 3

SWS Line 4

Waterline Relocation

