# PAVING AND INCIDENTAL DRAINAGE IMPROVEMENTS

TO SERVE

# OAK CREEK 3RD-PRIVATE PAVING IMPROVEMENTS


LOTS 1 THRU 27, BLOCK 1, OAK CREEK 3RD

LOTS 1 THRU 5, BLOCK 2, OAK CREEK 3RD

PRIVATE PROJECT NO. 1716 PPS (607861)

# CITY OF WICHITA, KANSAS

JAMES L. ARMOUR, P.E. - CITY ENGINEER

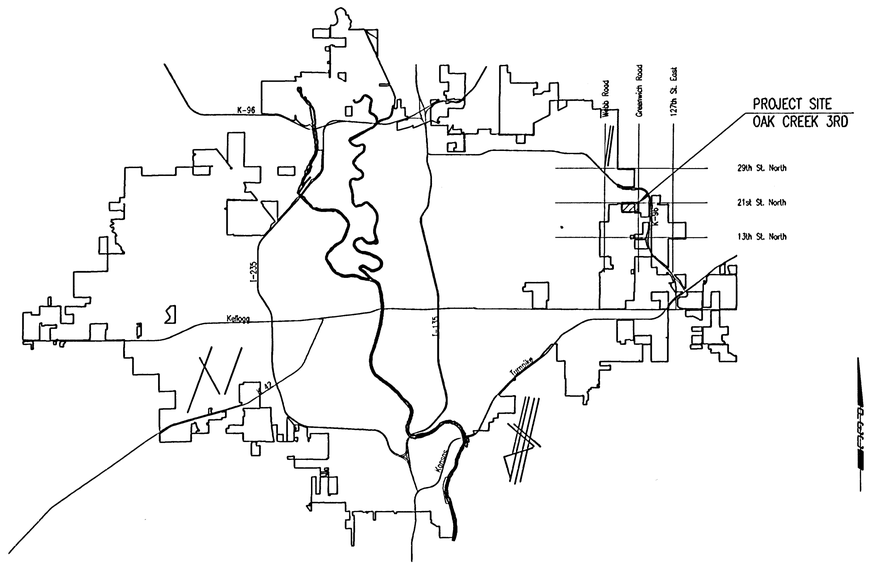


LOCATION MAP

INDEX OF SHEETS


| | |
|---|---|
| 1. | TITLE SHEET |
| 2. | PLAT |
| 3. | KEY MAP AND GENERAL NOTES |
| 4. | FOUR CORNER PLAN |
| 5. | SITE GRADING PLAN |
| 6. | TYPICAL 29' BK.-BK. PAVEMENT DETAILS |
| 7. | TYPICAL 17' BK.-BK. PAVEMENT DETAILS |
| 8-10. | PAVING PLANS-GLENGATE CIRCLE |
| 11. | ENTRANCE DETAILS |
| 12. | VALLEY GUTTER PLAN |
| 13. | VALLEY GUTTER DETAILS |
| 14. | PARKING BAY DETAILS |
| 15. | MISCELLANEOUS PAVING DETAILS |
| 16. | PLAN/PROFILE-SWS LINE NO. 1 |
| 17. | PLAN/PROFILE-SWS LINE NO. 1A |
| 18. | PLAN/PROFILE-SWS LINE NO. 2 |
| 19. | STD. TYPE 1A CURB INLET (10' OPENING) |
| 20. | STD. TYPE 1 CURB INLET (10' OPENING) |
| 21. | STD TYPE "P" MANHOLE DETAILS |
| 22. | TYPE "C" INLET DETAILS |
| 23. | MANHOLE FRAME AND COVER DETAILS |
| 24. | MISCELLANEOUS DRAINAGE DETAILS |
| 25. | ELECTRICAL DETAILS |
| 26. | ELECTRICAL PLAN |
| 27. | EROSION CONTROL PLAN |
| 28-31. | EROSION CONTROL DETAILS |
| 32-45. | CROSS SECTIONS |


EARTHWORK

| | |
|---|---|
| EXCAVATION | 377 CU. YDS. |
| LOOSE FILL | 1,046 CU. YDS. |

| SUBDIVISION BENCH MARKS (SBM) | | | | |
|---|---|---|---|---|
| NO. | STREET AND STATION | FROM ℄ | DESCRIPTION | ELEVATION |
| 1 | ℄ 1 GLENGATE CIR. STA. 22+82.58 | 14.5' RT. | N. END, NORTHWEST CURB RETURN, GLENGATE CIR. | |
| | | | | |
| | | | | |
| | | | | |
| | | | | |
| | | | | |

THE COST OF THE BENCH MARK DISC, INCLUDING INSTALLATION, SHALL BE INCIDENTAL TO THE CURB.

*APPROVED AS NOTED*
*By CITY ENGINEER OF WICHITA*

*Sanitary Sewers* _____

*Storm Sewers* VRH 10/24/06

*Driveway Approaches* _____

*Paving* _____

*NOTE TO CONTRACTOR*

*INSPECTION AND TESTING FOR THIS PROJECT IS TO BE PROVIDED BY A LICENSED CONSULTING ENGINEERING FIRM CONTRACTED BY THE OWNER/DEVELOPER. SAID INSPECTION TO BE IN ACCORDANCE WITH THE CITY OF WICHITA STANDARD CONSTRUCTION ENGINEERING PRACTICES AND CERTIFIED BY A LICENSED PROFESSIONAL ENGINEER. NO WORK SHALL BE PERFORMED IN DEDICATED EASEMENTS OR PUBLIC RIGHT-OF-WAY BY THE CONTRACTOR UNTIL SUCH INSPECTION IS ARRANGED FOR AND REQUIRED BONDS HAVE BEEN SUBMITTED TO AND APPROVED BY THE CITY NOR SHALL ANY WORK BE COMMENCED IN DEDICATED EASEMENTS OR PUBLIC RIGHT-OF-WAY WITHOUT WRITTEN AUTHORIZATION BY THE CITY ENGINEER. IMPROVEMENTS PERFORMED UNDER THIS PROJECT SHALL NOT BE ACCEPTED BY THE CITY UNTIL ALL APPLICABLE DOCUMENTATION HAS BEEN SUBMITTED TO THE CITY ENGINEER. THIS WAY INCLUDE: RECORD DRAWINGS, INSPECTION LOGS, TEST DOCUMENTATION, TV TAPES, AND A CERTIFICATE OF COMPLETION. THE ABOVE SHALL BE PERFORMED BY THE CONSULTING FIRM CONTRACTED TO INSPECT THIS PROJECT.*

AS-BUILT
12/27/06
Date K.E. Miller
Signed

# OCTOBER 2006

PLANS PREPARED BY

## PROFESSIONAL ENGINEERING CONSULTANTS, P.A.

ENGINEERS

WICHITA, KANSAS

BRIAN D. BOUTWELL LICENSED 10889 KANSAS PROFESSIONAL ENGINEER
10/24/06

Saved: 10-24-2006 9:41:46 AM by BJS
Plot: Scale 1:1 10-24-2006 9:42:24 AM by BJS
G:\2006\06572\000\06572-000-C-Title Sheet