
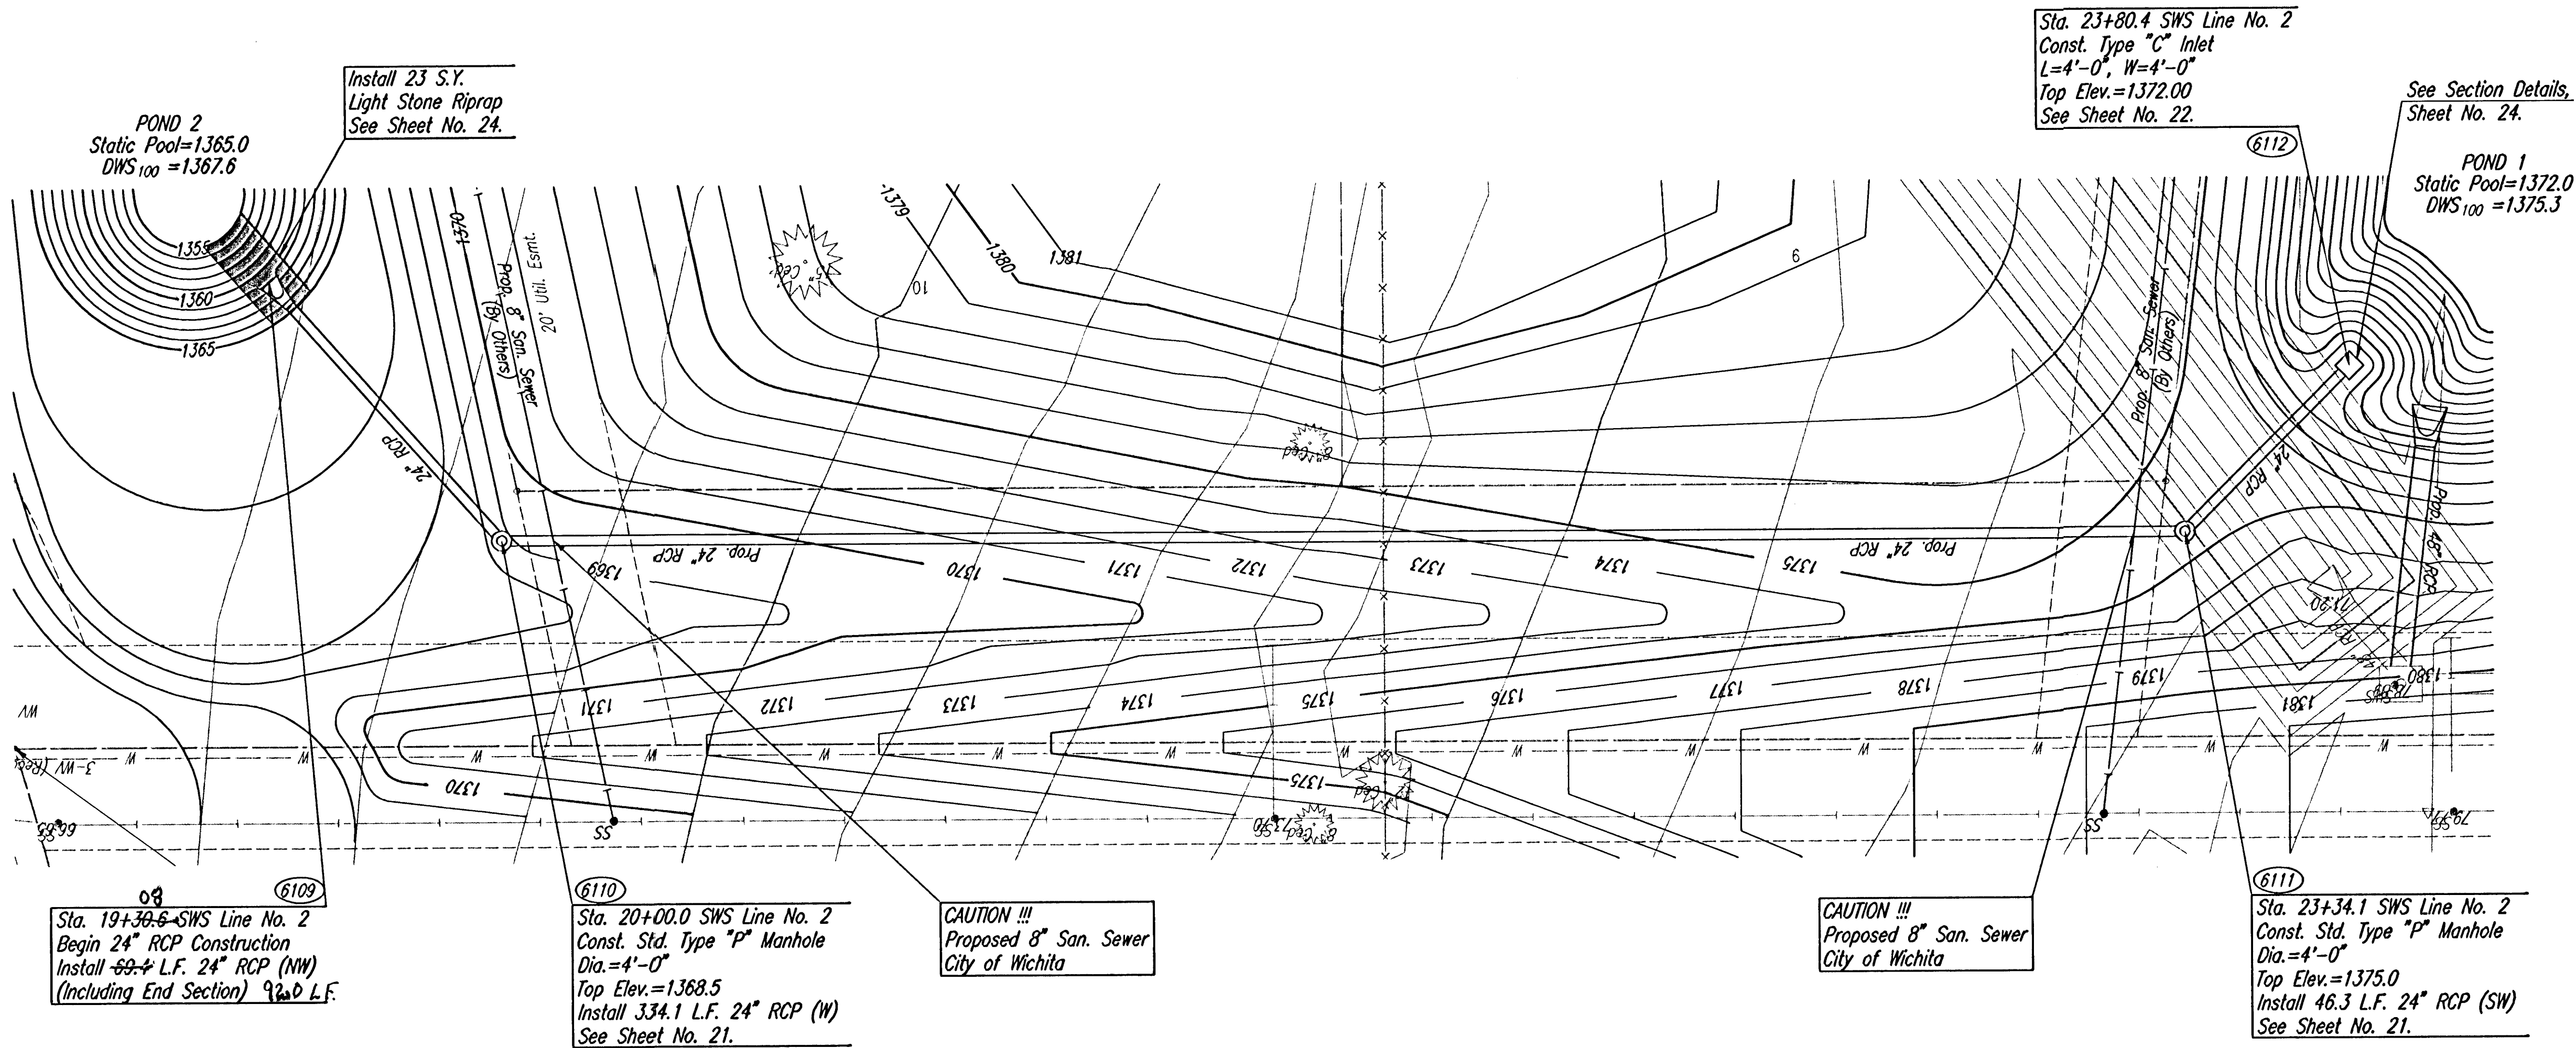


Saved: 10-23-2006 6:56:50 PM by BDB

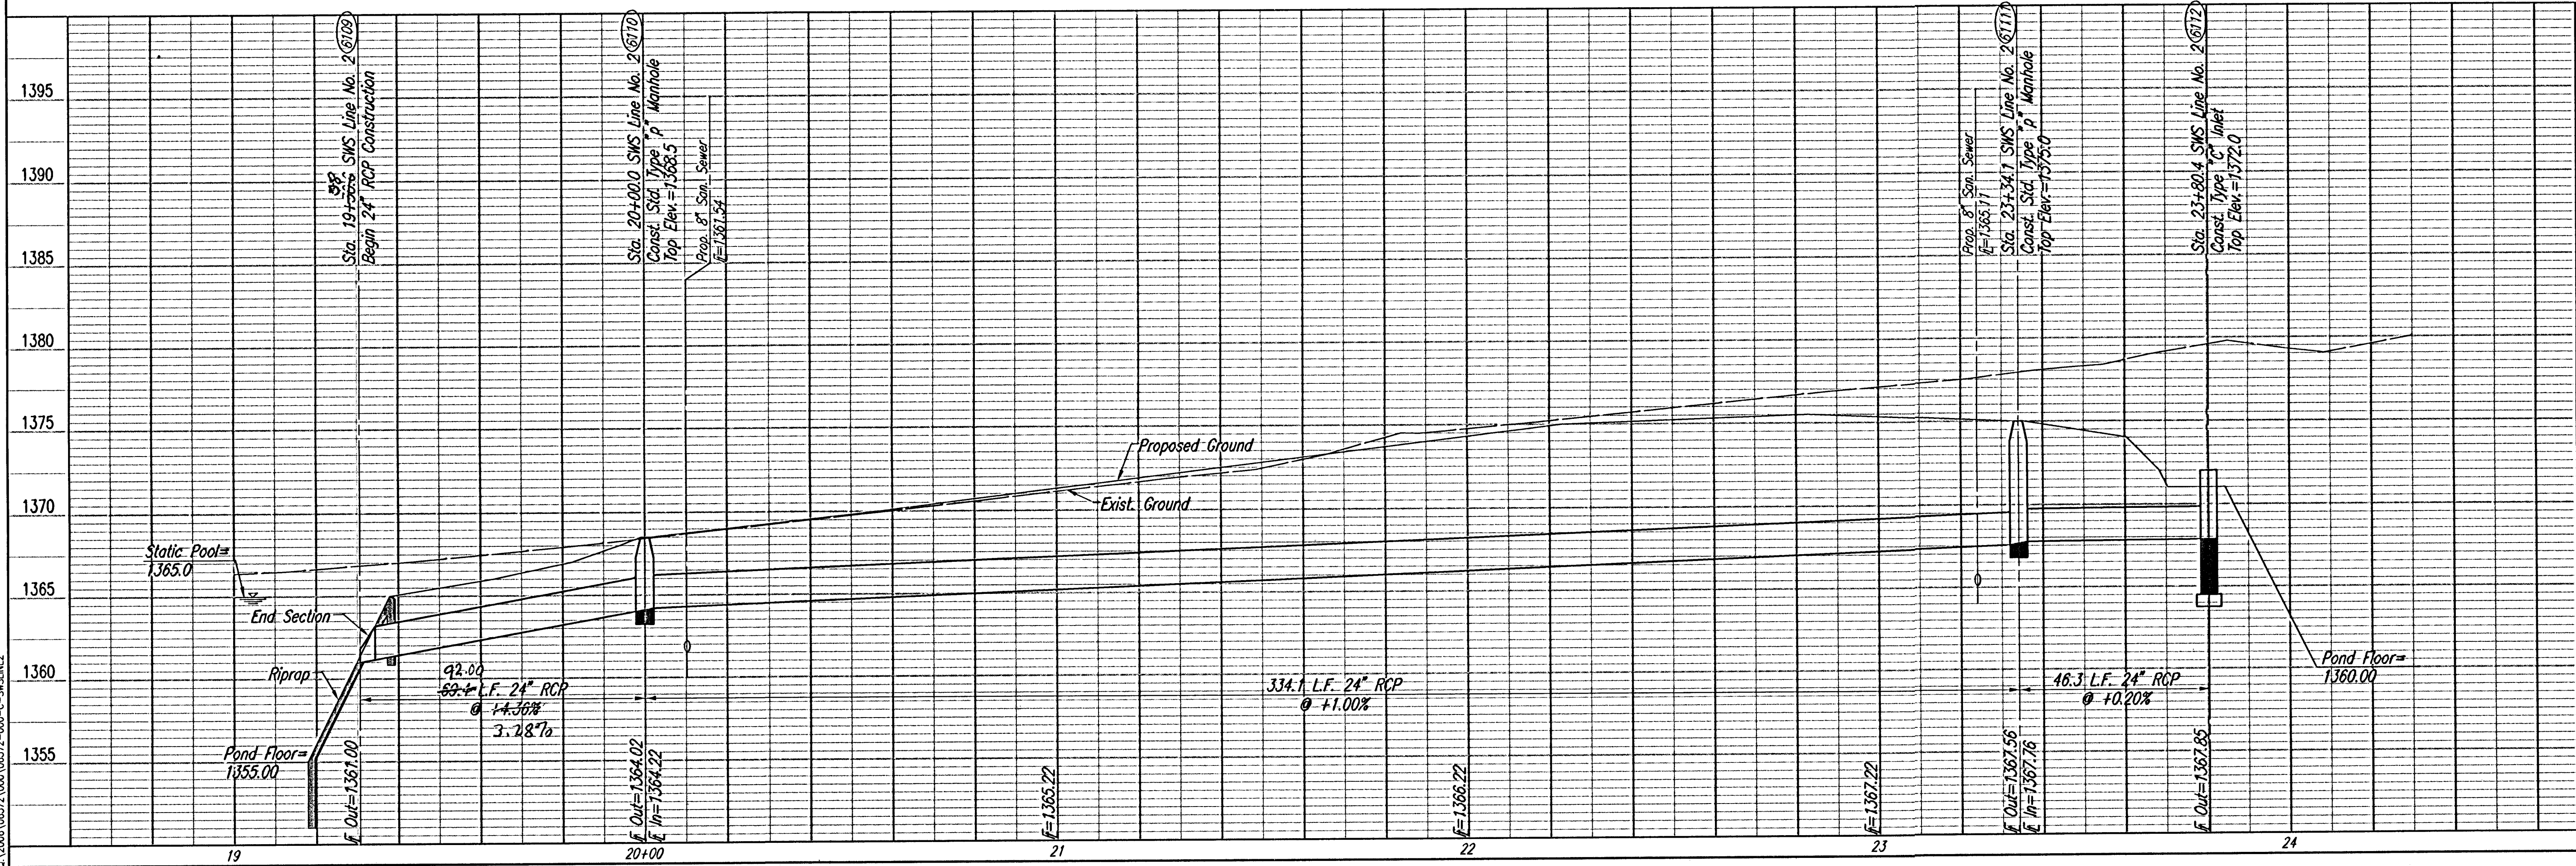

COORDINATE LIST		
POINT	NORTH	EAST
6109	386,526.6233	2,372,990.5439
6110	386,577.8082	2,372,943.7218
6111	386,573.2881	2,372,609.6822
6112	386,539.9989	2,372,577.5096

6109 = COORDINATE POINT NO.
SEE SHEET NO. 2 FOR PLAT COORDINATES

Scale 1"=20'

OAK CREEK 3RD - PHASE 1
SWS LINE NO. 2

Professional Engineering Consultants, P.A.
303 S. TOPEKA - WICHITA, KANSAS 67202
316-262-2691 • FAX 316-262-5003

Designed By BDB, BMM
Drawn By BDB, TAT
Job No. 35-06572-000
Date February 2006