

UTILITIES SHOWN REPRESENT THE BEST INFORMATION AVAILABLE FOR DESIGN. ADDITIONAL UTILITIES MAY BE PRESENT ON THIS PROJECT. THE CONTRACTOR SHALL BE RESPONSIBLE FOR DETERMINING THE EXACT LOCATION, DEPTH AND SIZE OF ALL UNDERGROUND UTILITIES PRIOR TO CONSTRUCTION. THE CONTRACTOR SHALL BE LIABLE FOR ANY DAMAGE CAUSED BY THE FAILURE TO DO SO.

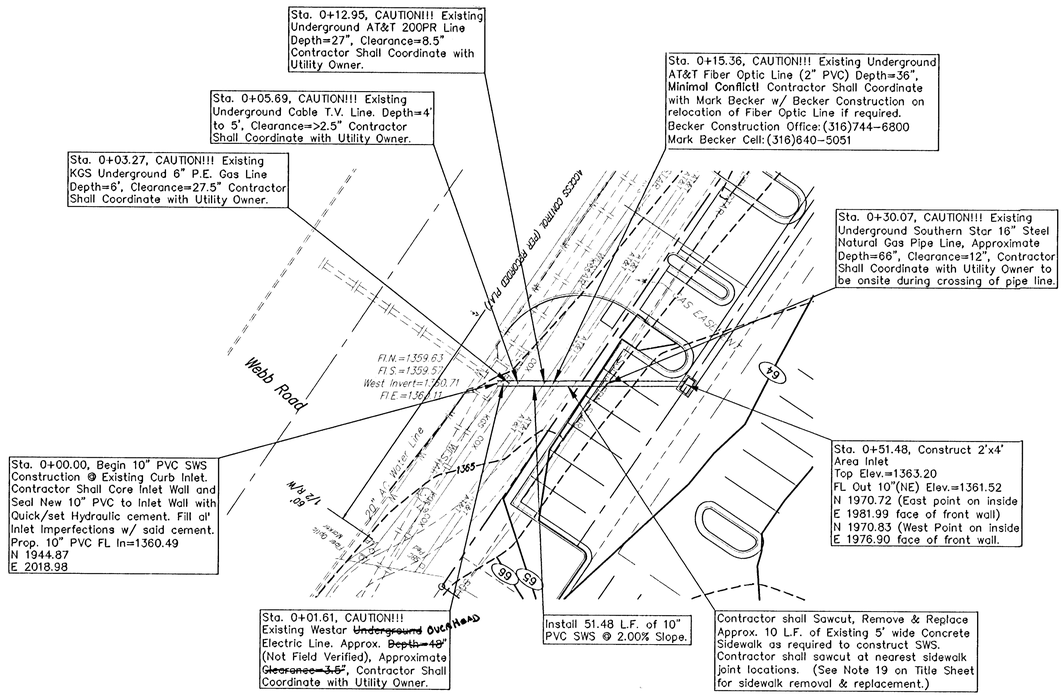

SWS IMPROVEMENTS

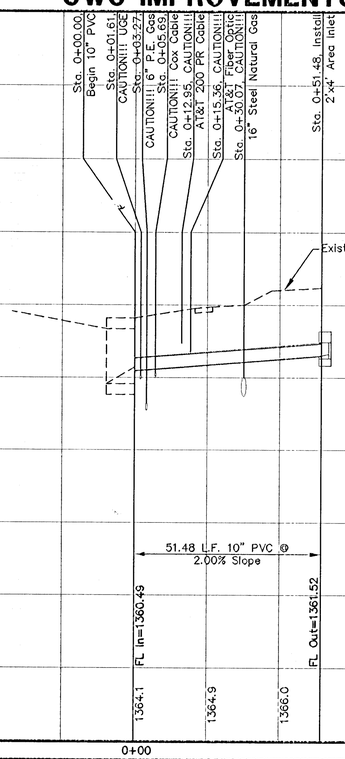

This Plan was Revised to Reflect a 10" PVC SWS Design

This Plan was Revised to Reflect a 10" PVC SWS Design

GRAPHIC SCALE

20 0 10 20 40

(IN FEET)
1 inch = 20 ft.

EB = Electric Box
FH = Fire Hydrant
GU = Guard Post(Bollard)
LP = Light Pole
PM = Pipeline Marker
SSMH = Sanitary Sewer Manhole
SBCMH = SBC Telephone Manhole
SBC Ped = SBC Telephone Pedestal
WM = Water Meter
WV = Water Valve
XFMR = Transformer

● = #4 Baughman Rebar Found
○ = 3/4" Iron Pipe Found
> = Chiseled V-Notch Found

COX — Cox Cable
SOUTHERN STAR — Southern Star Naturol Gas
KGS — Kansas Gas Service
WESTAR — Electric Line
SS — SS — Sanitary Sewer Line
Stormwater Sewer Line
AT&T — Telephone Line
W — W — W — Water Line
X — X — X — X — Fence Line

SURVEY DISCLAIMER:
TOPOGRAPHIC SURVEY AND CONTOUR MAP USED IN PREPARING PLANS WAS PROVIDED BY BAUGHMAN COMPANY P.A., 315 ELLIS, WICHITA, KS (316)262-7271. ENGINEER DOES NOT GUARANTEE SURVEY ELEVATIONS FOR ACCURACY. CONTRACTOR SHALL VERIFY ELEVATIONS AND NOTIFY ENGINEER OF ANY DISCREPANCIES.

SWS IMPROVEMENTS TO SERVE
RETAIL CENTER
1353 SOUTH WEBB ROAD, WICHITA, KS
C.O.W. PROJ. NO.: 1678 PPS (607861)

CERTIFIED ENGINEERING DESIGN, P.A.
810 WEST DOUGLAS, SUITE C
WICHITA, KANSAS 67203
PH.(316)262-8808 FAX.(316)262-1669

DESIGNED: HDF	SCALE: 1"=20'	SHEET 4R
DRAWN: CKW	DATE: 6/06	
CHECKED: HDF	CED FILE: Boston&WebbRetail	TOTAL 5