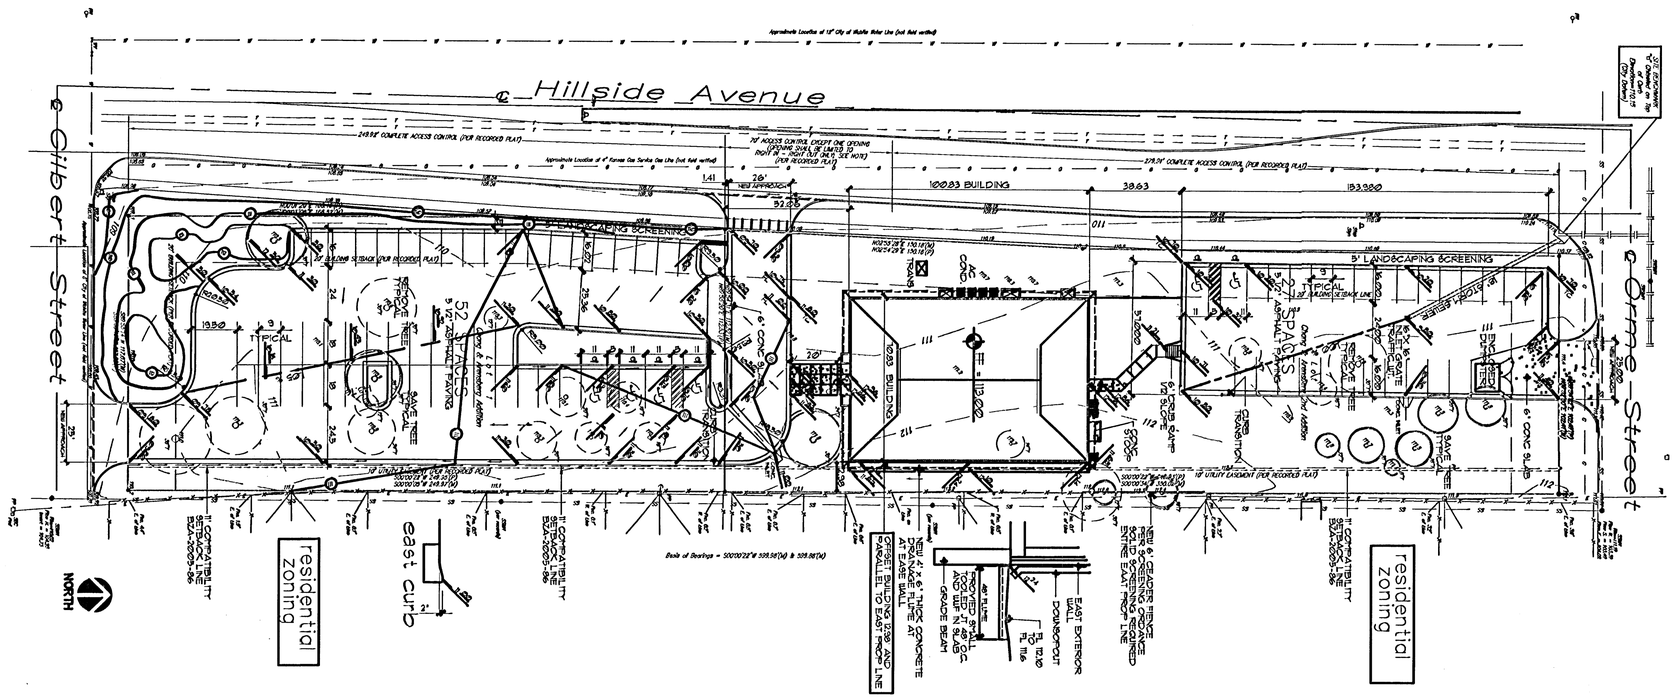

SITE PLAN

SCALE : 1" = 30'

Baughman

Baughman Company, P.A. 315 Ella St. Wichita, KS 67211 P 316.262.7271 F 316.262.0149
ENGINEERING | SURVEYING | PLANNING | LANDSCAPE ARCHITECTURE

AS-BUILT 8-31-06 HDF WICED