
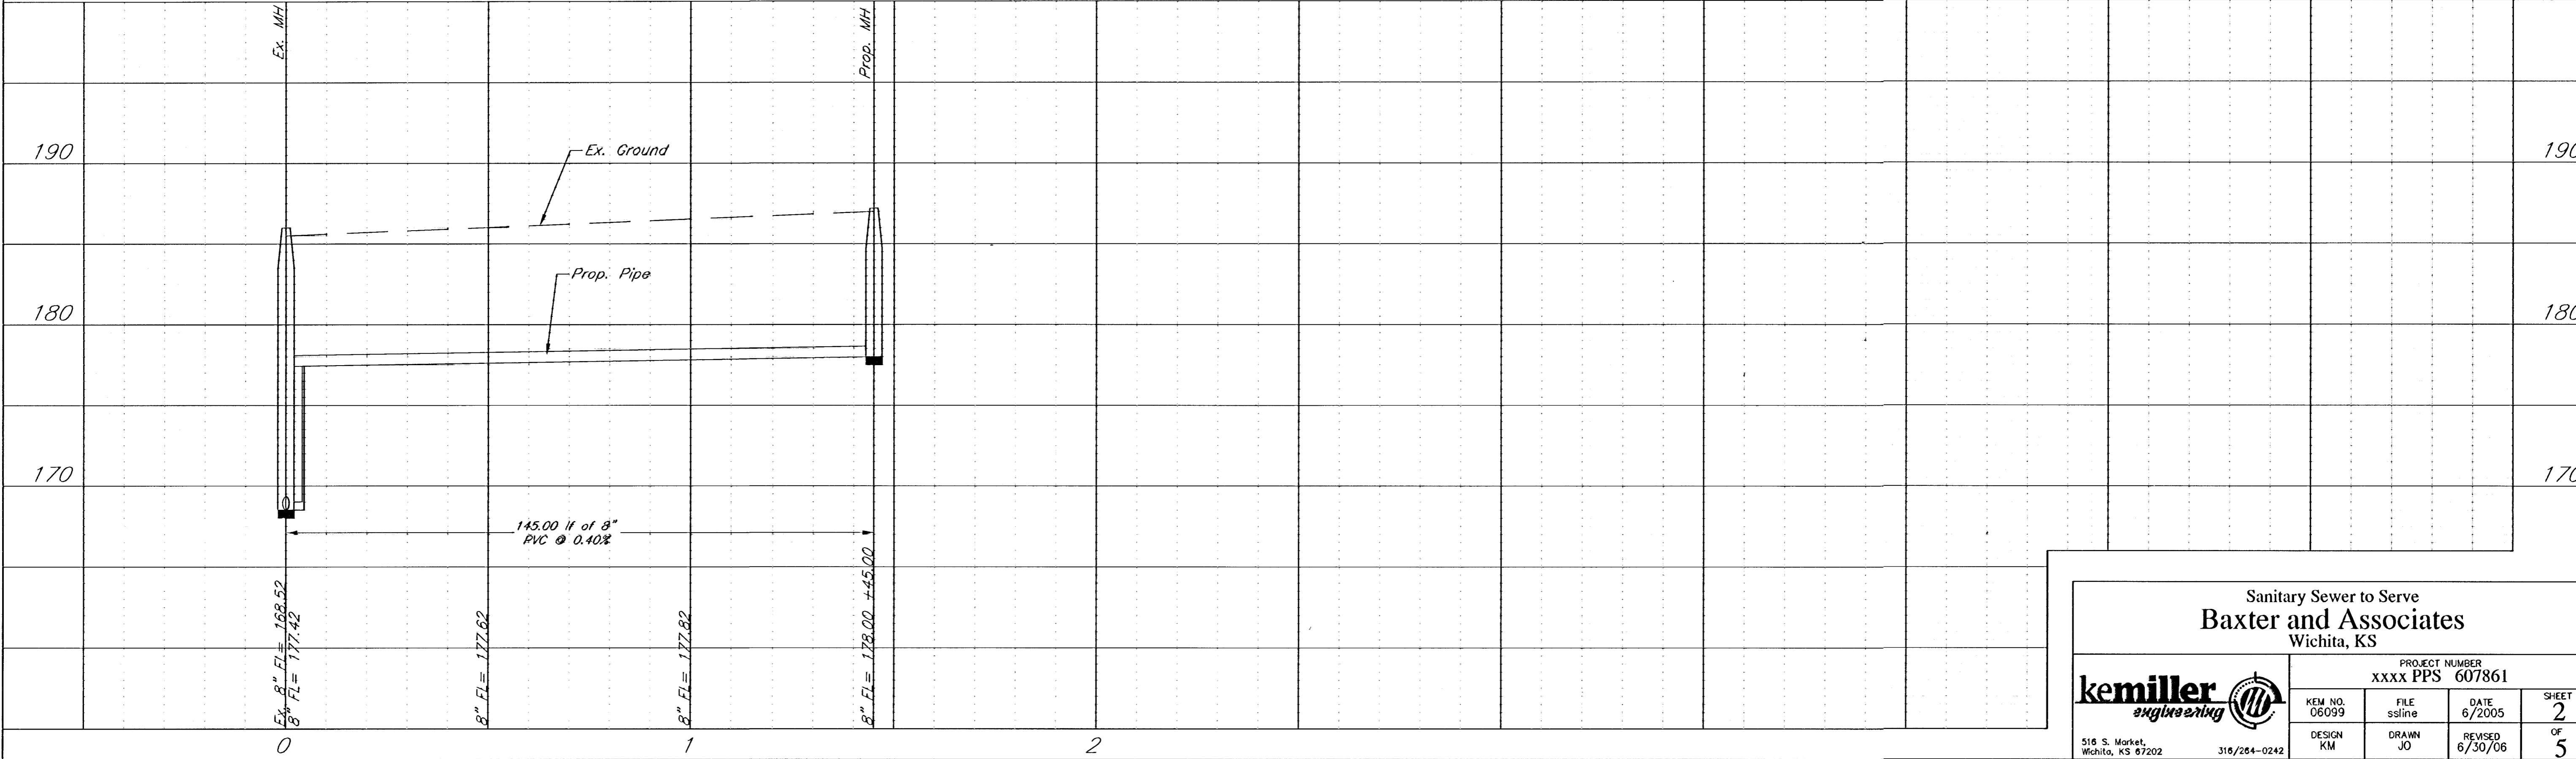


**Benchmark:**  
 R.R. Spike in N. Face of  
 P.P. 120'± of Ctr. Res.  
 A on W. side of Wawona.

**Baseline:**  
 0+00 at the Intersection  
 of 21st and Wawona.

1

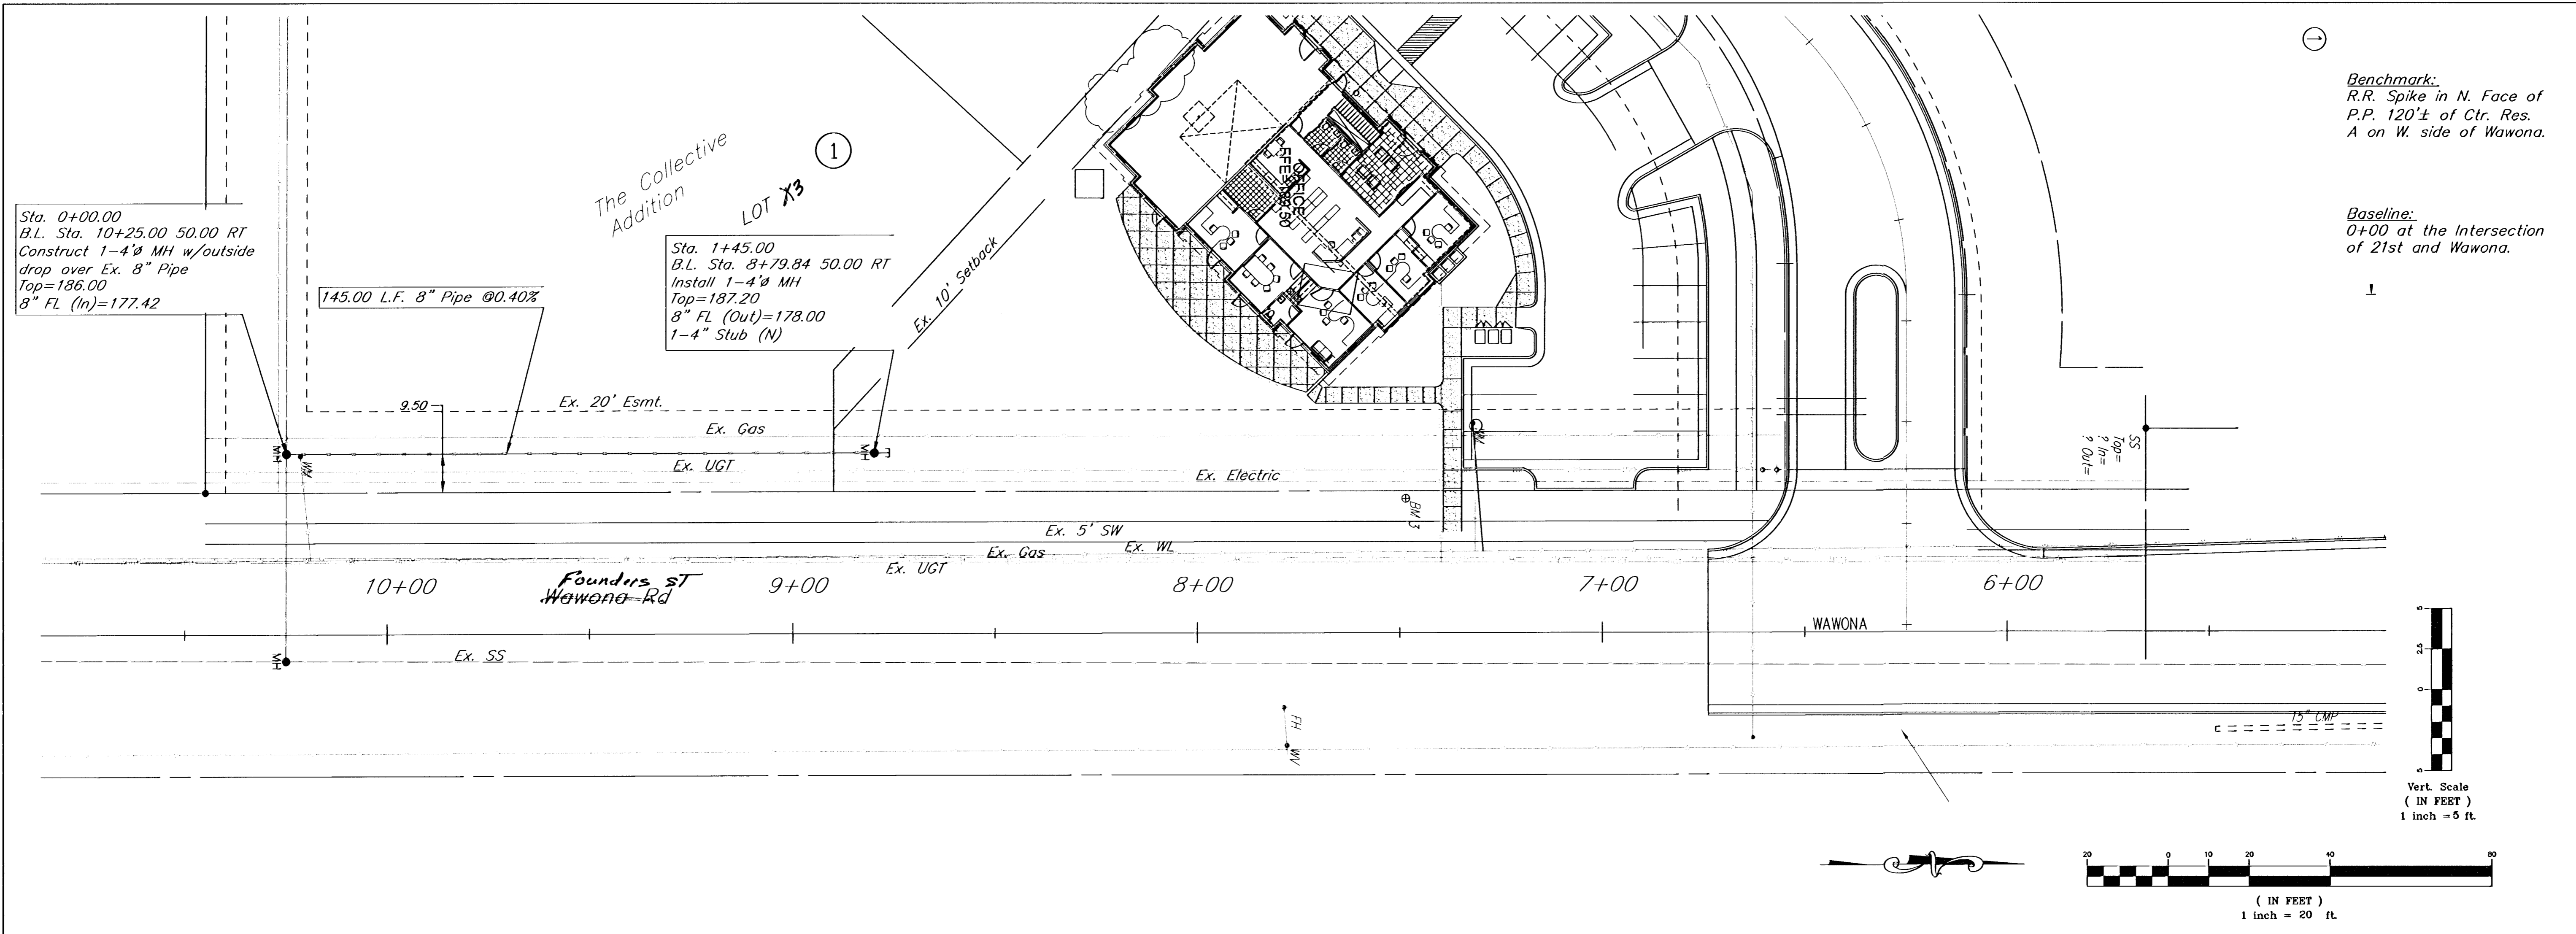

Sanitary Sewer to Serve  
**Baxter and Associates**  
 Wichita, KS

<b>kemiller</b> <i>engineering</i>		PROJECT NUMBER XXXX PPS 607861		SHEET 2	
		KEM NO. 06099	FILE ssline	DATE 6/2005	
516 S. Market, Wichita, KS 67202		DESIGN KM	DRAWN JO	REVISED 6/30/06	OF 5

316/284-0242