



Benchmark:
 R.R. Spike in N. Face of
 P.P. 120± of Ctr. Res.
 A on W. side of Wawona.

Baseline:
 0+00 at the Intersection
 of 21st and Wawona.

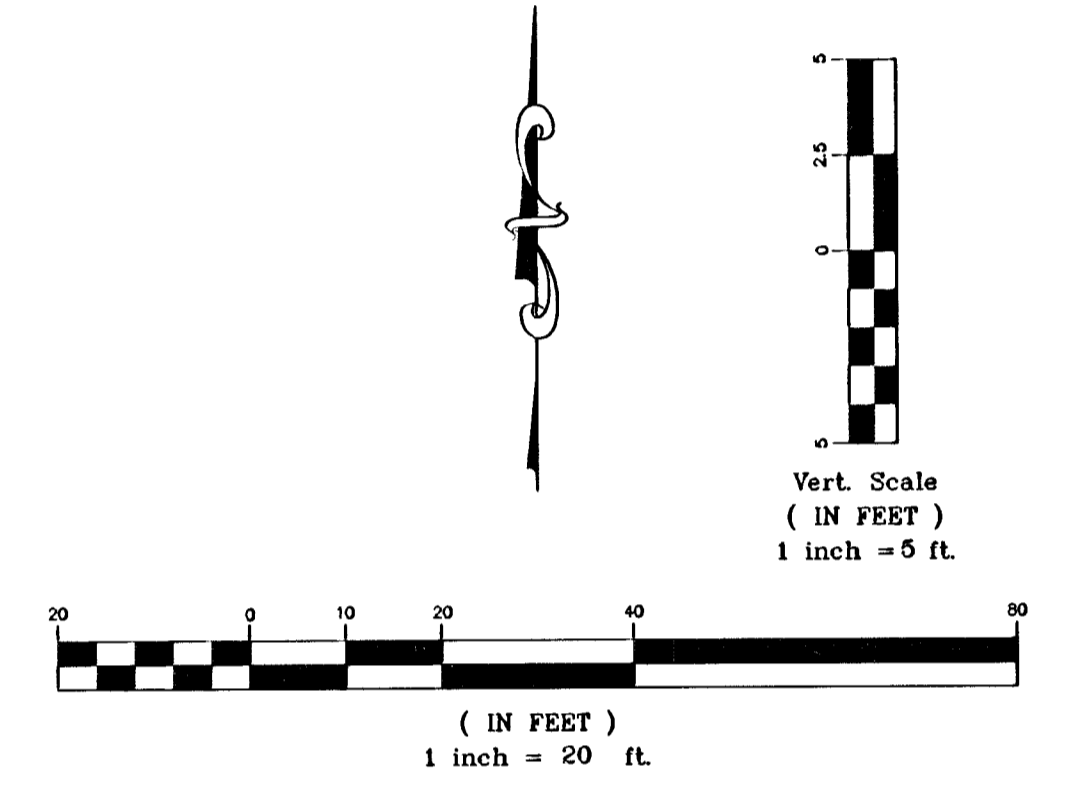

101
 178.00
 1+45

93
 187.20
 new mh

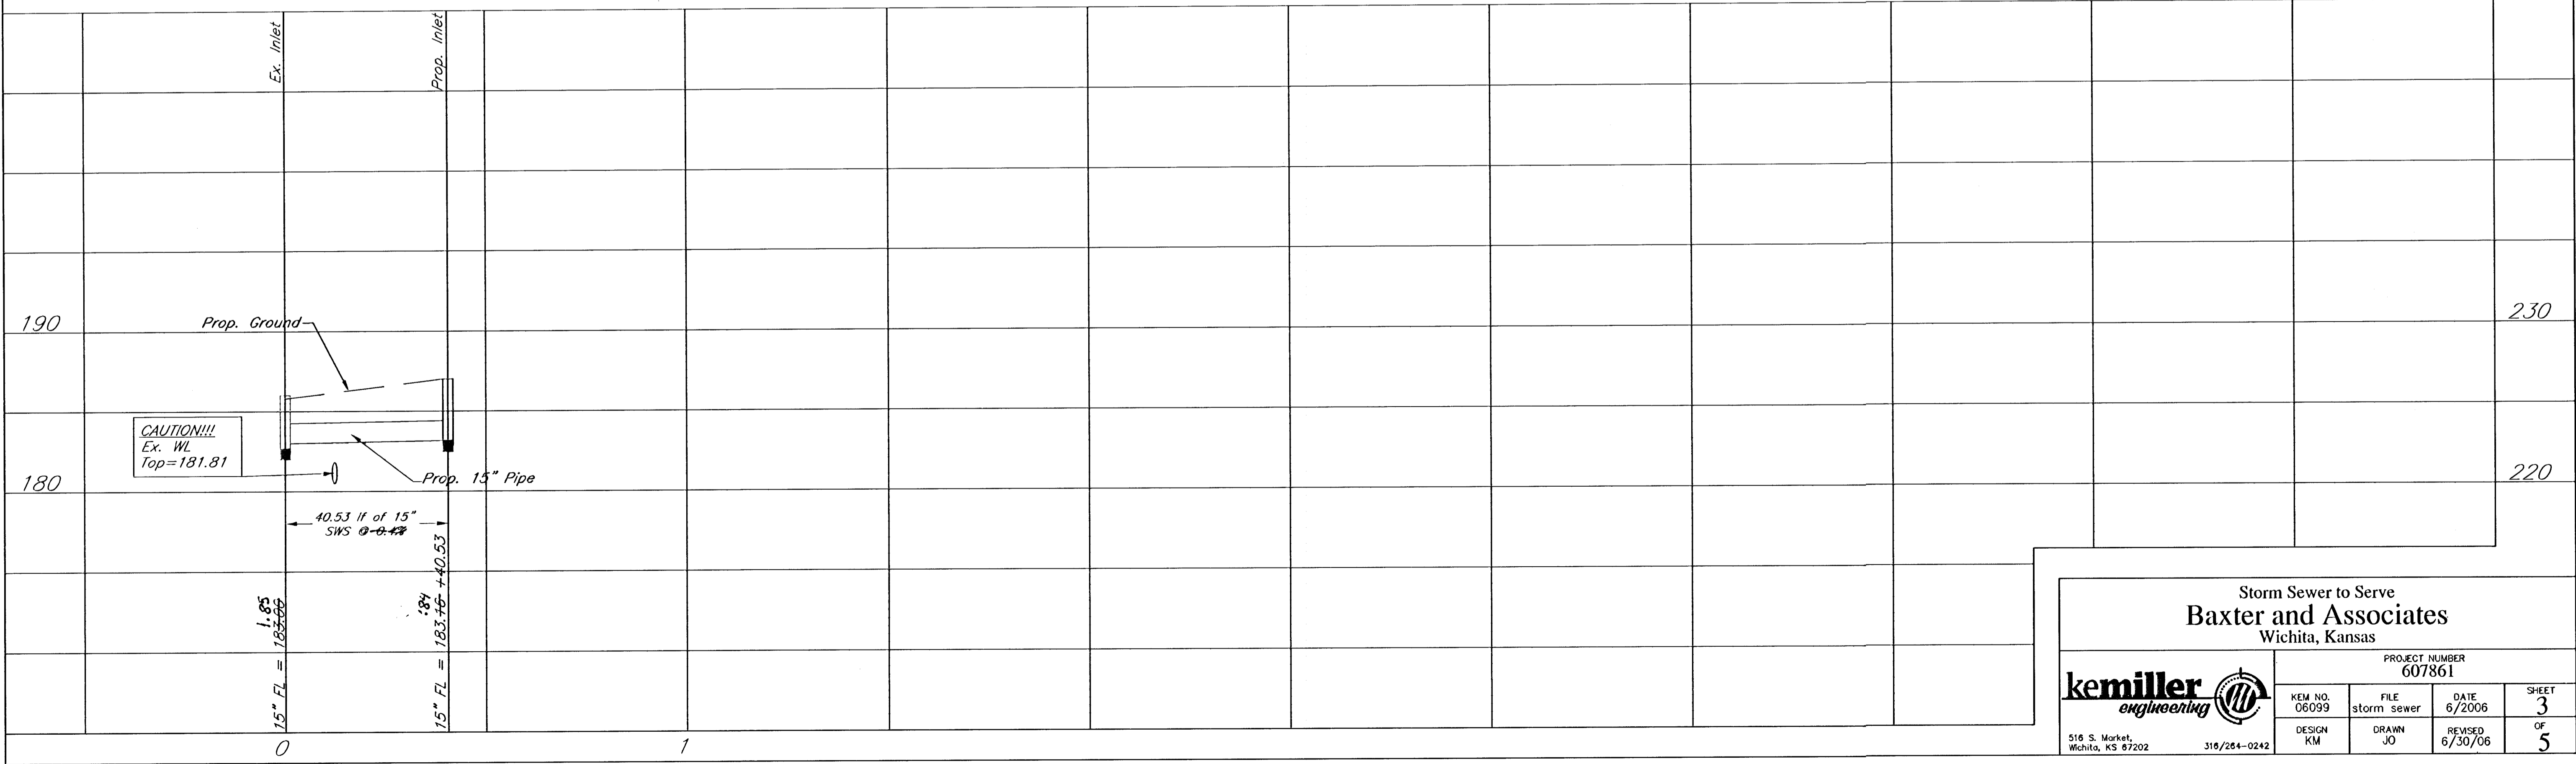

Storm Sewer to Serve
Baxter and Associates
 Wichita, Kansas

kemiller <i>engineering</i>		PROJECT NUMBER 607861				
		KEM NO. 06099	FILE storm sewer	DATE 6/2006	SHEET 3	
516 S. Market, Wichita, KS 67202		316/264-0242	DESIGN KM	DRAWN JO	REVISED 6/30/06	OF 5