
BENCHMARK:
CITY OF WICHITA DISC – MAIZE RD. & STERLING,
(2400 BLOCK N.), TOP OF CURB, WEST END OF
MEDIAN ON C OF STERLING.
61' E. OF C OF MAIZE RD.
ELEV. = 1353.57 NGVD29


SMALL RAILROAD SPIKE IN E. FACE OF POWER POLE,
34.6' S. & 6.9' W. OF THE NW COR. OF LOT 2,
BLOCK A.
ELEV. = 1351.99 NGVD29

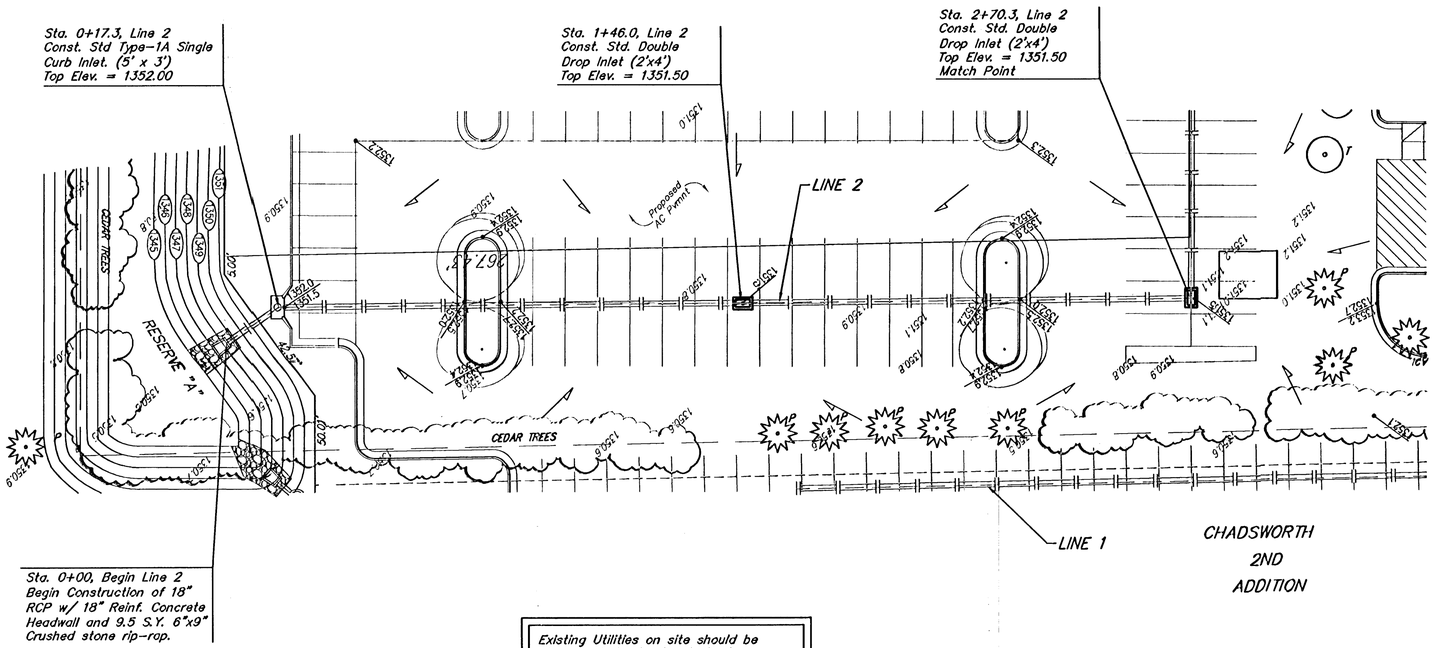

CHADSWORTH
2ND
ADDITION

SCALE:
1" = 20' HORIZONTAL
1" = 5' VERTICAL
• = IRON

Existing Utilities on site should be disconnected prior to start of Construction. Contractor to verify and coordinate with General Contractor.

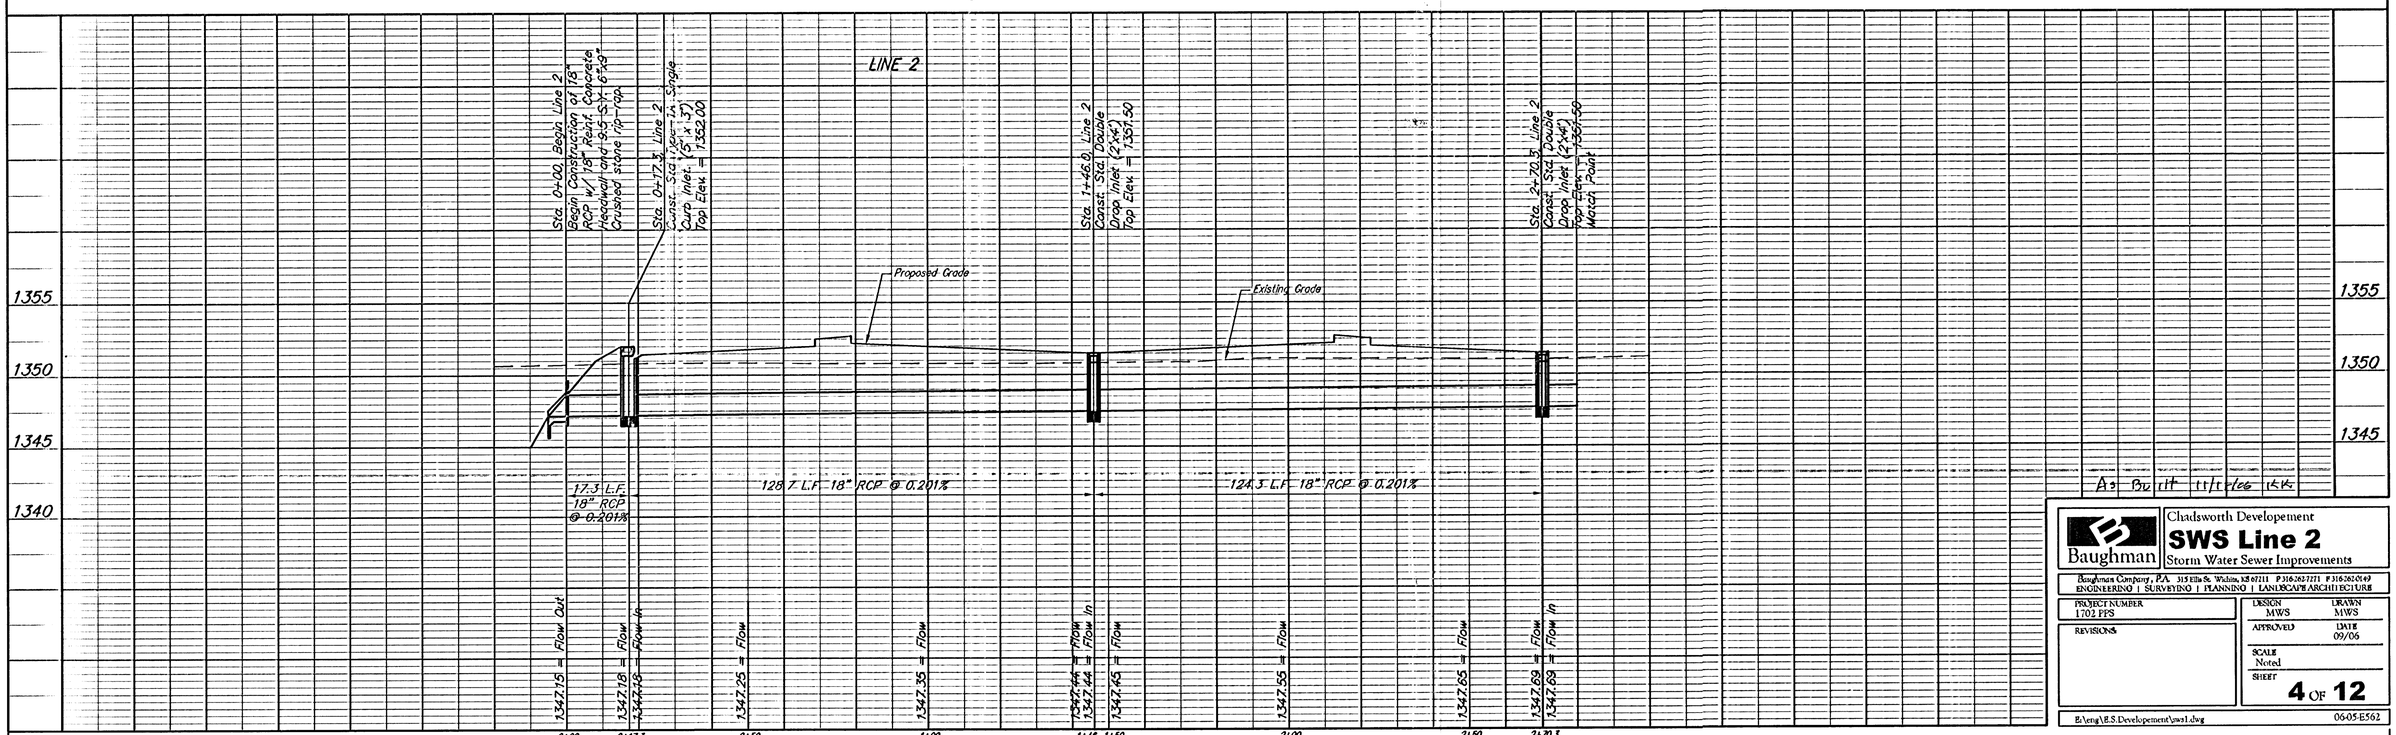

As Bu rit tit 9/06 ck

Baughman

Chadsworth Developement
SWS Line 2
Storm Water Sewer Improvements

Baughman Company, P.A. 315 Ella St. Wichita, KS 67211 P 316.263.7171 F 316.263.0549
ENGINEERING | SURVEYING | PLANNING | LANDSCAPE ARCHITECTURE

PROJECT NUMBER
1702 FPS

DESIGN MWS
DRAWN MWS
APPROVED
DATE 09/06

REVISIONS

SCALE
Noted

SHEET
4 OF 12

E:\eng\E.S.Developement\sws1.dwg

0605-E562