BENCHMARK:
CITY OF WICHITA DISC – MAIZE RD. & STERLING,
(2400 BLOCK N.), TOP OF CURB, WEST END OF
MEDIAN ON C OF STERLING.
61' E. OF C OF MAIZE RD.
ELEV. = 1353.57 NGVD29

SMALL RAILROAD SPIKE IN E. FACE OF POWER POLE,
34.6' S. & 6.9' W. OF THE NW COR. OF LOT 2,
BLOCK A.
ELEV. = 1351.99 NGVD29

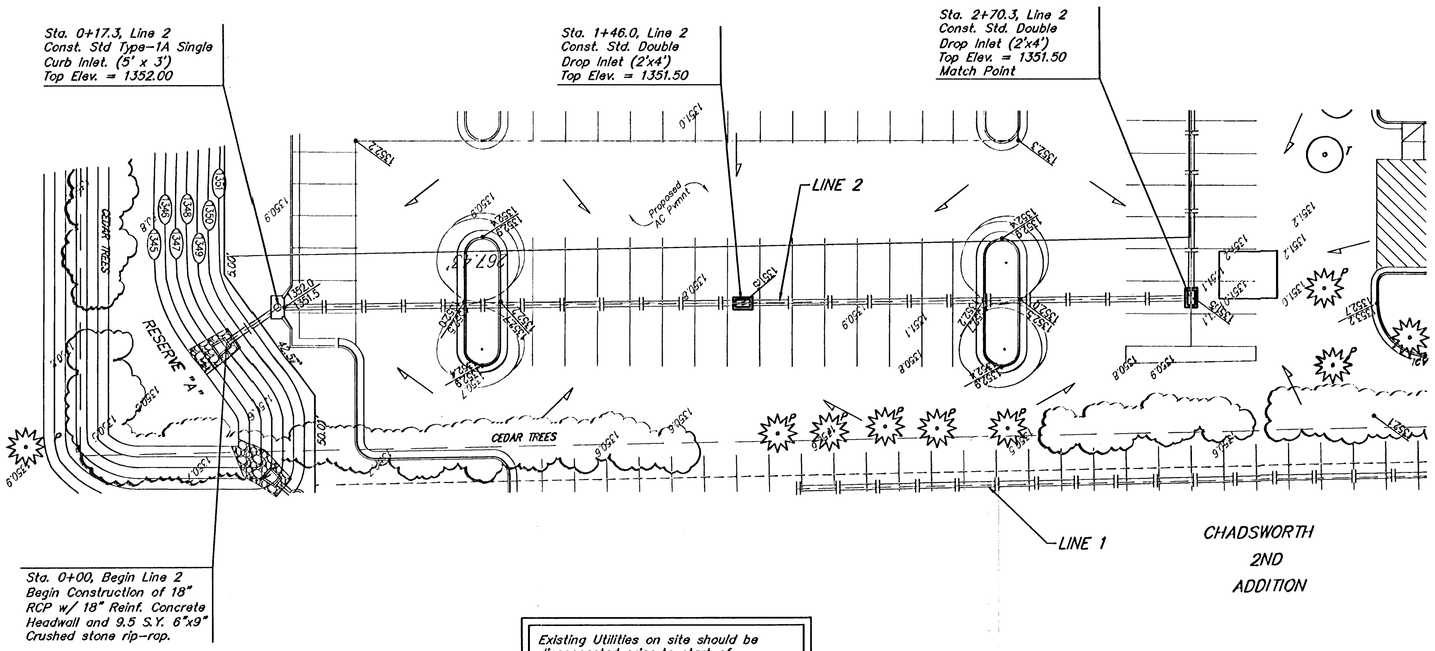

CHADSWORTH
2ND
ADDITION

SCALE:
1" = 20' HORIZONTAL
1" = 5' VERTICAL
• = IRON

Existing Utilities on site should be disconnected prior to start of Construction. Contractor to verify and coordinate with General Contractor.

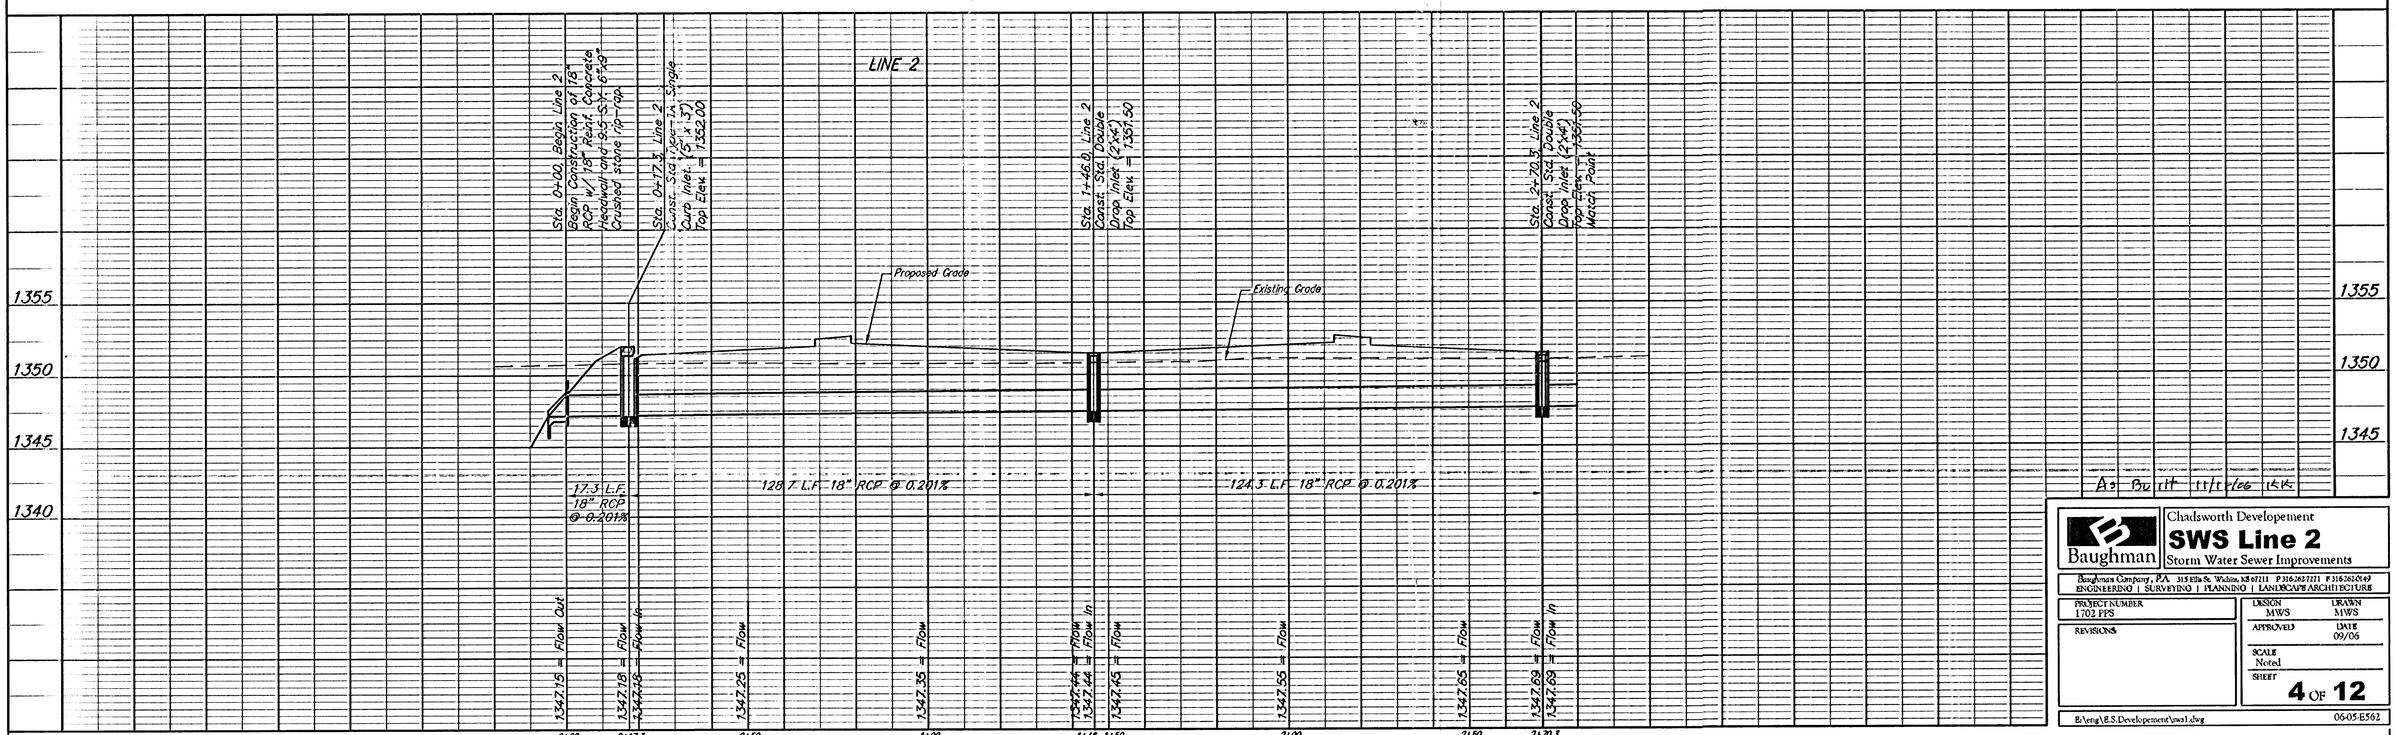

A3 Bw rit ttlt rlee ck

Baughman

Chadsworth Developement
SWS Line 2
Storm Water Sewer Improvements

Baughman Company, P.A. 315 Ella St. Wichita, KS 67211 P 316.263.7731 F 316.263.0549
ENGINEERING | SURVEYING | PLANNING | LANDSCAPE ARCHITECTURE

PROJECT NUMBER 1702 FPS
DESIGN MWS
DRAWN MWS
APPROVED
DATE 09/06
REVISIONS
SCALE Noted
SHEET **4 OF 12**

E:\eng\E.S.Developement\sws1.dwg 0605-E562