

BENCHMARK:
CITY OF WICHITA DISC – MAIZE RD. & STERLING,
(2400 BLOCK N.), TOP OF CURB, WEST END OF
MEDIAN ON C OF STERLING.
61' E. OF C OF MAIZE RD.
ELEV. = 1353.57 NGVD29

SMALL RAILROAD SPIKE IN E. FACE OF POWER POLE,
34.6' S. & 6.9' W. OF THE NW COR. OF LOT 2,
BLOCK A.
ELEV. = 1351.99 NGVD29

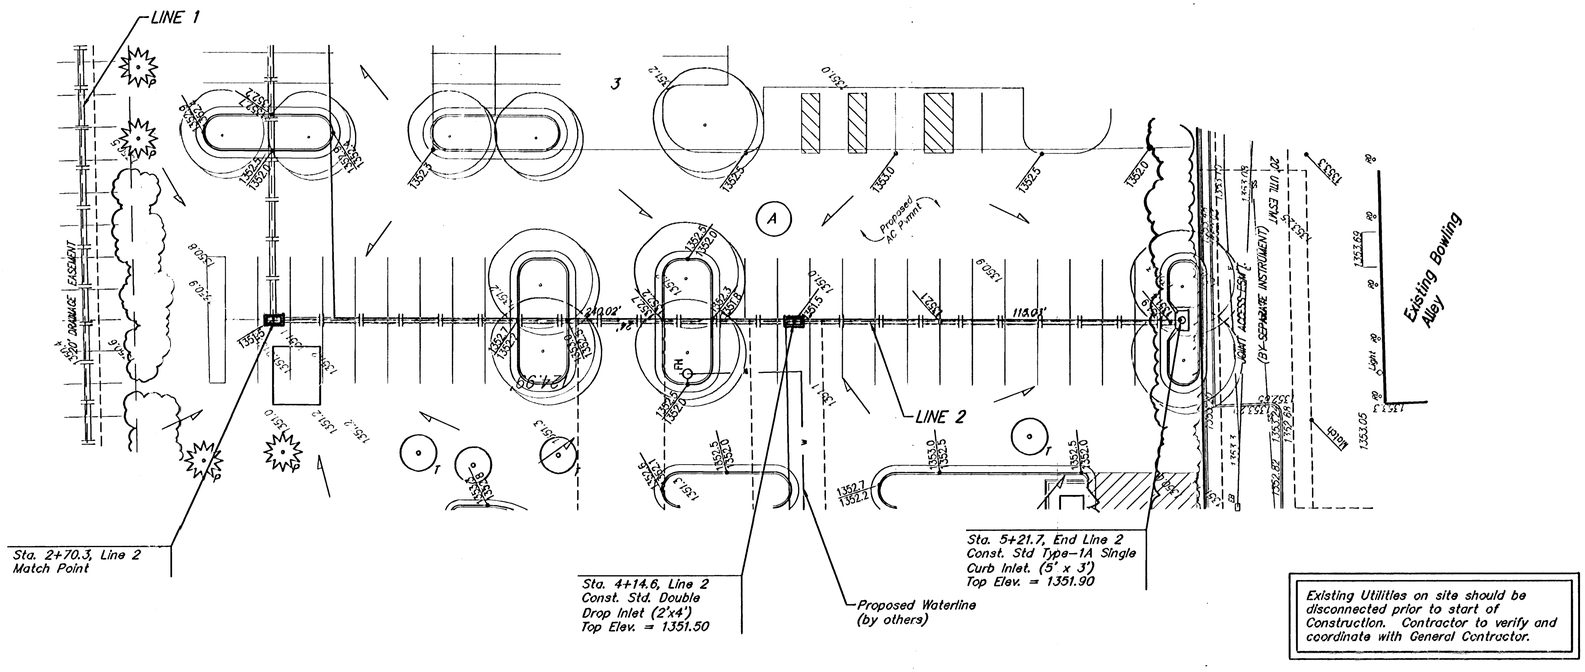

SCALE:
1" = 20' HORIZONTAL
1" = 5' VERTICAL
• = IRON

Existing Utilities on site should be disconnected prior to start of Construction. Contractor to verify and coordinate with General Contractor.

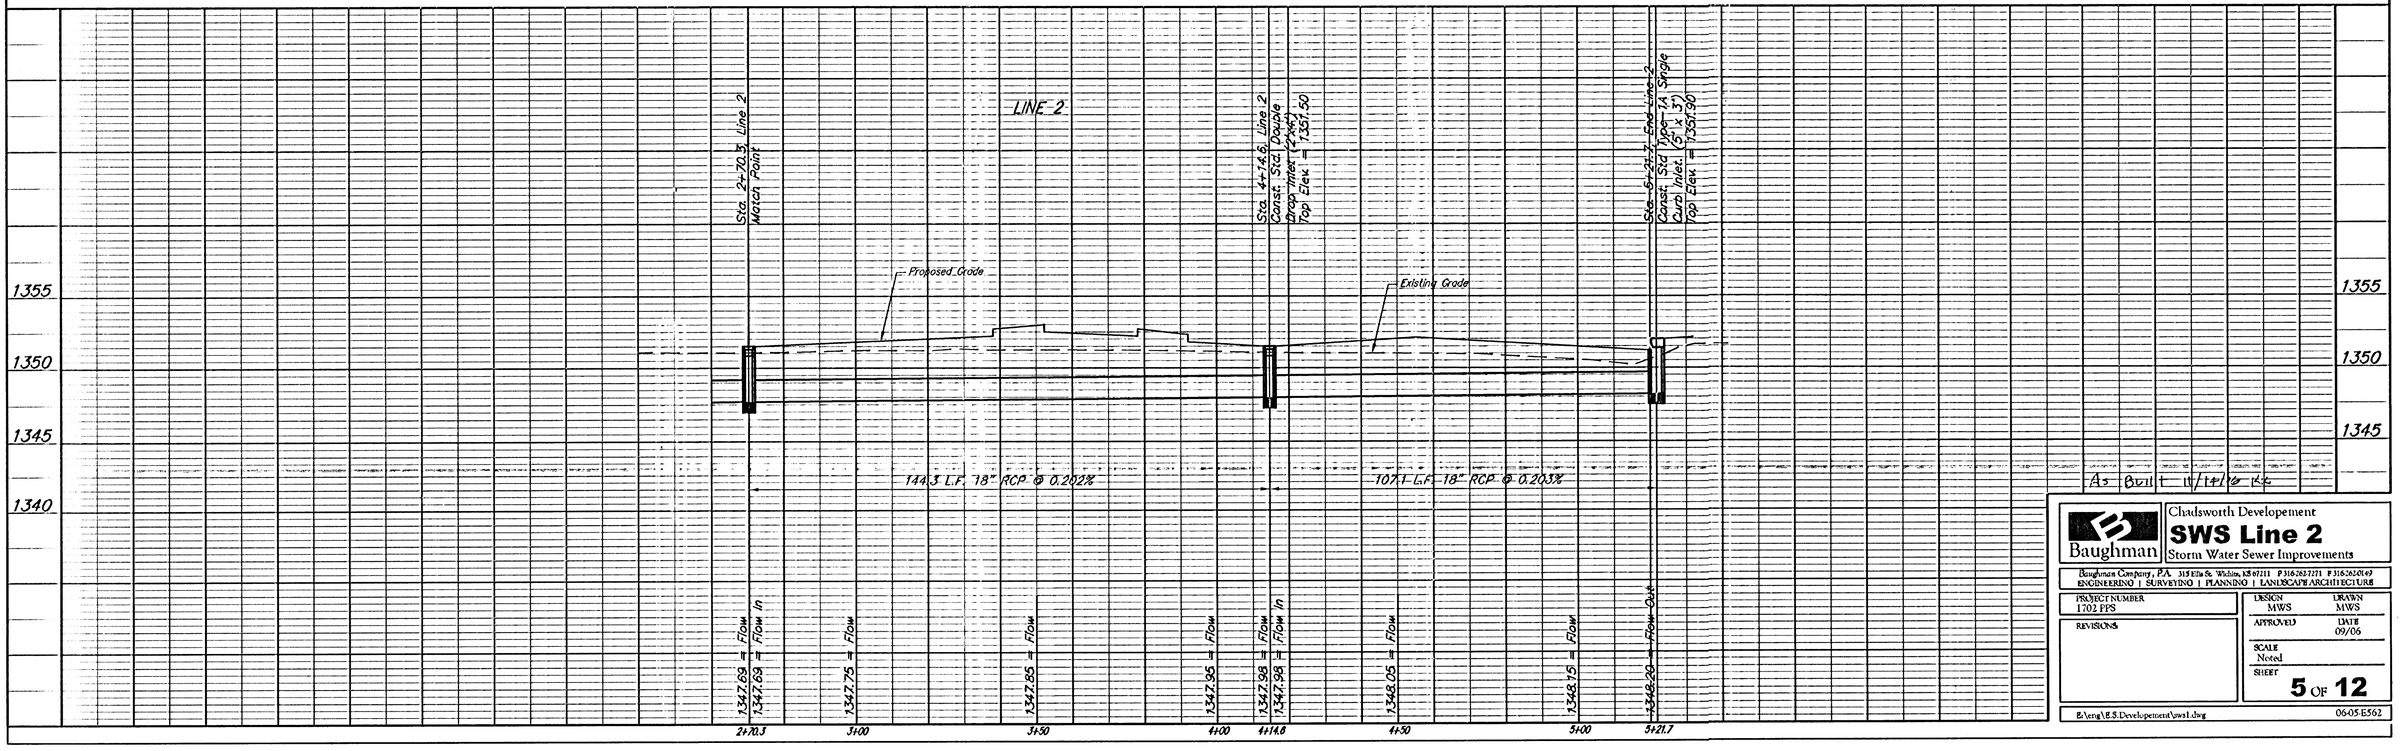


Baughman

Chadsworth Developement
SWS Line 2
Storm Water Sewer Improvements

Baughman Company, P.A. 315 Ella St. Wichita, KS 67211 P 316.265.7271 F 316.265.0549
ENGINEERING | SURVEYING | PLANNING | LANDSCAPE ARCHITECTURE

PROJECT NUMBER 1702 FPS
DESIGN MWS
DRAWN MWS
APPROVED
DATE 09/06
REVISIONS
SCALE Noted
SHEET 5 OF 12

E:\eng\E.S.Developement\sws1.dwg 06-05-E562