

BENCHMARK:
CITY OF WICHITA DISC – MAIZE RD. & STERLING, (2400 BLOCK N.), TOP OF CURB, WEST END OF MEDIAN ON C OF STERLING.
61' E. OF C OF MAIZE RD.
ELEV. = 1353.57 NGVD29


SMALL RAILROAD SPIKE IN E. FACE OF POWER POLE, 34.6' S. & 6.9' W. OF THE NW COR. OF LOT 2, BLOCK A.
ELEV. = 1351.99 NGVD29

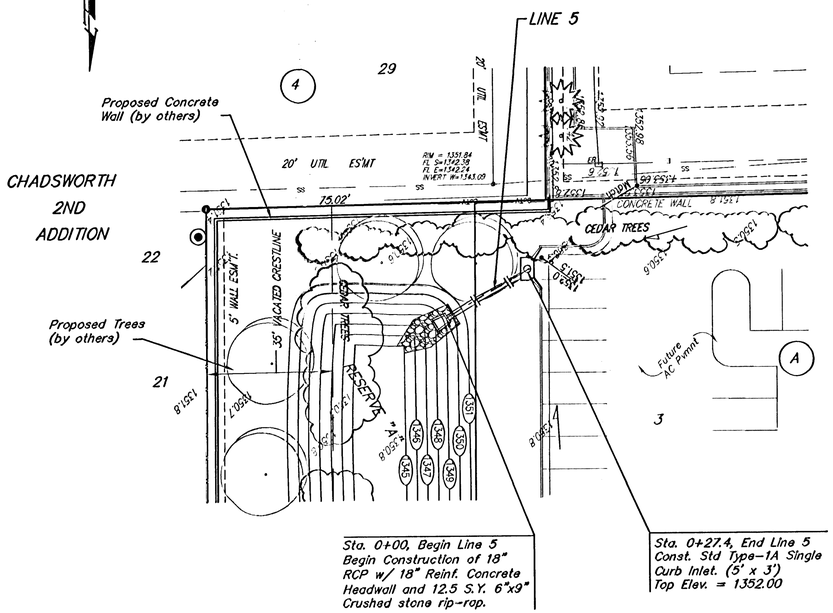

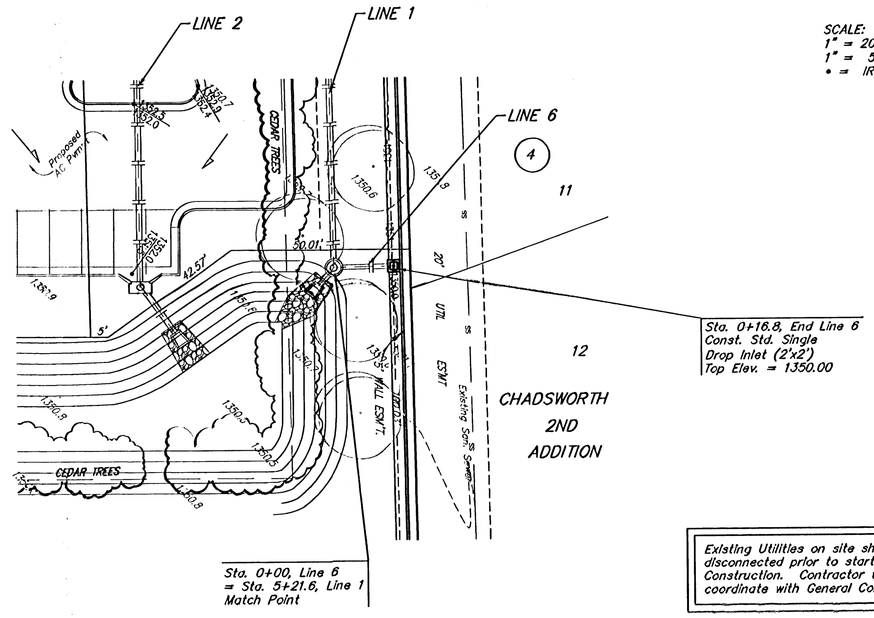

SCALE:
1" = 20' HORIZONTAL
1" = 5' VERTICAL
• = IRON

Existing Utilities on site should be disconnected prior to start of Construction. Contractor to verify and coordinate with General Contractor.

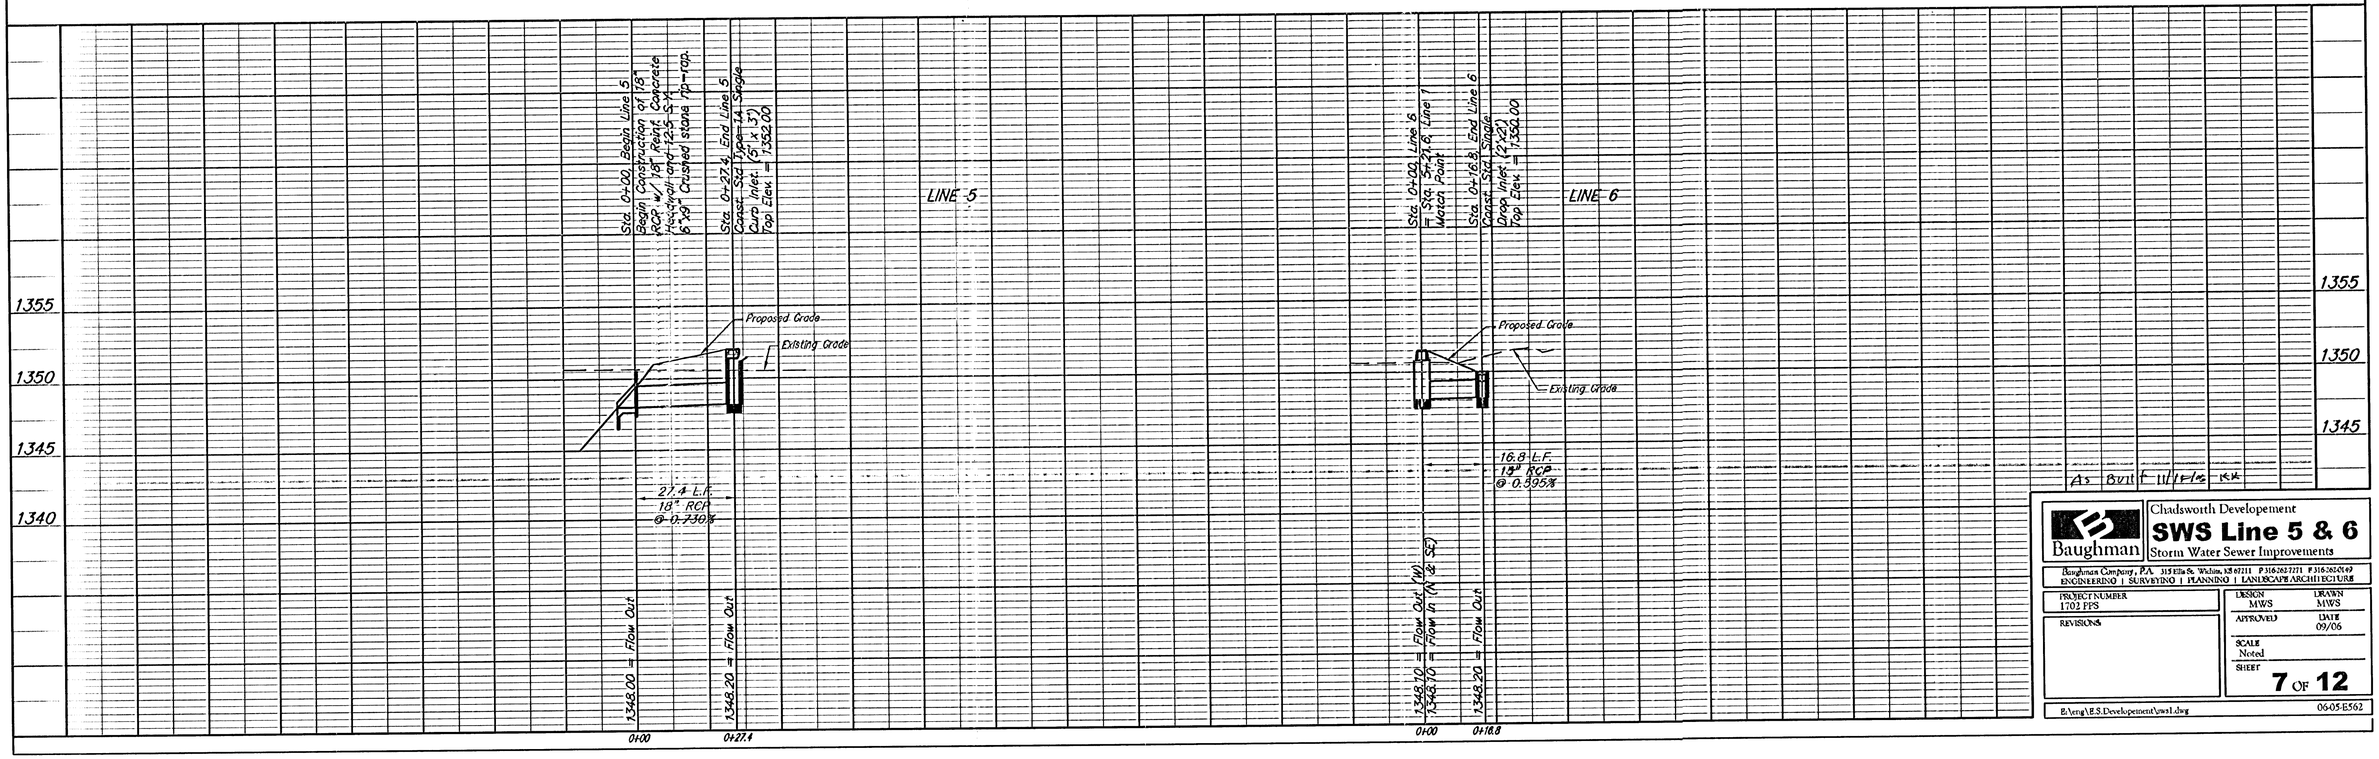

As Built 11/1/06 KK

Chadsworth Developement
SWS Line 5 & 6
Storm Water Sewer Improvements

Baughman

Baughman Company, P.A. 315 Ella St. Wichita, KS 67211 P 316.267.7271 F 316.267.0749
ENGINEERING | SURVEYING | PLANNING | LANDSCAPE ARCHITECTURE

PROJECT NUMBER 1702 PPS	DESIGN MWS / DRAWN MWS
REVISIONS	APPROVED / DATE 09/06
	SCALE Noted
	SHEET 7 OF 12

E:\eng\E.S.Developement\swsl.dwg 06-05-E562