

Bench Mark

R.R. Spike in HLP located at the N.E. Corner Lot 30, Block 1 Bay Country. Elev. = 154.44 (City Datum)

"□" Cut in Top of Curb located at the N.W. Corner Lot 45, Block 1 Bay Country. Elev. = 153.87 (City Datum)

Scale: 1" = 20'-0"
• = Iron

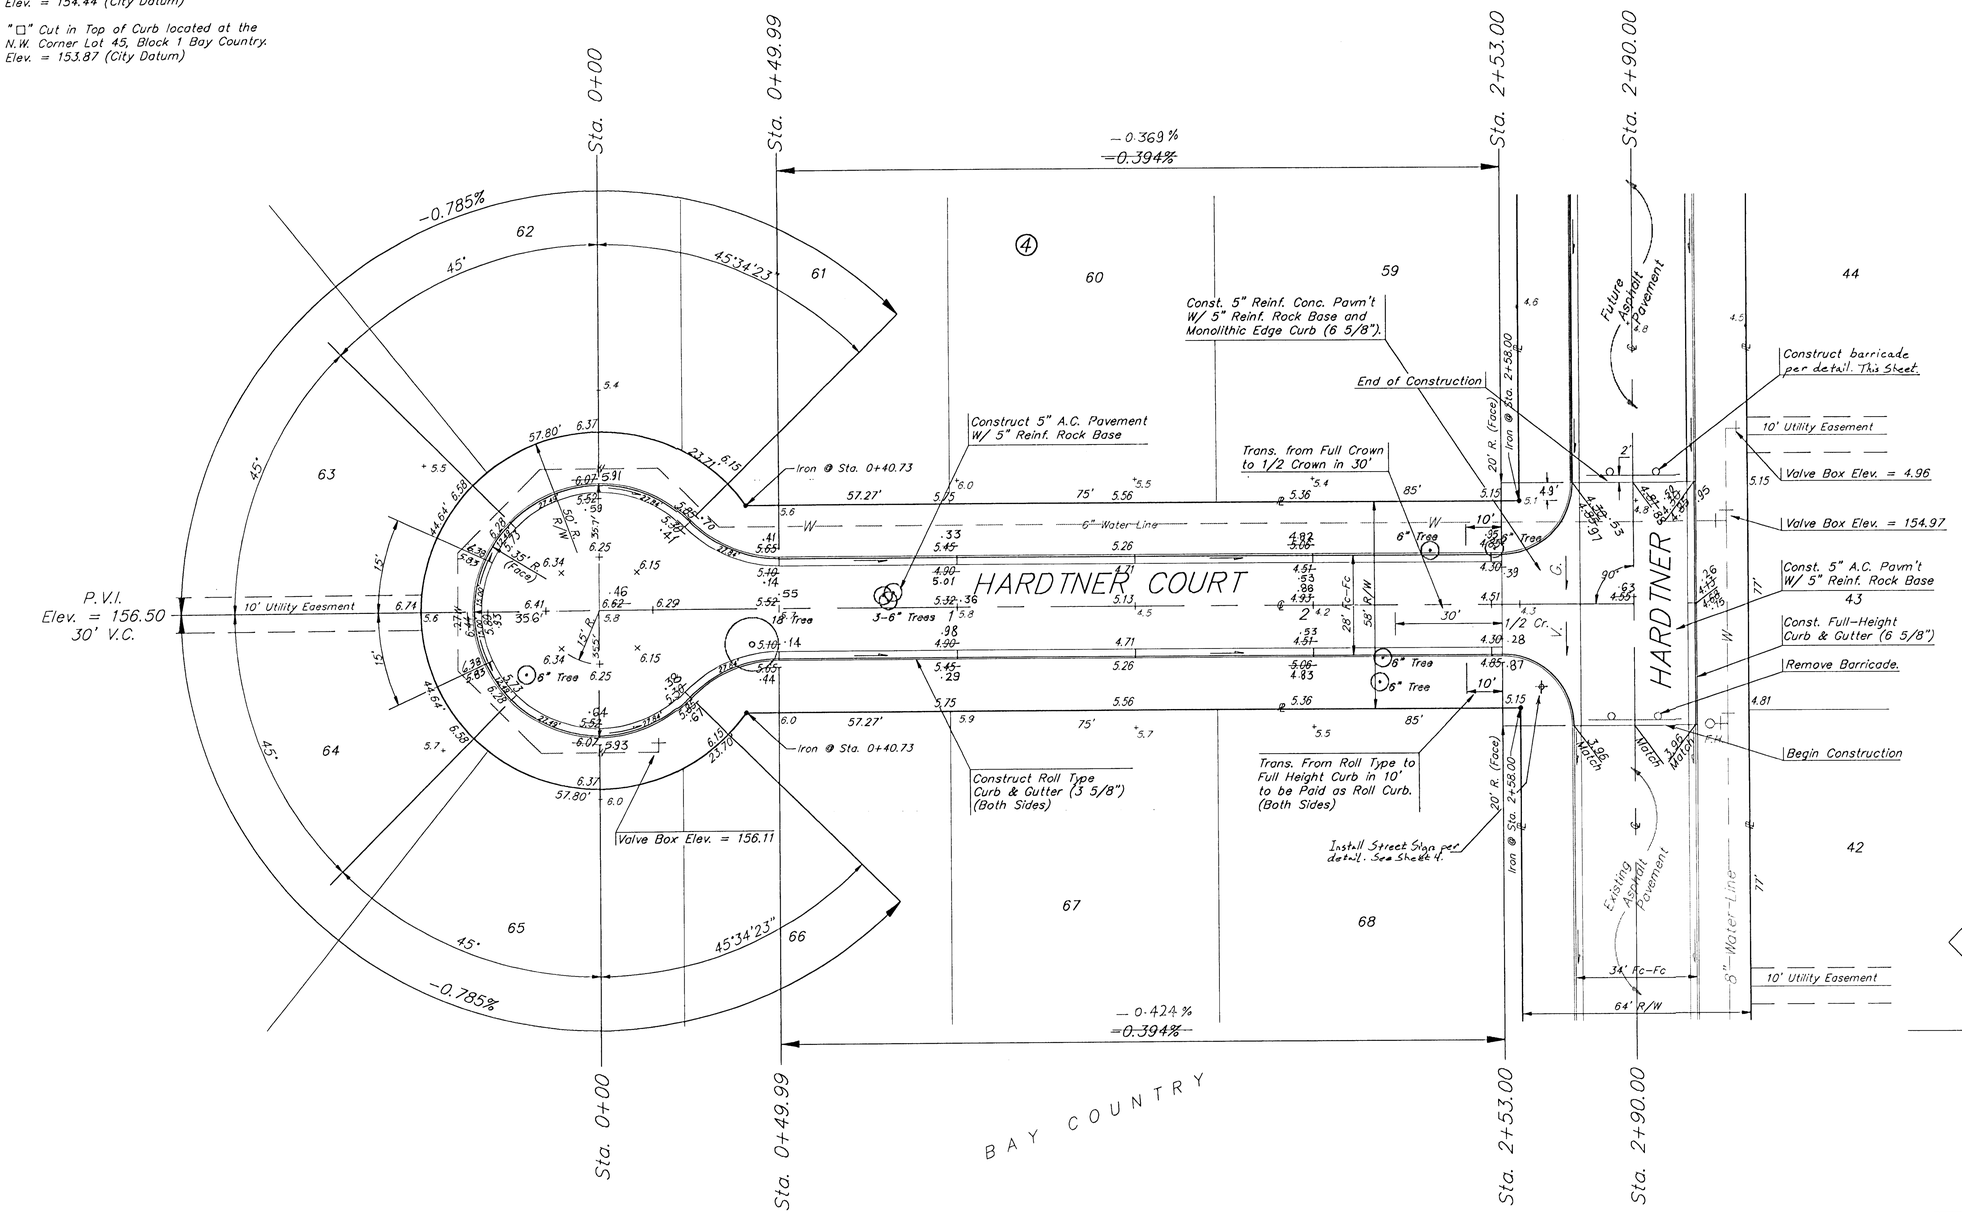

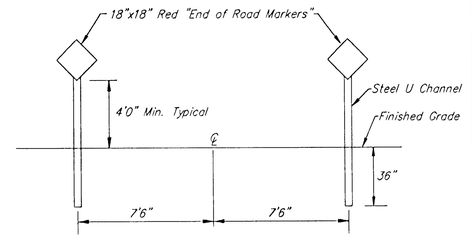

Barricade Detail

As Built 8-20-93 A.Z.

As Built 8-20-93

BAY COUNTRY – PHASE II
HARDTNER COURT

BAUGHMAN COMPANY P. A.
ENGINEERING & SURVEYING
316/262-7271 • 315 ELLIS • WICHITA, KANSAS 67211

PROJECT NUMBER				SHEET
077 PPP (607879)				3
DESIGN	DRAWN	UTIL. CHECK'D	DATE	SCALE	OF
B.P.	M.S.P.		April 1993	1" = 20'-0"	4

93-03-2491
baylsht