
B.M. - "I" CUT. TOP OF CURB AT N. END RETURN N.W. CORNER LINDEN AND DENKER CIRCLE ELEV. 209.17 CITY DATUM.

• = IRON

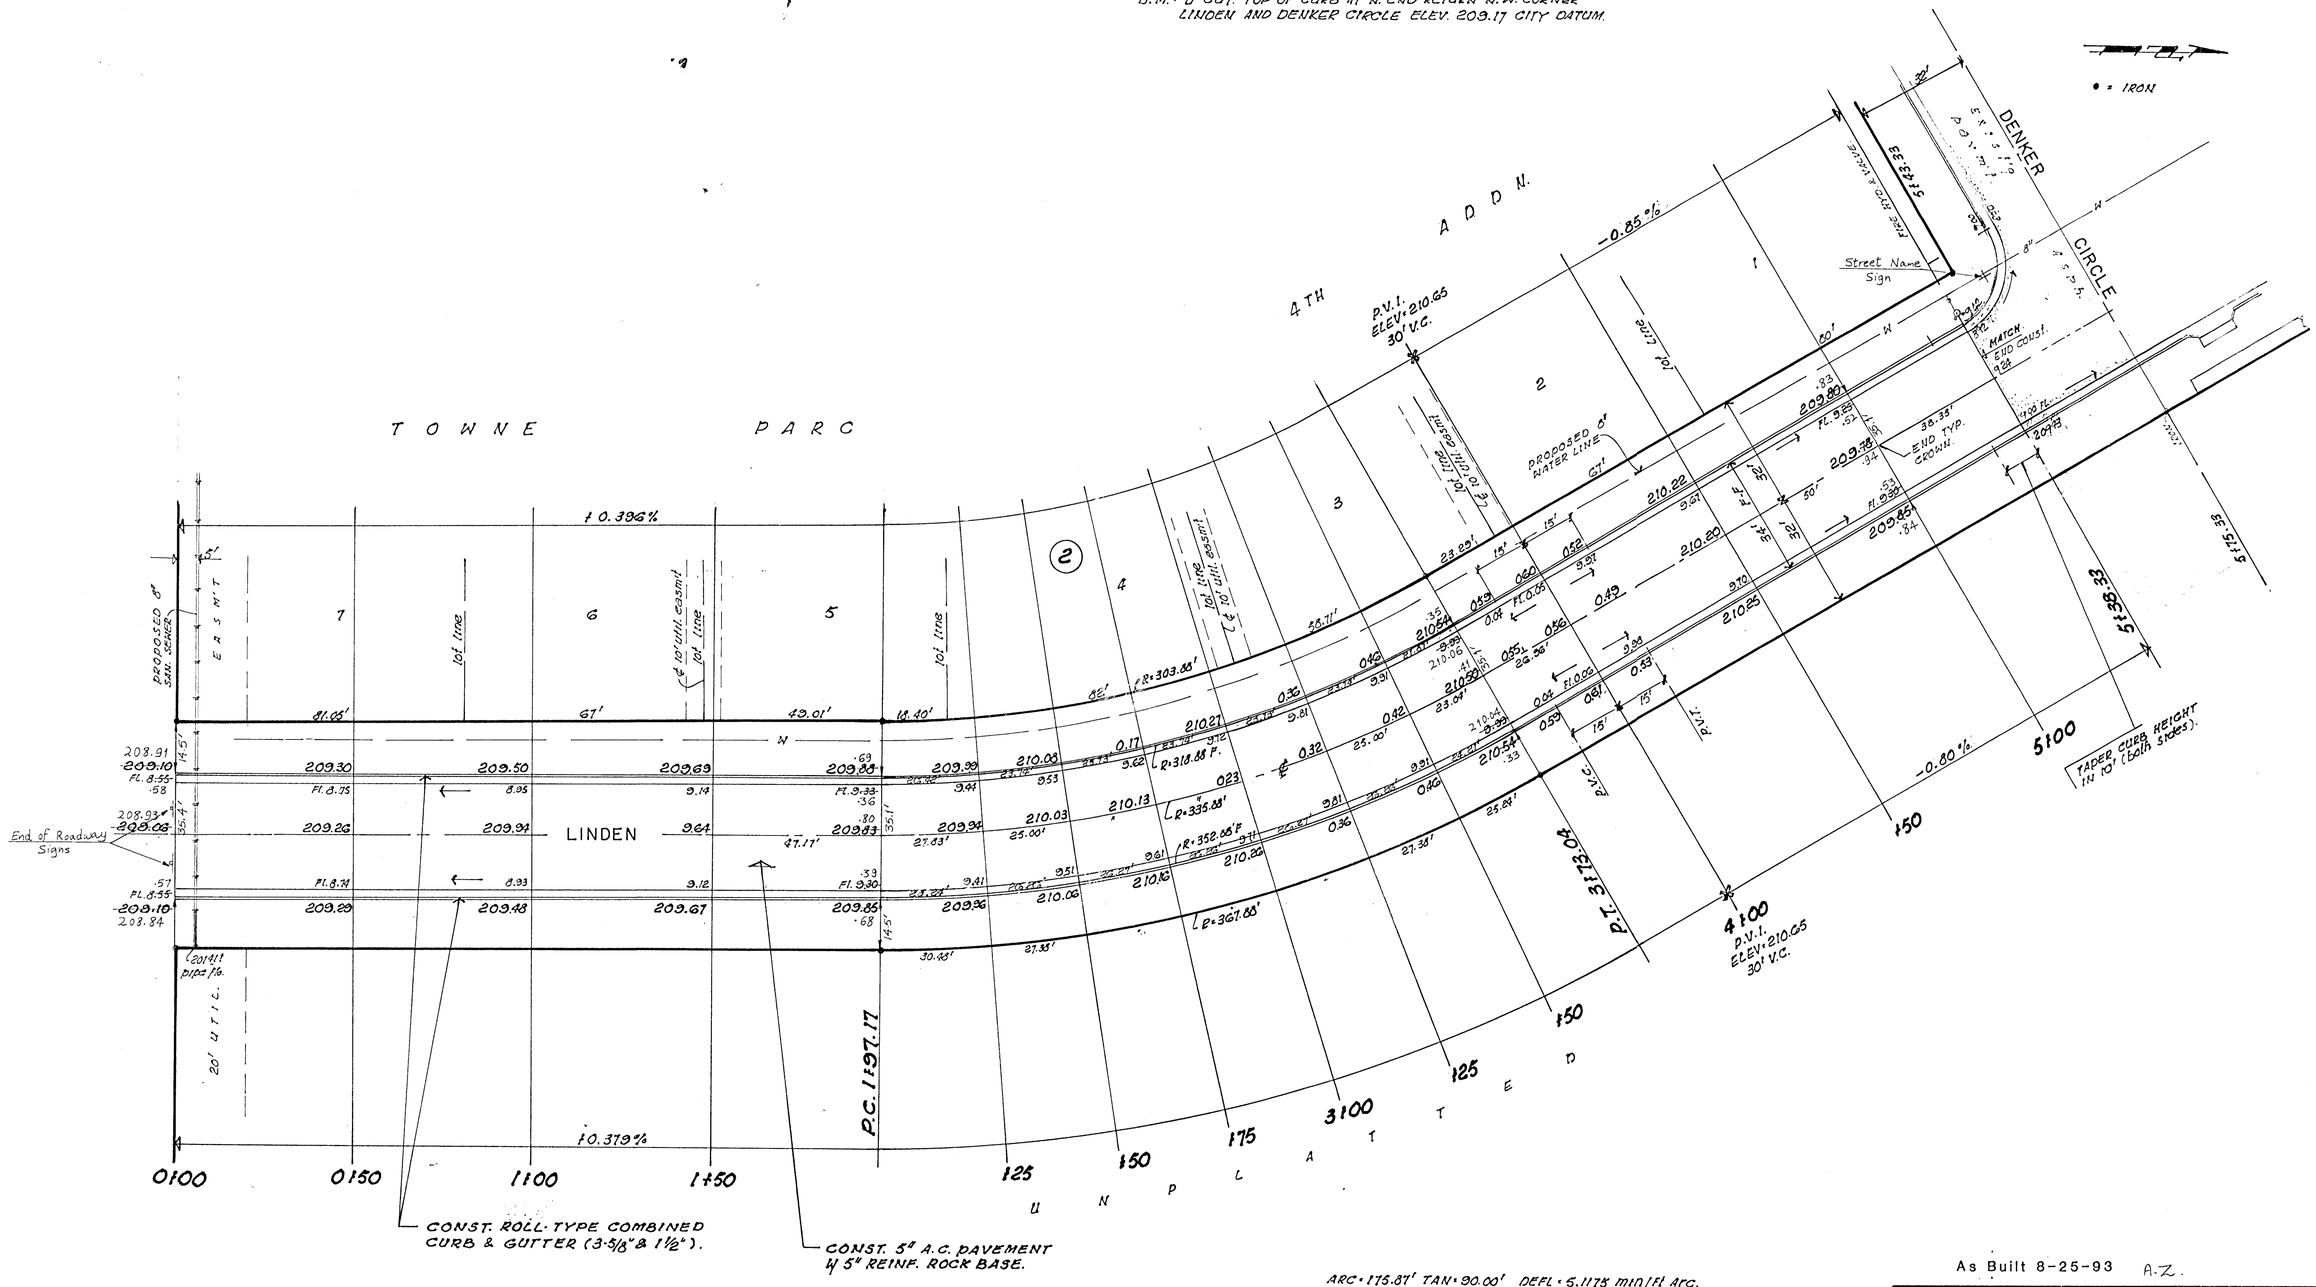

ARC = 175.87' TAN = 90.00' DEFL = 5.1175 min/Ft Arc.
CURVE DATA BASED ON CENTER LINE RADIUS 335.88' Δ = 30°

STATION	ARC.	8' O.S. FC. LT CB "CHORD"	8' O.S. FC. RT. CB. "CHORD"	DEFL.	TOTAL DEFLECTION
P.C. 1197.17					0° 00' 00"
2+25	27.83'	25.75'	29.89'	2° 22' 25"	2° 22' 25"
1+50	25.00'	23.13'	26.85'	2° 07' 56"	4° 30' 21"
1+75	"	"	"	"	6° 38' 17"
3+00	"	"	"	"	8° 46' 13"
1+25	"	"	"	"	10° 54' 09"
1+50	25.00'	23.13'	26.85'	2° 07' 56"	13° 02' 05"
P.T. 3+73.04	23.04'	21.32'	24.75'	1° 57' 55"	15° 00' 00"

EARTHWORK.
EXCAVATION = 2327.6 cu. YDS

As Built 8-25-93 A.Z.

TOWNE PARC 4TH ADDITION
STREET PAVEMENT PLAN

BAUGHMAN COMPANY P. A.
ENGINEERING & SURVEYING
316/262-7271 • 315 ELLIS • WICHITA, KANSAS 67211

PROJECT NUMBER 078 PPP (607879)

SHEET 4 OF 7

DESIGN	DRAWN	UTIL. CHECK'D	DATE	SCALE
				1" = 20'