
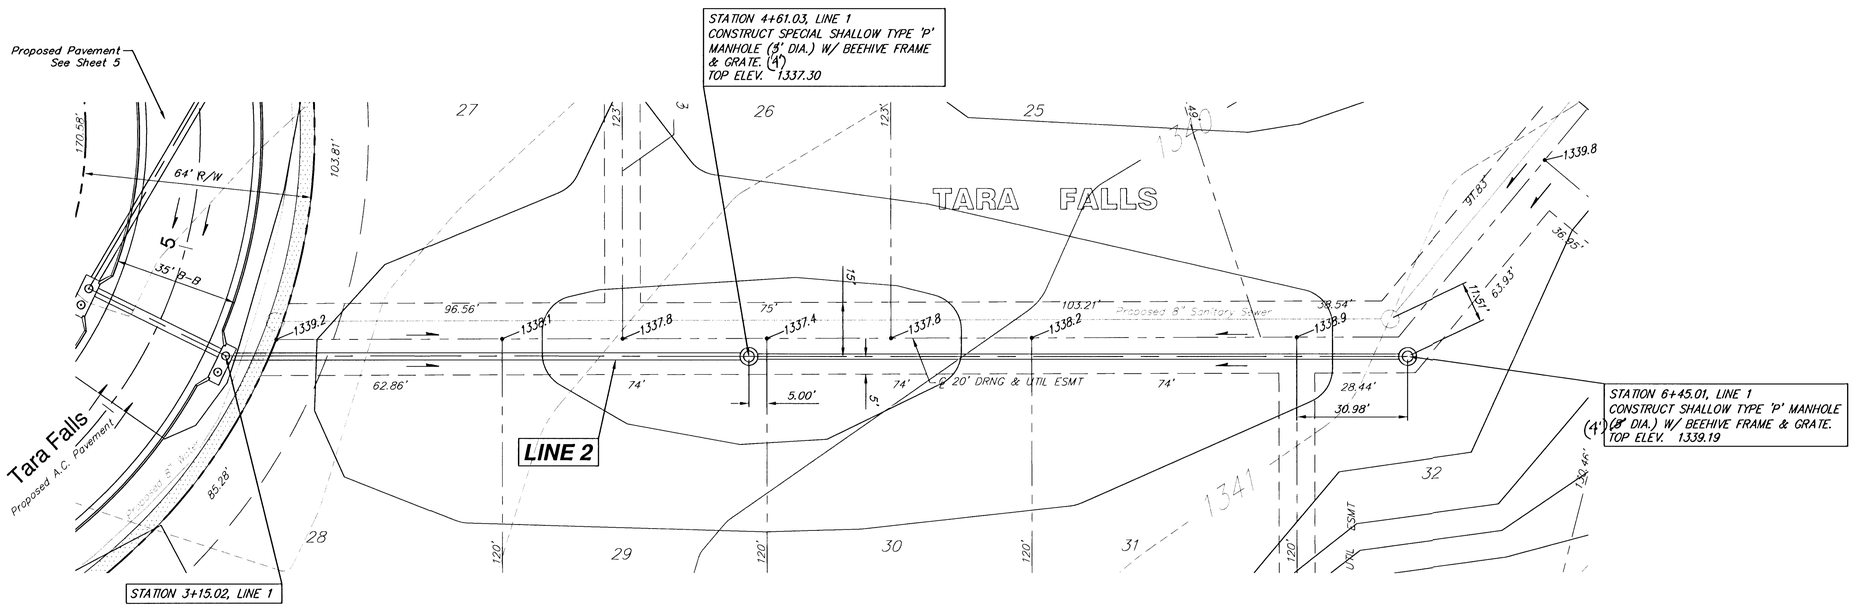


SCALE
1" = 20' Horiz. (Plan & Profile)
1" = 5' Vert. (Profile)

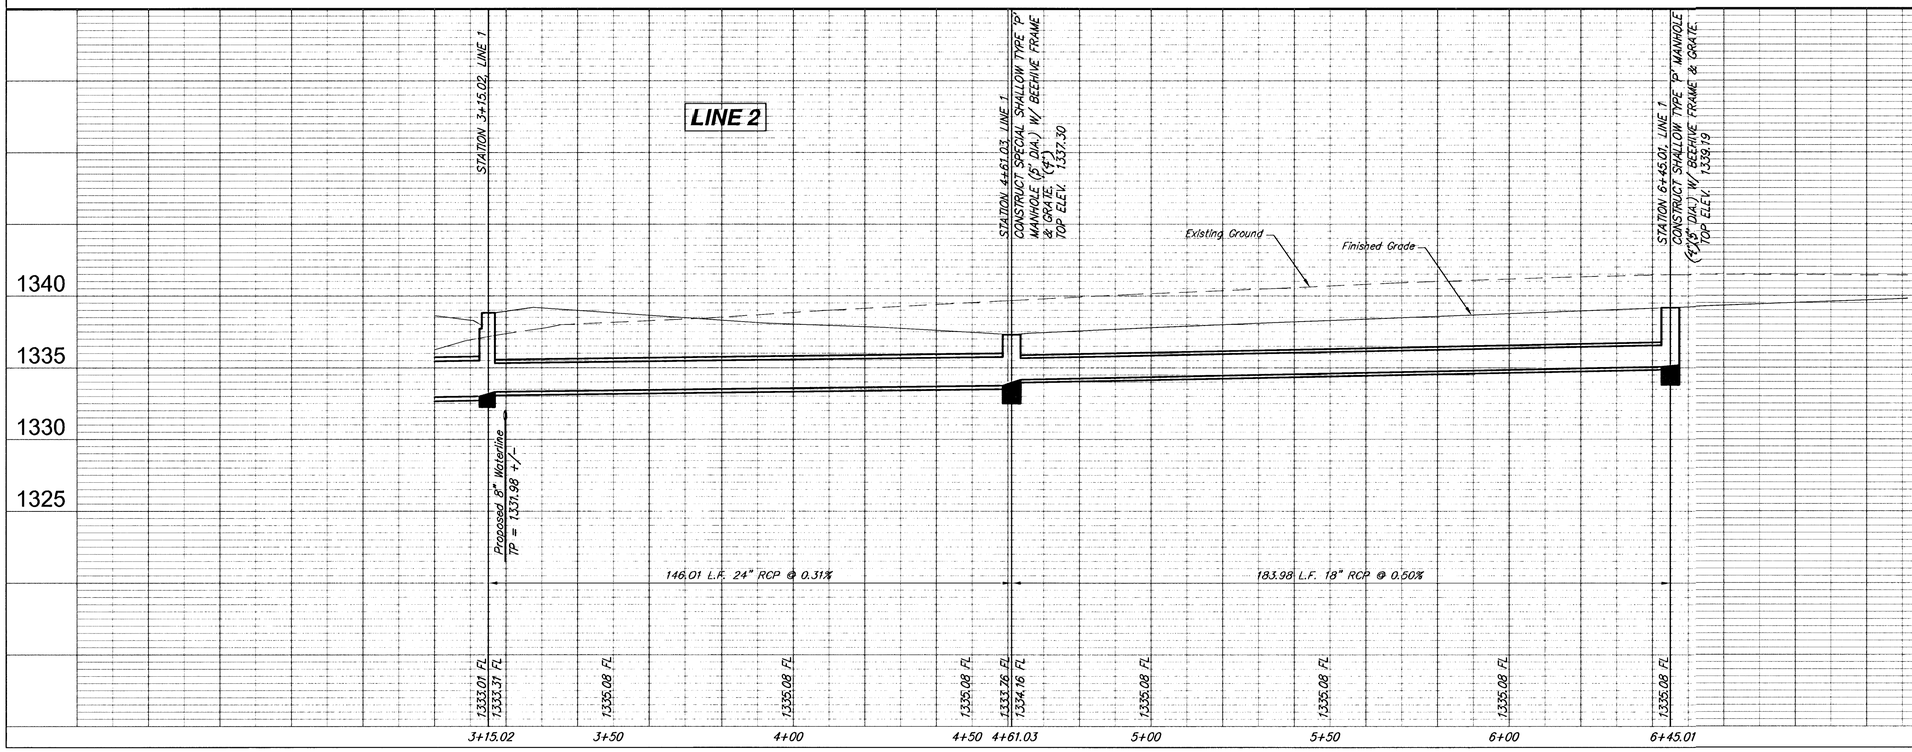

DESIGN MWS
DRAWN MWS
CHECKED
DATE 12/03/02
REVISED
REVIEW

PROJECT NUMBER 472-83648
DRAWING FILE Phase 3 Pav...\Paving.dwg

Tara Falls - Phase 3 SWS
Line 2
WICHITA, KANSAS

Ruggles & Bohm, P.A.
Engineering, Surveying, Land Planning
924 North Main
Wichita, Kansas 67203
www.rbkansas.com
(316) 264-8008
(316) 264-4621 fax
E-mail: info@rbkansas.com

RB JOB 2111 E
SHEET 15 OF 35