


Drawing Name: i:\1999\99127\chapel2.dgn
 Date Plotted: 8-2-99

NO.	FINAL SURVEY PLOTTED	BY	DATE

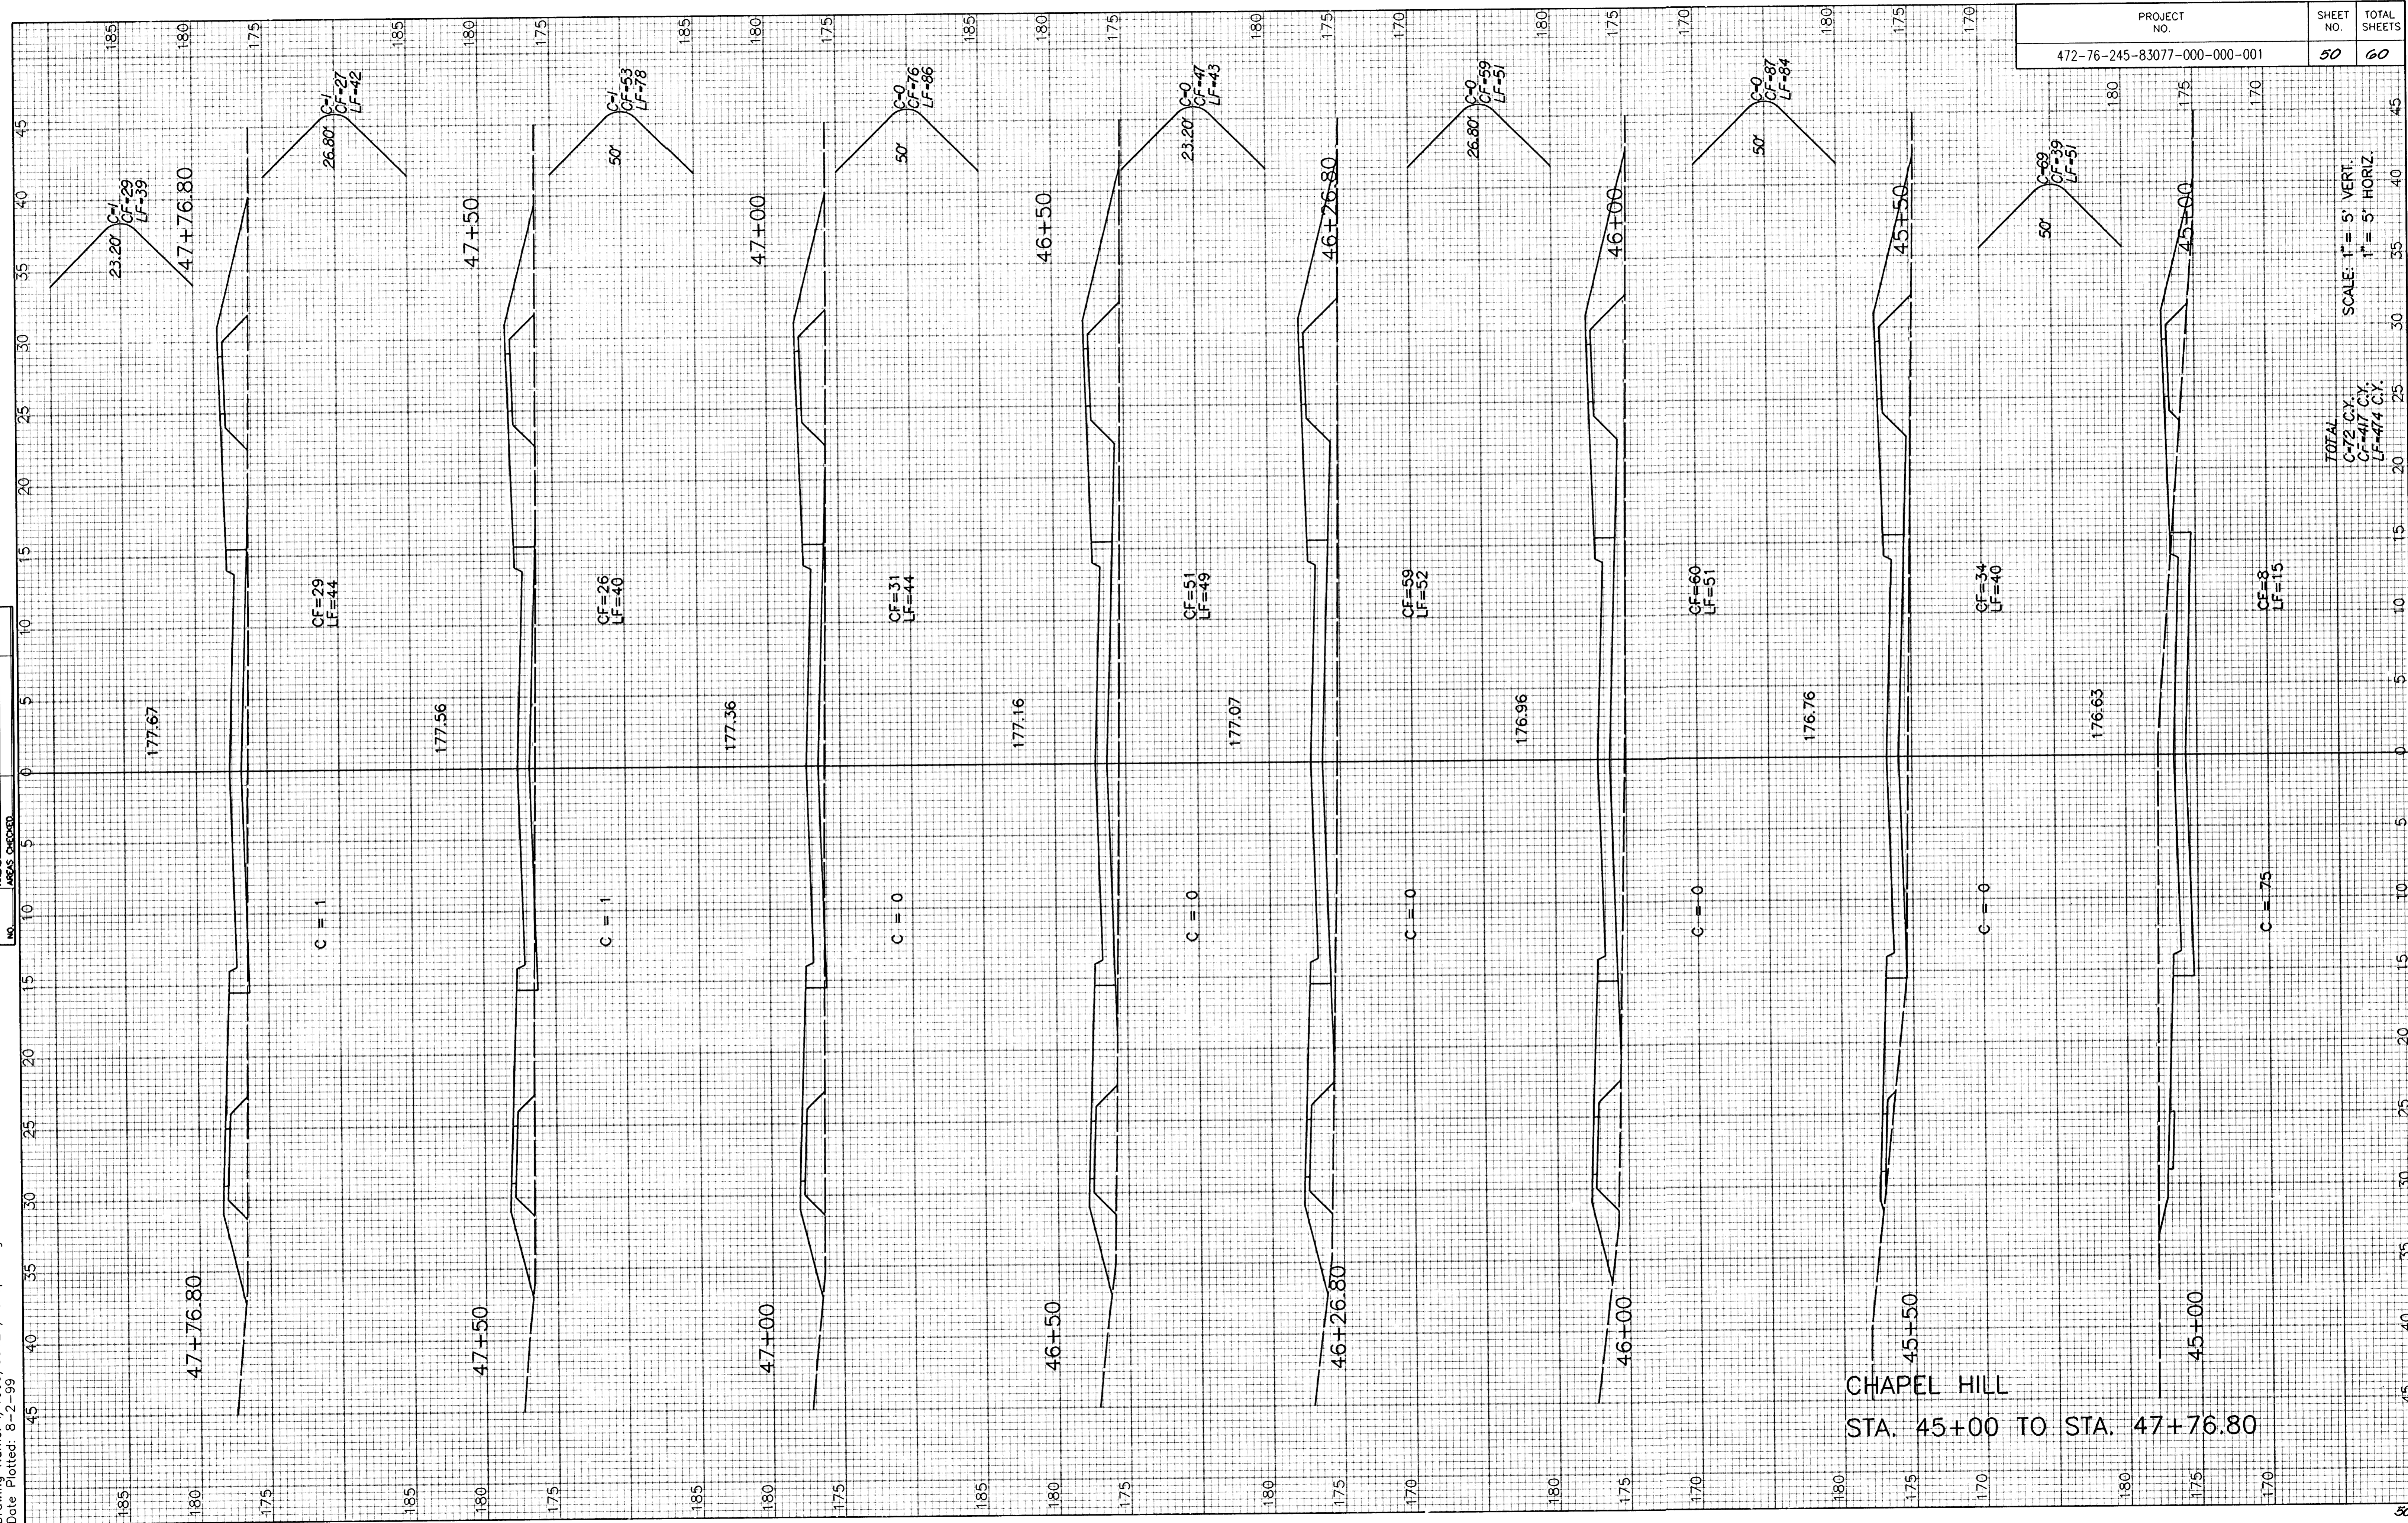

CHAPEL HILL
 STA. 45+00 TO STA. 47+76.80

TOTAL
 C-72 C.Y.
 C-417 C.Y.
 LF-474 C.Y.

SCALE: 1" = 5' VERT.
 1" = 5' HORIZ.