


CONTROL POINTS			
Point #	Northing	Easting	Description
1	7,380.00	20,035.75	W1/4GRBR5
2	10,000.00	20,000.00	NWSCARBR
3	10,042.82	22,641.78	N1/4GRBR5
4	7,385.08	22,671.19	CENTER/2IP
9	7,383.01	21,358.40	PIN 1-NOT 1/16
20	8,832.91	20,065.94	BRS
21	8,842.34	20,645.79	IP3/4
22	8,442.34	20,651.35	IP3/APEC
23	8,436.06	20,267.01	IP3/APEC
24	7,904.30	20,274.31	IP3/4
30	8,832.60	20,045.92	IP3/4
56	7,381.83	20,951.81	IRON
57	7,831.54	20,950.94	IRON
58	7,800.33	21,069.61	IRON
59	7,858.26	21,084.84	IRON
60	8,050.76	21,135.48	IRON
61	8,771.45	21,125.64	IRON
62	8,776.51	21,502.10	IRON
63	8,795.15	21,511.27	IRON
64	8,838.90	21,572.19	IRON
65	8,795.53	21,624.56	IRON
66	8,778.93	21,682.22	IRON
67	8,788.81	22,417.15	IRON
68	8,879.73	22,462.64	IRON
69	8,881.28	22,602.63	IRON
70	8,881.63	22,634.63	IRON
71	8,881.86	22,654.62	IRON
72	7,384.80	22,519.81	IRON
73	7,384.70	22,461.81	IRON
74	7,382.64	21,353.42	1/16
75	7,787.99	21,116.52	IRON
76	7,762.78	21,107.73	IRON
77	7,766.06	21,170.30	IRON
78	7,743.69	21,162.50	IRON
79	7,691.18	21,103.87	IRON
80	7,704.28	21,160.37	IRON
81	7,617.45	21,163.58	IRON
82	7,626.35	21,106.27	IRON
83	7,612.02	21,104.04	IRON
84	7,603.13	21,161.36	IRON
85	7,843.63	21,144.09	IRON
86	7,793.71	21,254.00	IRON
87	7,739.70	21,219.65	IRON
88	7,736.64	21,433.75	IRON
89	7,672.72	21,430.67	IRON
90	7,672.30	21,439.25	IRON
91	7,669.50	21,497.26	IRON
92	7,523.44	21,439.54	IRON
93	7,523.55	21,497.54	IRON
94	7,723.65	21,702.73	IRON
95	7,659.72	21,699.64	IRON
96	7,657.83	21,776.28	IRON
97	7,658.78	21,834.28	IRON
98	7,524.09	21,776.54	IRON
99	7,524.20	21,834.54	IRON
100	7,739.42	22,012.62	IRON
101	7,676.14	22,022.18	IRON
102	7,688.45	22,110.31	IRON
103	7,698.12	22,167.66	IRON
104	7,608.75	22,116.37	IRON
105	7,609.86	22,174.37	IRON
106	7,701.27	22,188.54	IRON
107	7,764.55	22,178.98	IRON
108	7,806.05	22,398.74	IRON
109	7,849.66	22,436.98	IRON
110	7,824.77	22,465.36	IRON
111	7,781.16	22,427.12	IRON
112	7,706.17	22,461.19	IRON
113	7,706.28	22,519.19	IRON
114	8,082.50	22,449.46	IRON

CONTROL POINTS			
Point #	Northing	Easting	Description
115	8,083.21	22,513.45	IRON
116	8,153.18	22,448.67	IRON
117	8,211.18	22,448.03	IRON
118	8,519.99	22,444.62	IRON
119	8,520.71	22,508.61	IRON
120	8,202.20	21,780.17	IRON
121	8,144.86	21,830.30	IRON
122	8,639.46	21,722.42	IRON
123	8,581.46	21,723.20	IRON
124	8,590.20	22,372.66	IRON
125	8,648.27	22,377.88	IRON
126	8,617.50	22,463.26	IRON
127	8,593.88	22,484.86	IRON
128	8,623.68	22,518.45	IRON
129	8,647.62	22,497.21	IRON
130	8,676.01	22,560.32	IRON
131	8,644.24	22,564.15	IRON
132	8,726.56	22,636.34	IRON
133	8,726.21	22,604.34	IRON
400	7,833.67	20,053.67	N

WTR POINTS			
Point #	Northing	Easting	Description
6002	8,693.82	22,643.70	0+00
6004	8,653.85	22,604.70	Bend
6005	8,626.04	22,539.82	Bend
6006	8,589.74	22,489.69	FH
6007	8,558.84	22,443.25	TEE
6008	8,551.02	22,451.27	Bend
6009	8,400.02	22,452.94	DEFL
6010	8,371.40	22,451.26	DEFL
6011	8,351.40	22,451.48	DEFL
6012	8,342.76	22,452.19	VLV
6013	8,322.82	22,453.80	BO
6014	8,596.63	22,404.53	Bend
6015	8,591.57	22,028.79	FH
6016	8,587.36	21,715.58	Bend
6017	8,570.41	21,699.08	BEND
6018	8,569.97	21,666.17	Bend
6019	8,592.93	21,642.59	Bend
6020	8,625.83	21,642.14	Bend
6021	8,649.42	21,665.10	Bend
6022	8,649.99	21,708.10	BO

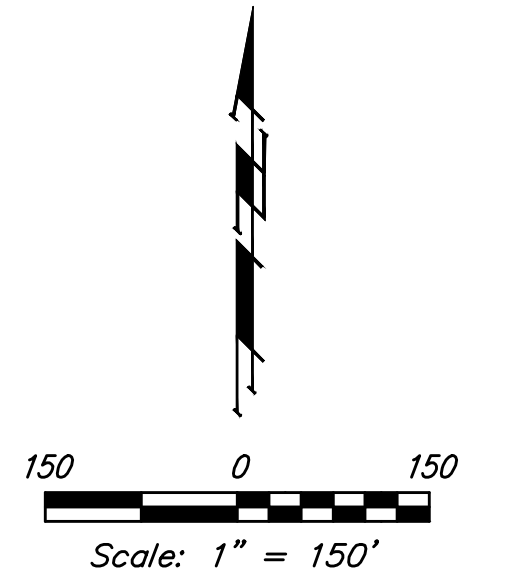

BENCHMARKS:
 City of Wichita Benchmark Disk
 34.9' S. & 31.2' W. of the SW Cor.,
 NW1/4, Sec. 2, Twp. 27-S, R-1-W.
 Elev. = 1327.57 NAVD88

"X" cut in top of curb inlet face
 north side of 26th ST N,
 129' west & 21' north of the
 southwest corner of Lot 1, Block B,
 Sandcrest 4th Addn.
 Elev. = 1324.00 NAVD88

"□" cut in top of curb adjacent
 to the southwest corner of Lot 4,
 Block C, Sandcrest 3rd Addn.
 Elev. = 1328.86 NAVD88



Baughman Sandcrest 4th Addition - Phase II
COORDINATES
 Water Distribution System

Baughman Company, P.A. 315 Ellis St. Wichita, KS 67211 P 316-262-7271 F 316-262-0149
 ENGINEERING | SURVEYING | PLANNING | LANDSCAPE ARCHITECTURE

PROJECT NUMBER 448-90897	DESIGN AEG	DRAWN JAK
REVISIONS:	APPROVED	DATE 2/26/19
	SCALE Noted	SHEET 12 OF 13