PROJECT NO.	SHEET NO.	TOTAL SHEETS
472-83376	8R	50

SCALE: 1"=20'

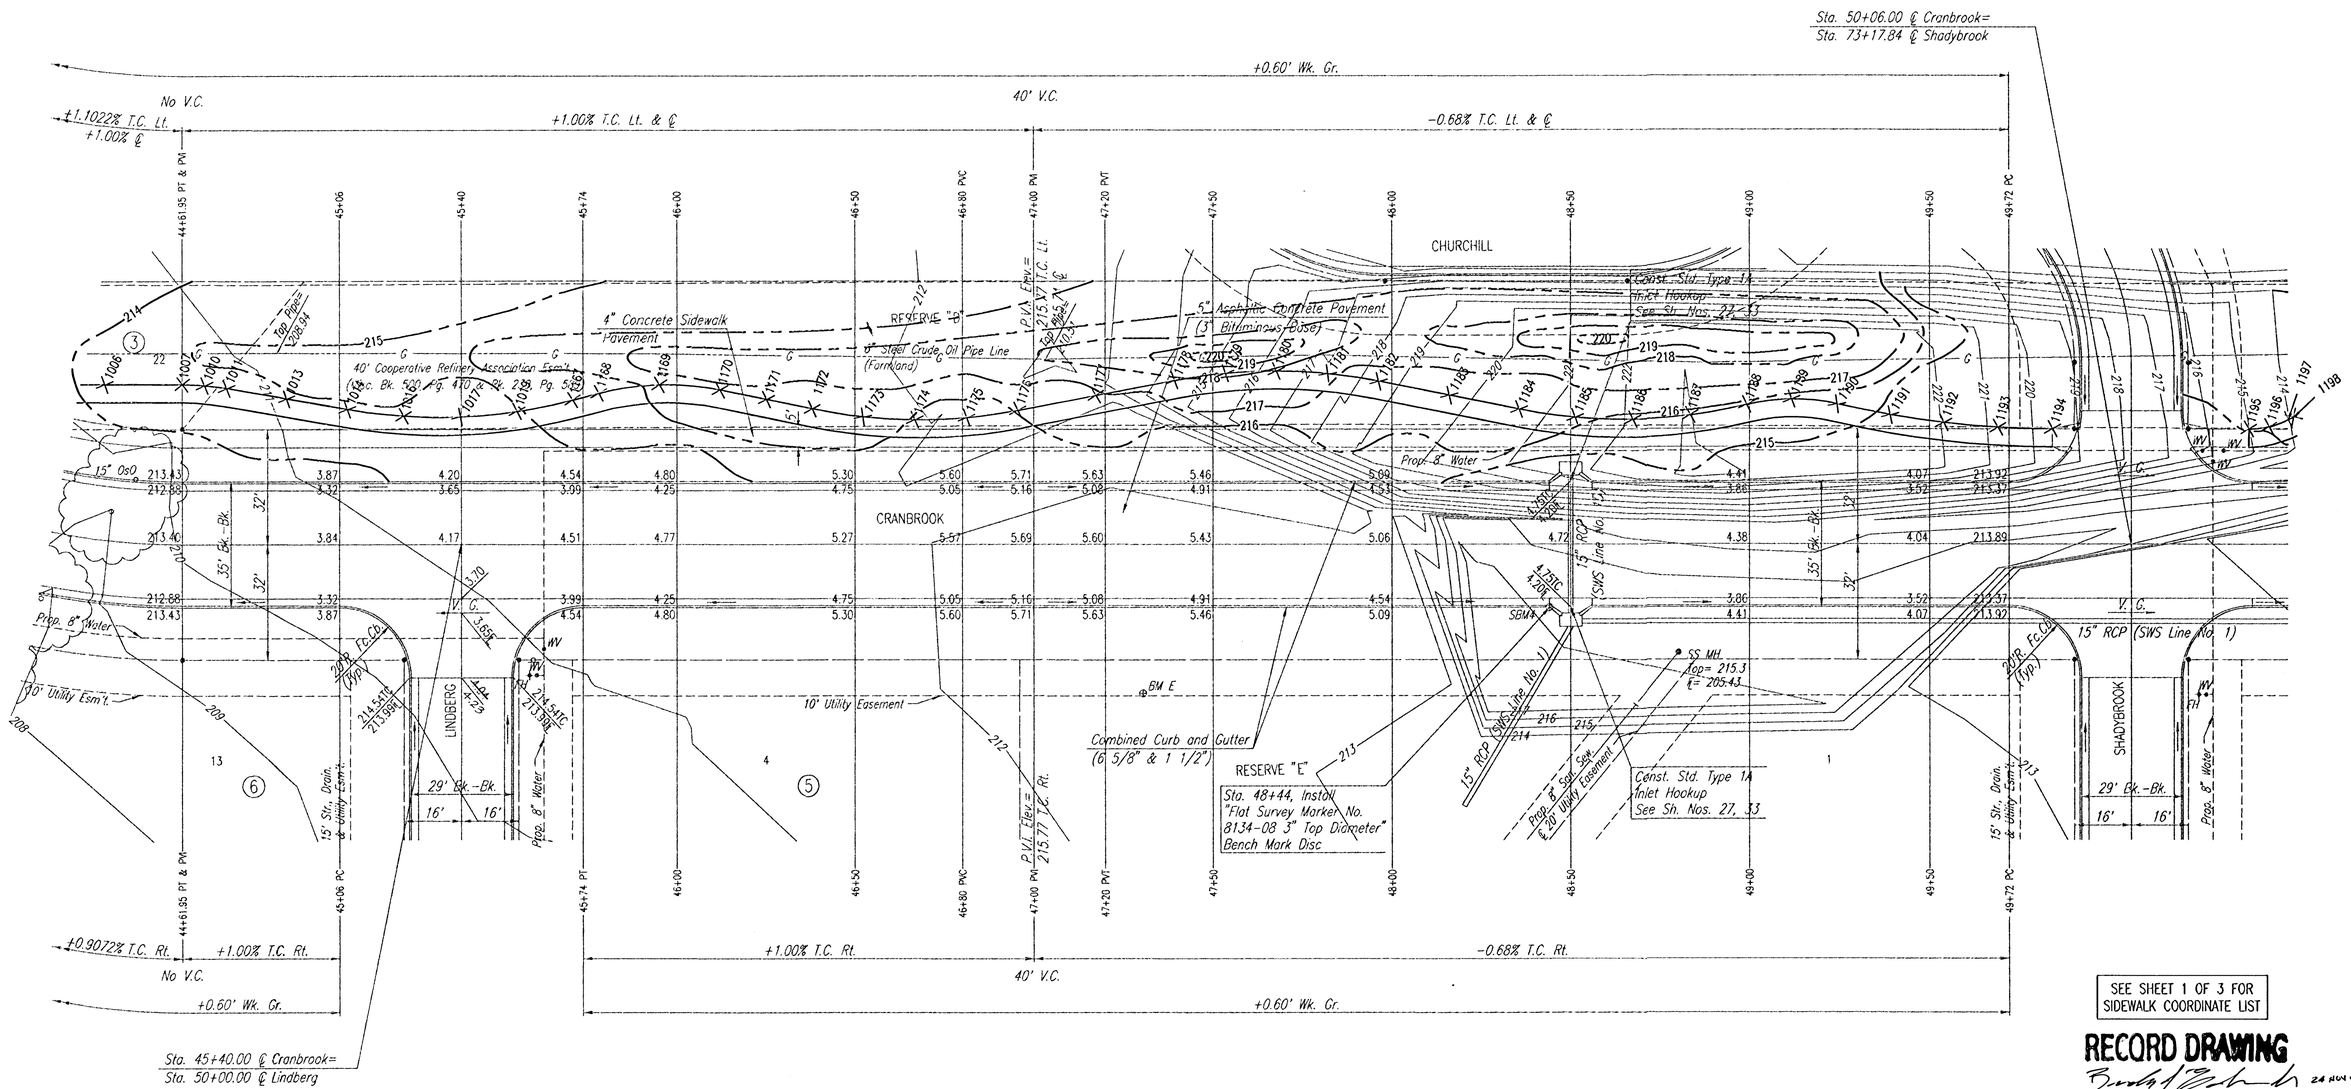

SEE SHEET 1 OF 3 FOR SIDEWALK COORDINATE LIST

RECORD DRAWING

24 NOV 03

REMINGTON PLACE - PHASE 2

CRANBROOK

STA. 44+61.95 TO STA. 49+72.00
(REVISED WALK)
SHEET 2 of 3

Professional Engineering Consultants, P.A.
303 S. TOPEKA • WICHITA, KANSAS 67202
316-262-2691 • FAX 316-262-3003

Designed by	BER	Checked by	
Drawn by	DEP	Date DEC., 2002	Job No. 02398

DSNR: BER OPER: TLS SCALE: 1=20.00
Q:\2002\02398\000\CRANBROOKS2-Walk rev 11-20-2003 04:04:47 pm