
PROJECT NO.	SHEET NO.	TOTAL SHEETS
472-83376	11	50

WATER VALVE BOX ELEVATIONS			
STREET	STATION	OFFSET	PROPOSED ELEVATION
19TH STREET NORTH	65+02.44	23.0'Lt.	210.1
19TH STREET NORTH	65+05.44	26.0'Lt.	210.0
19TH STREET NORTH	69+78.44	24.0'Lt.	211.9

SCALE: 1"=20'

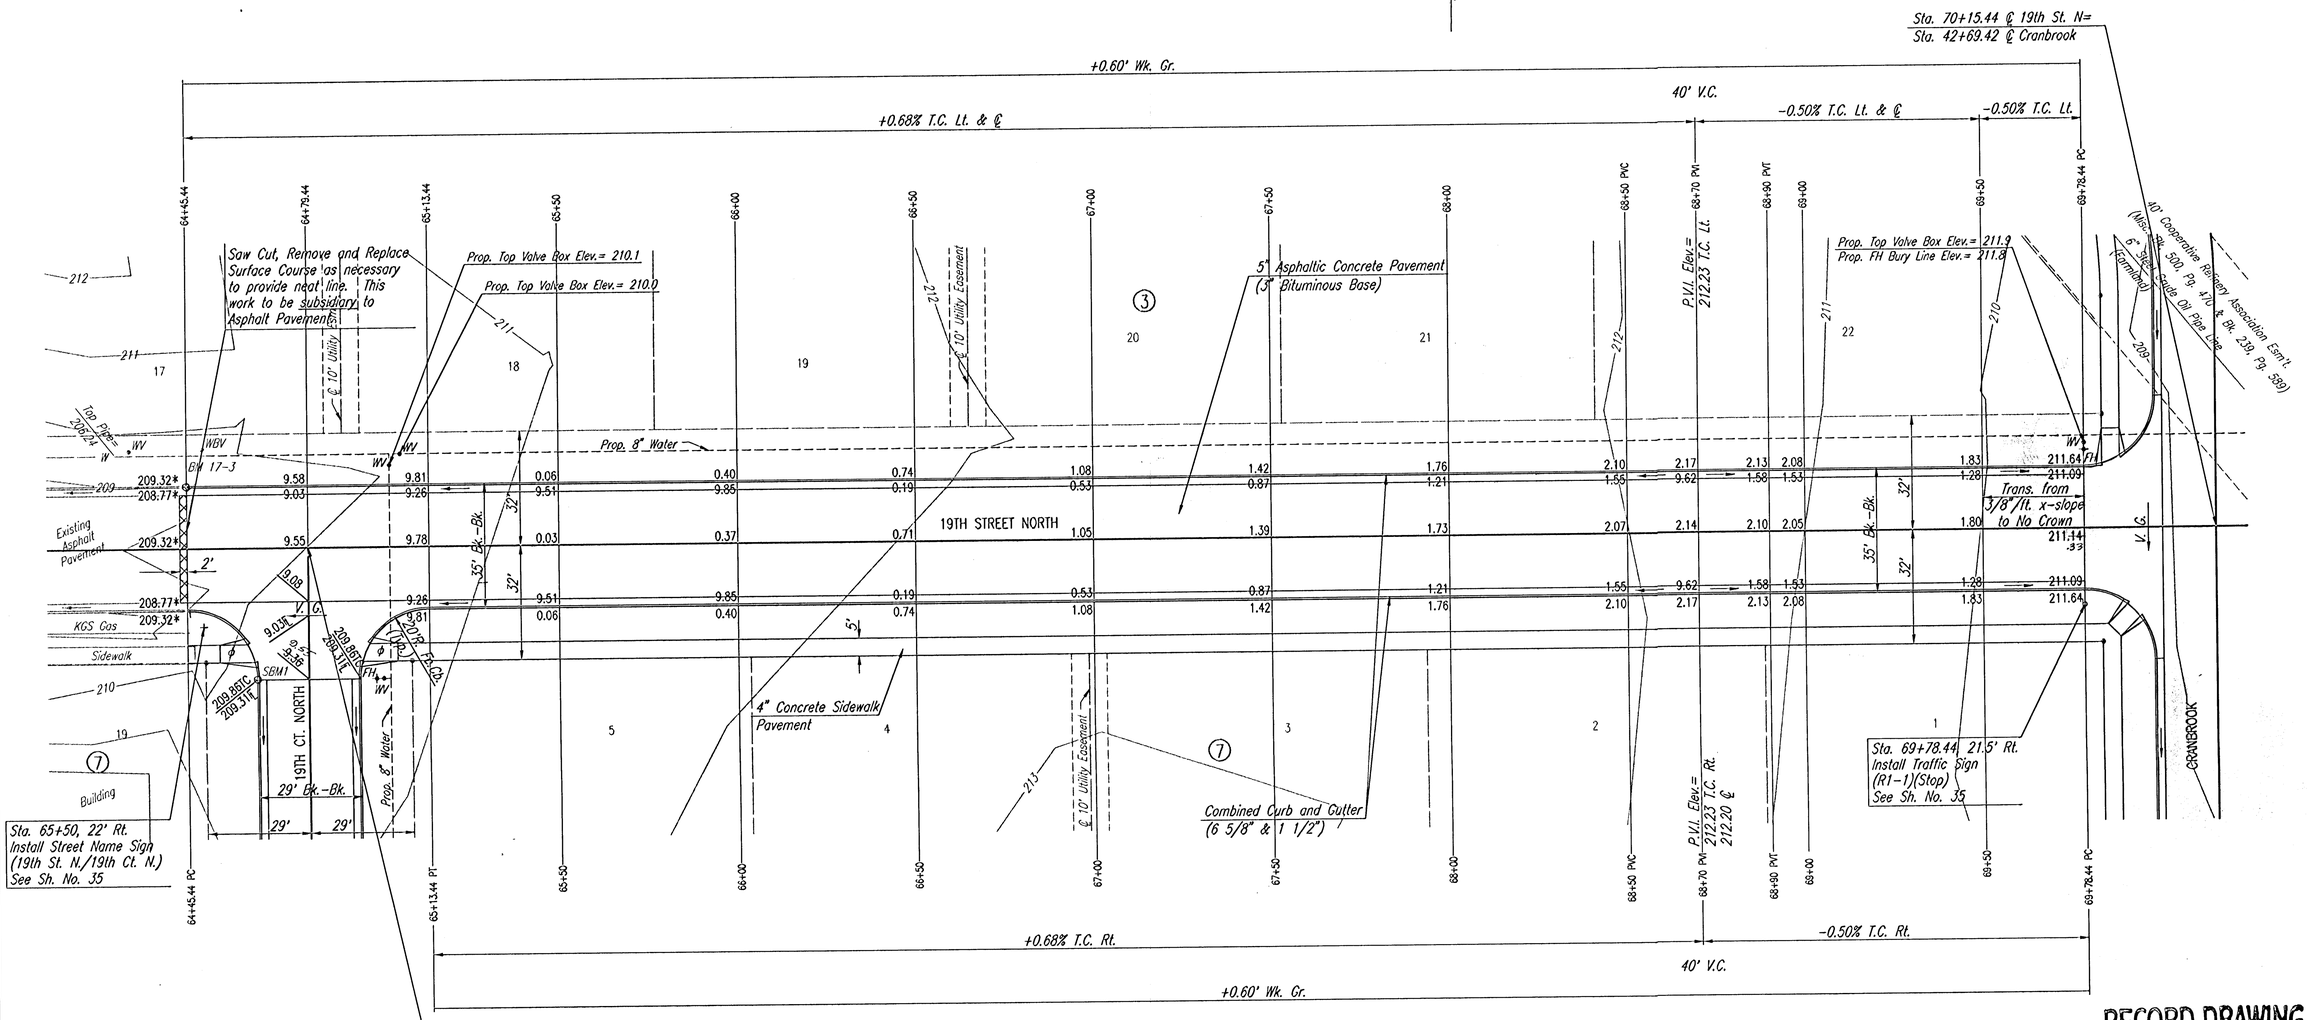

* MATCH EXISTING

ϕ CONST. STD. WHEELCHAIR RAMP

RECORD DRAWING
Brad E. 24 NOV 03

REMINGTON PLACE - PHASE 2

19TH STREET NORTH
STA. 64+45.44 TO STA. 69+78.44

Professional Engineering Consultants, P.A.
303 S. TOPEKA • WICHITA, KANSAS 67202
316-262-2691 • FAX 316-262-3003

Designed by	BER	Checked by	
Drawn by	DEP	Date DEC., 2002	Job No. 02398

DSNR: DEP OPER: DEP SCALE: 1=20.00
Q:\2002\02398\000\19THS1 12-05-2002 03:16:08 pm