




PROJECT NO.	SHEET NO.	TOTAL SHEETS
472-83376	18	50

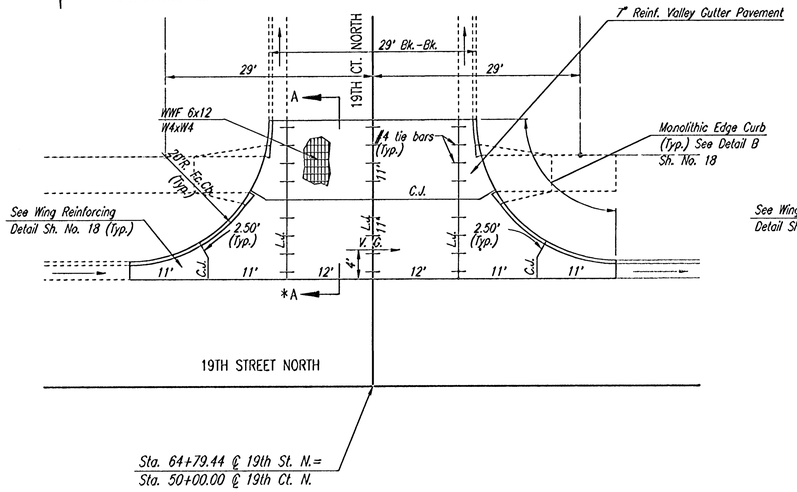

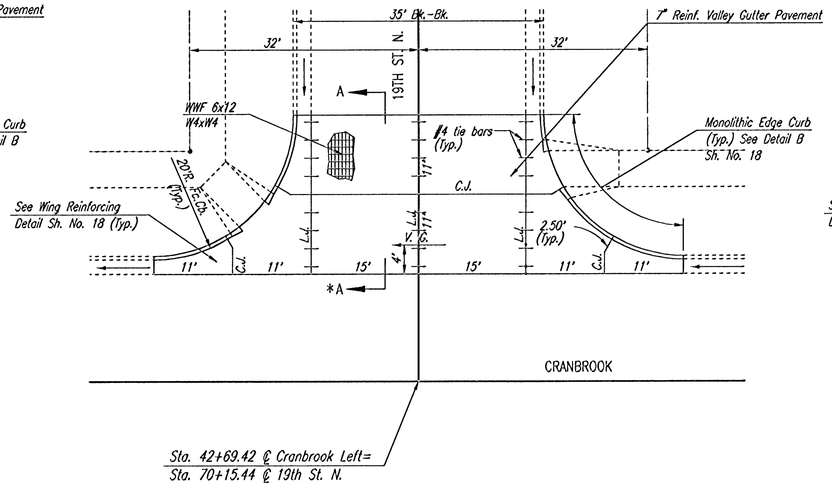

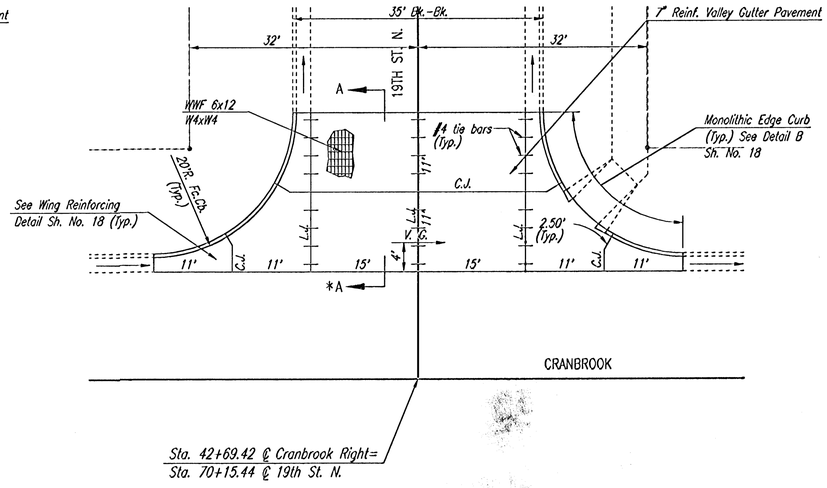

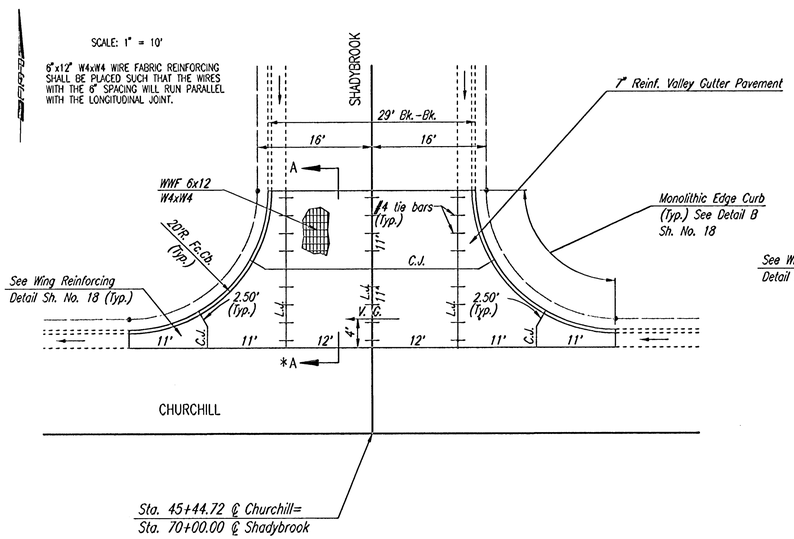

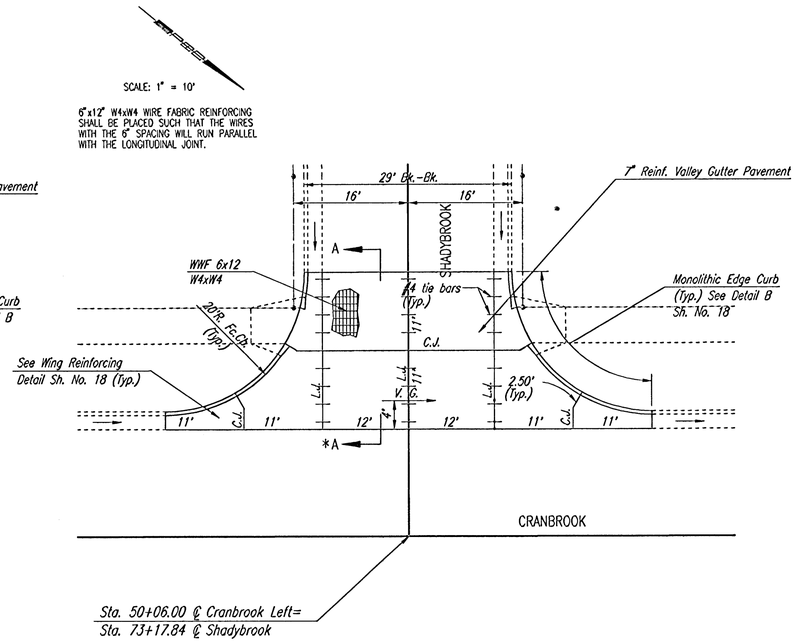

* SEE SH. NO. 18 FOR SECTION A-A

RECORD DRAWING
Bob Eubank 24 NOV 03

REMINGTON PLACE - PHASE 2

VALLEY GUTTER PLANS

Professional Engineering Consultants, P.A.
303 S. TOPEKA • WICHITA, KANSAS 67202
316-262-2691 • FAX 316-262-3003

Designed by	BER	Checked by	
Drawn by	DEP	Date DEC., 2002	Job No. 02398

DSNR: RRY OPER: DEP SCALE: 1=10.00
Q:\2002\02398\000\VALGUTPLAN2 12-03-2002 03:11:25 pm