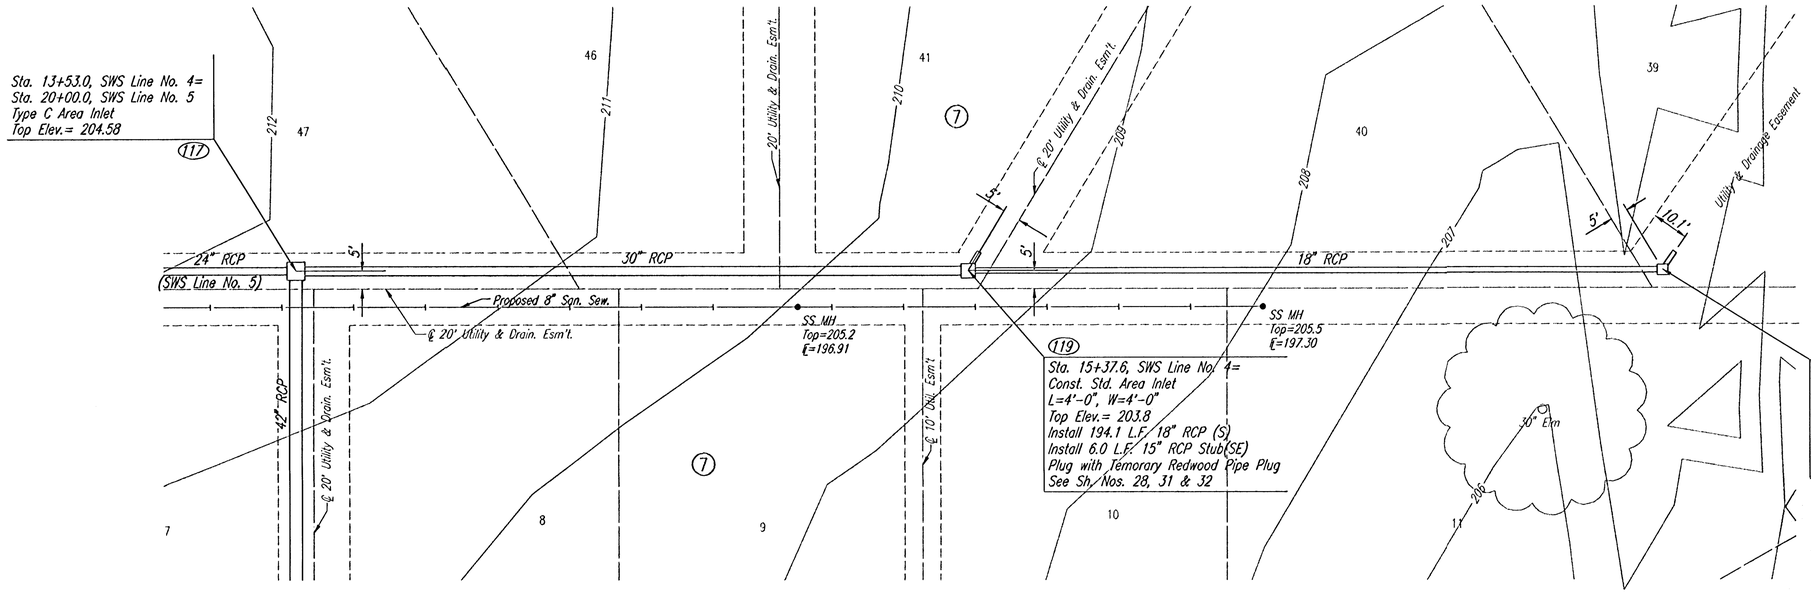

SCALE: 1"=20'

COORDINATE LIST		
POINT	NORTH	EAST
117	385,434.1721	2,370,909.8188
119	385,246.5164	2,370,911.8809
121	385,052.3687	2,370,914.0143

(121) = COORDINATE POINT NO.

RECORD DRAWING

24 NOV 03

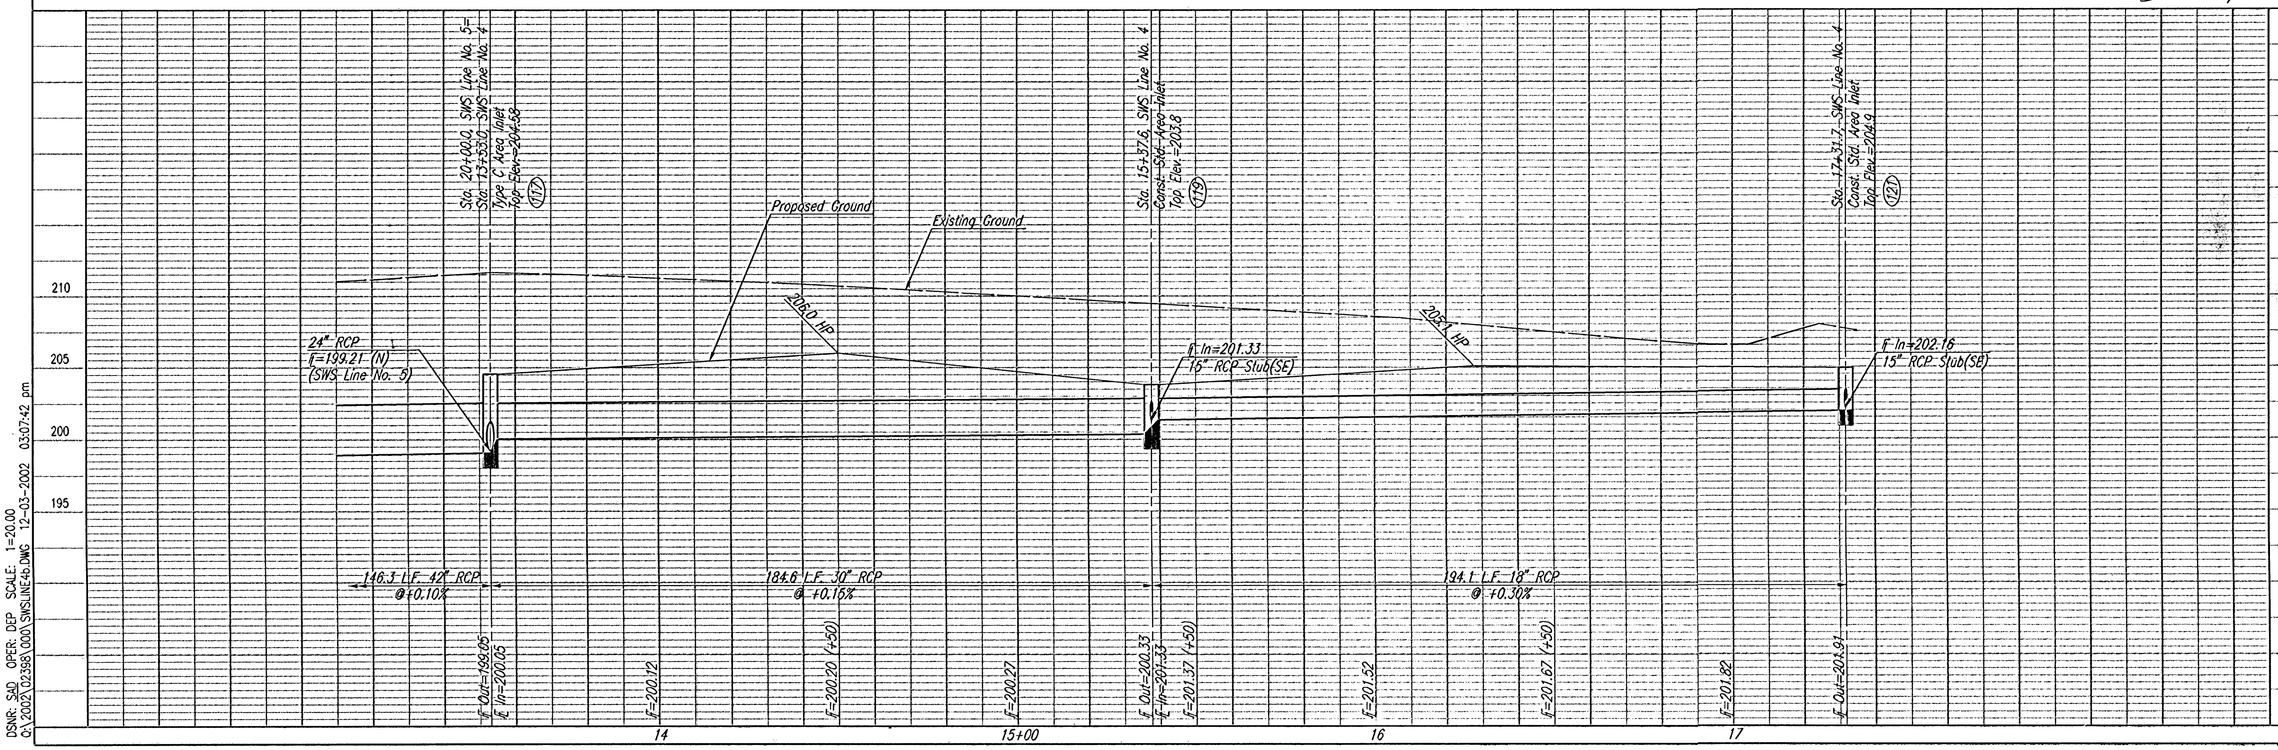

DSNR: SAD OPER: DEP SCALE: 1=20.00
C:\2002\02398\000\SWSLINE46.DWG 12-03-2002 03:07:42 pm

REMINGTON PLACE - PHASE 2

SWS LINE NO. 4
STA. 13+53.0 TO STA. 17+31.7

C.O.W. PROJ. NO. 472-83376

Professional Engineering Consultants, P.A.
303 S. TOPEKA • WICHITA, KANSAS 67202
316-262-2691 • FAX 316-262-3003

Designed by BCR
Drawn by SAW
Job No. 02398
Date DEC., 2002

Sheet 25 of 50