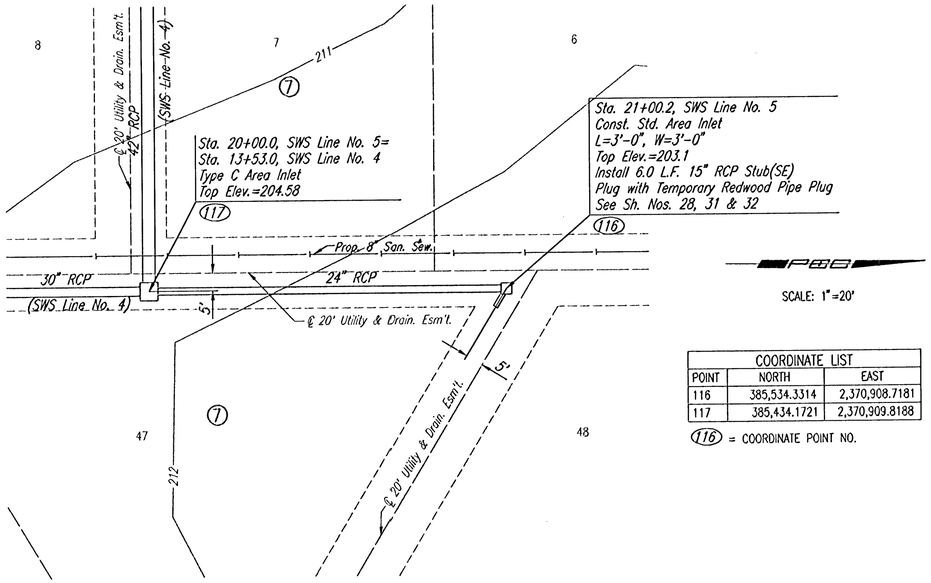



SCALE: 1"=20'

COORDINATE LIST		
POINT	NORTH	EAST
116	385,534.3314	2,370,908.7181
117	385,434.1721	2,370,909.8188

(116) = COORDINATE POINT NO.

RECORD DRAWING
24 NOV 03

SWS LINE NO. 5

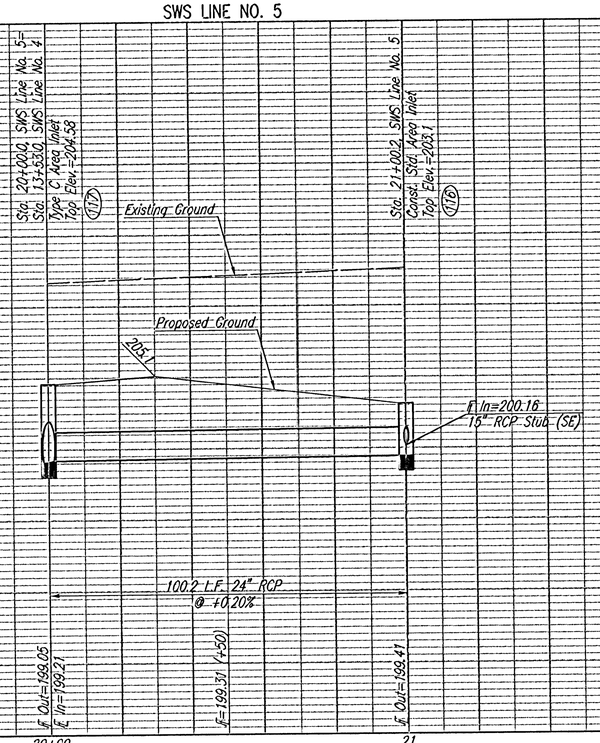

REDMINGTON PLACE - PHASE 2

SWS LINE NO. 5
STA. 20+00.0 TO 21+00.2

C.O.M. PROJ. NO. 472-83376

Professional Engineering Consultants, P.A.
303 S. TOPEKA • WICHITA, KANSAS 67202
316-262-2691 • FAX 316-262-3003

Job No.	02398
Date	DEC., 2002
Designed by	BER
Drawn by	SAW

Sheet 26 of 50

DSNR: SAD OPER: DEP SCALE: 1=20.00
O:\2002\02398\000\SWSLINE5 12-03-2002 03:01:27 pm