SCALE: 1" = 100'


REMINGTON PLACE

AN ADDITION TO WICHITA, SEDGWICK COUNTY, KANSAS

PROJECT NO.	SHEET NO.	TOTAL SHEETS
472-83376	30	50


a MINIMUM OPENING= 203.5
b MINIMUM OPENING= 210.6
c MINIMUM OPENING= 210.5
d MINIMUM OPENING= 208.7
f MINIMUM OPENING= 207.5

(X) STD. BASEMENT
(VO) VIEW-OUT BASEMENT
(WO) WALK-OUT BASEMENT
* MATCH EXISTING

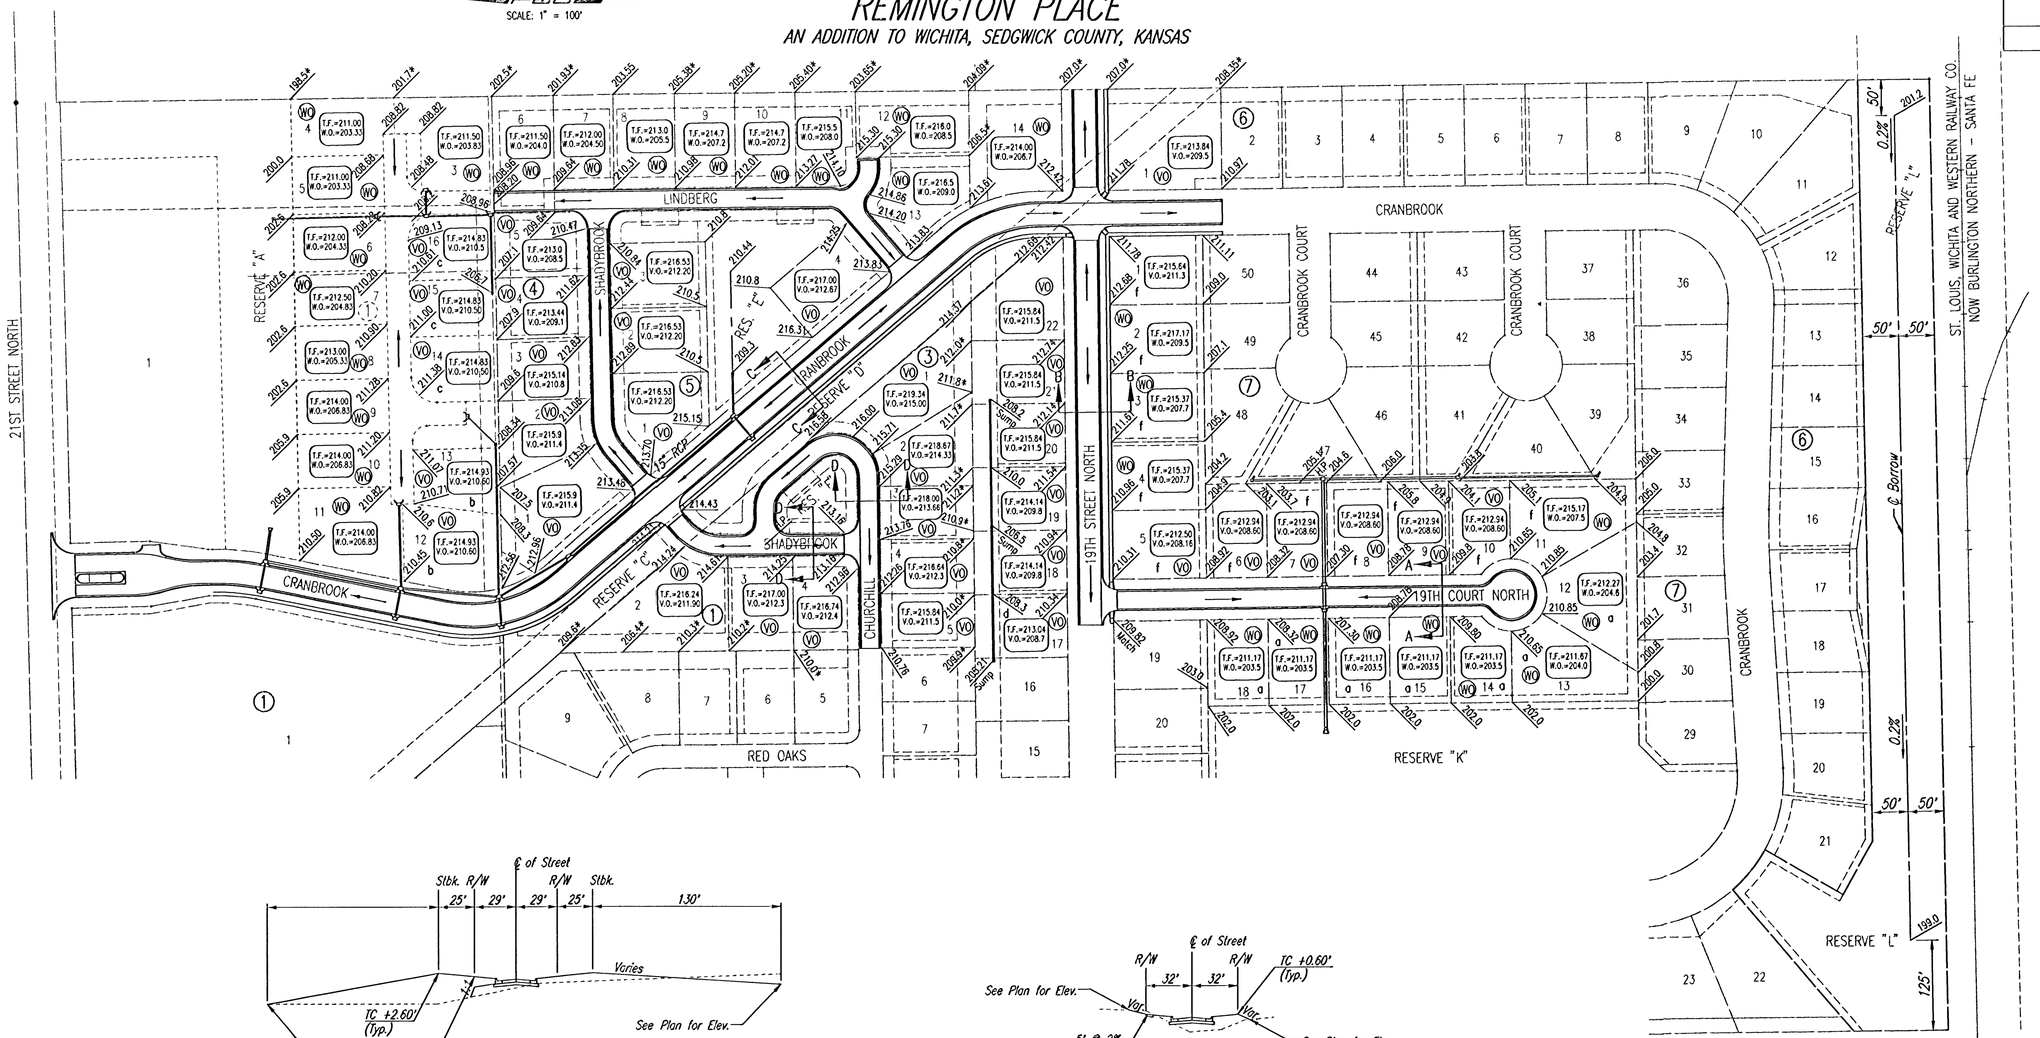


SECTION A-A


SECTION C-C

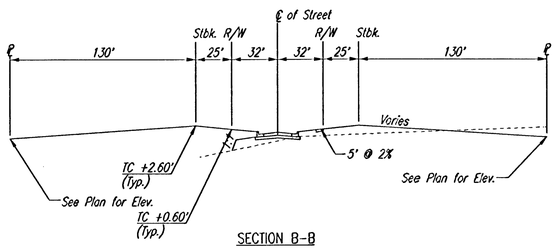

SECTION B-B

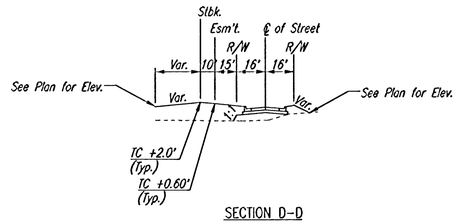

SECTION D-D

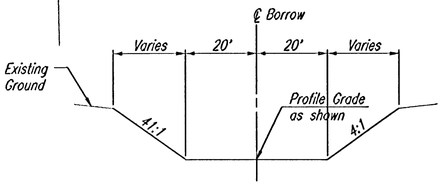

TYPICAL BORROW SECTION

RECORD DRAWING
24 NOV 03
REVISED 05/13/03

REMINGTON PLACE - PHASE 2

FOUR CORNER LOT GRADING

Professional Engineering Consultants, P.A.
303 S. TOPEKA • WICHITA, KANSAS 67202
316-262-2691 • FAX 316-262-3003

Designed by	BER	Checked by	
Drawn by	SAW	Date DEC., 2002	Job No. 02398

DSN#: SAW OPER: TLS SCALE: 1=100.00
Q:\2002\02398\000\CHANGE ORDER\05-13-03\4CORNER 11-21-2003 08:21:38 am