
PROJECT NO.	SHEET NO.	TOTAL SHEETS
472-83376	43	50

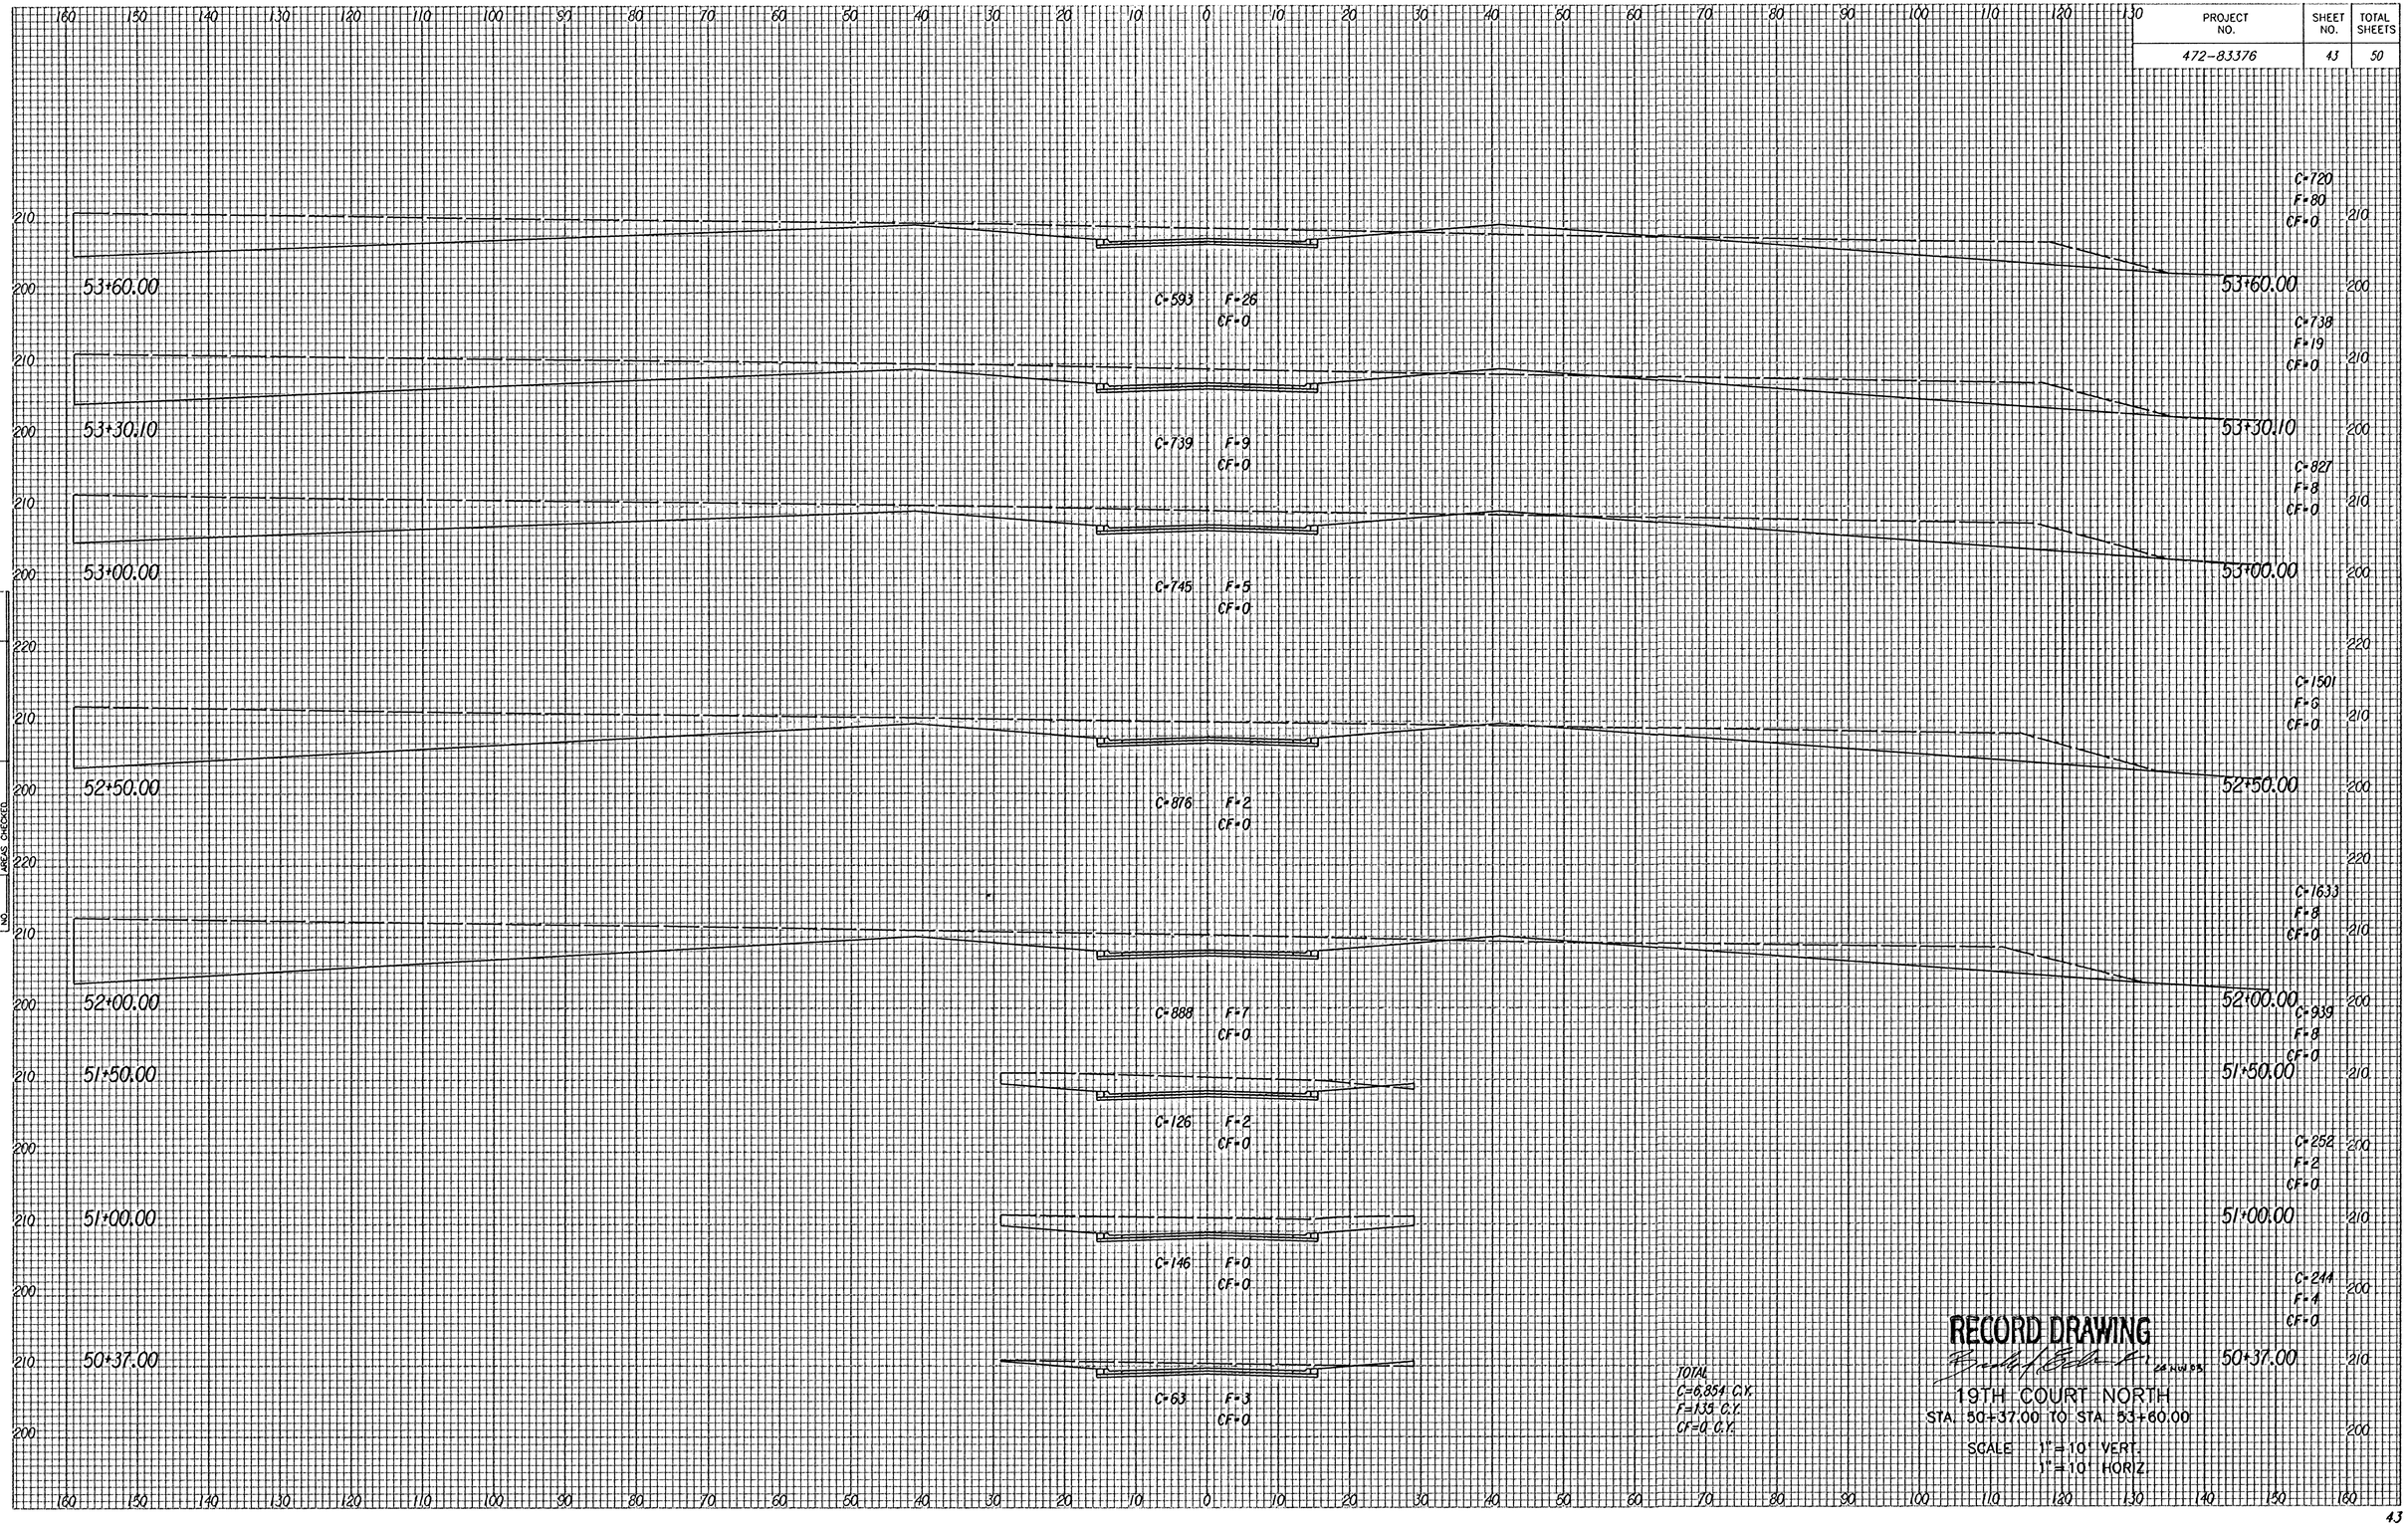

NOTE BOOK TEMPLATE AREAS CHECKED NO.

TOTAL
C=6,854 C.Y.
F=135 C.Y.
CF=0 C.Y.

RECORD DRAWING

Brent Wells Jr. CA R.W.S.

19TH COURT NORTH
STA. 50+37.00 TO STA. 53+60.00

SCALE 1"=10' VERT.
1"=10' HORIZ.