
PROJECT NO.	SHEET NO.	TOTAL SHEETS
472-83377	6	23

WATER VALVE BOX ELEVATIONS			
STREET	STATION	OFFSET	PROPOSED ELEVATION
SHADYBROOK	73+59.59	21.0'Lt.	213.8
SHADYBROOK	77+20.33	21.0'Lt.	210.6
SHADYBROOK	77+33.83	23.0'Lt.	210.2

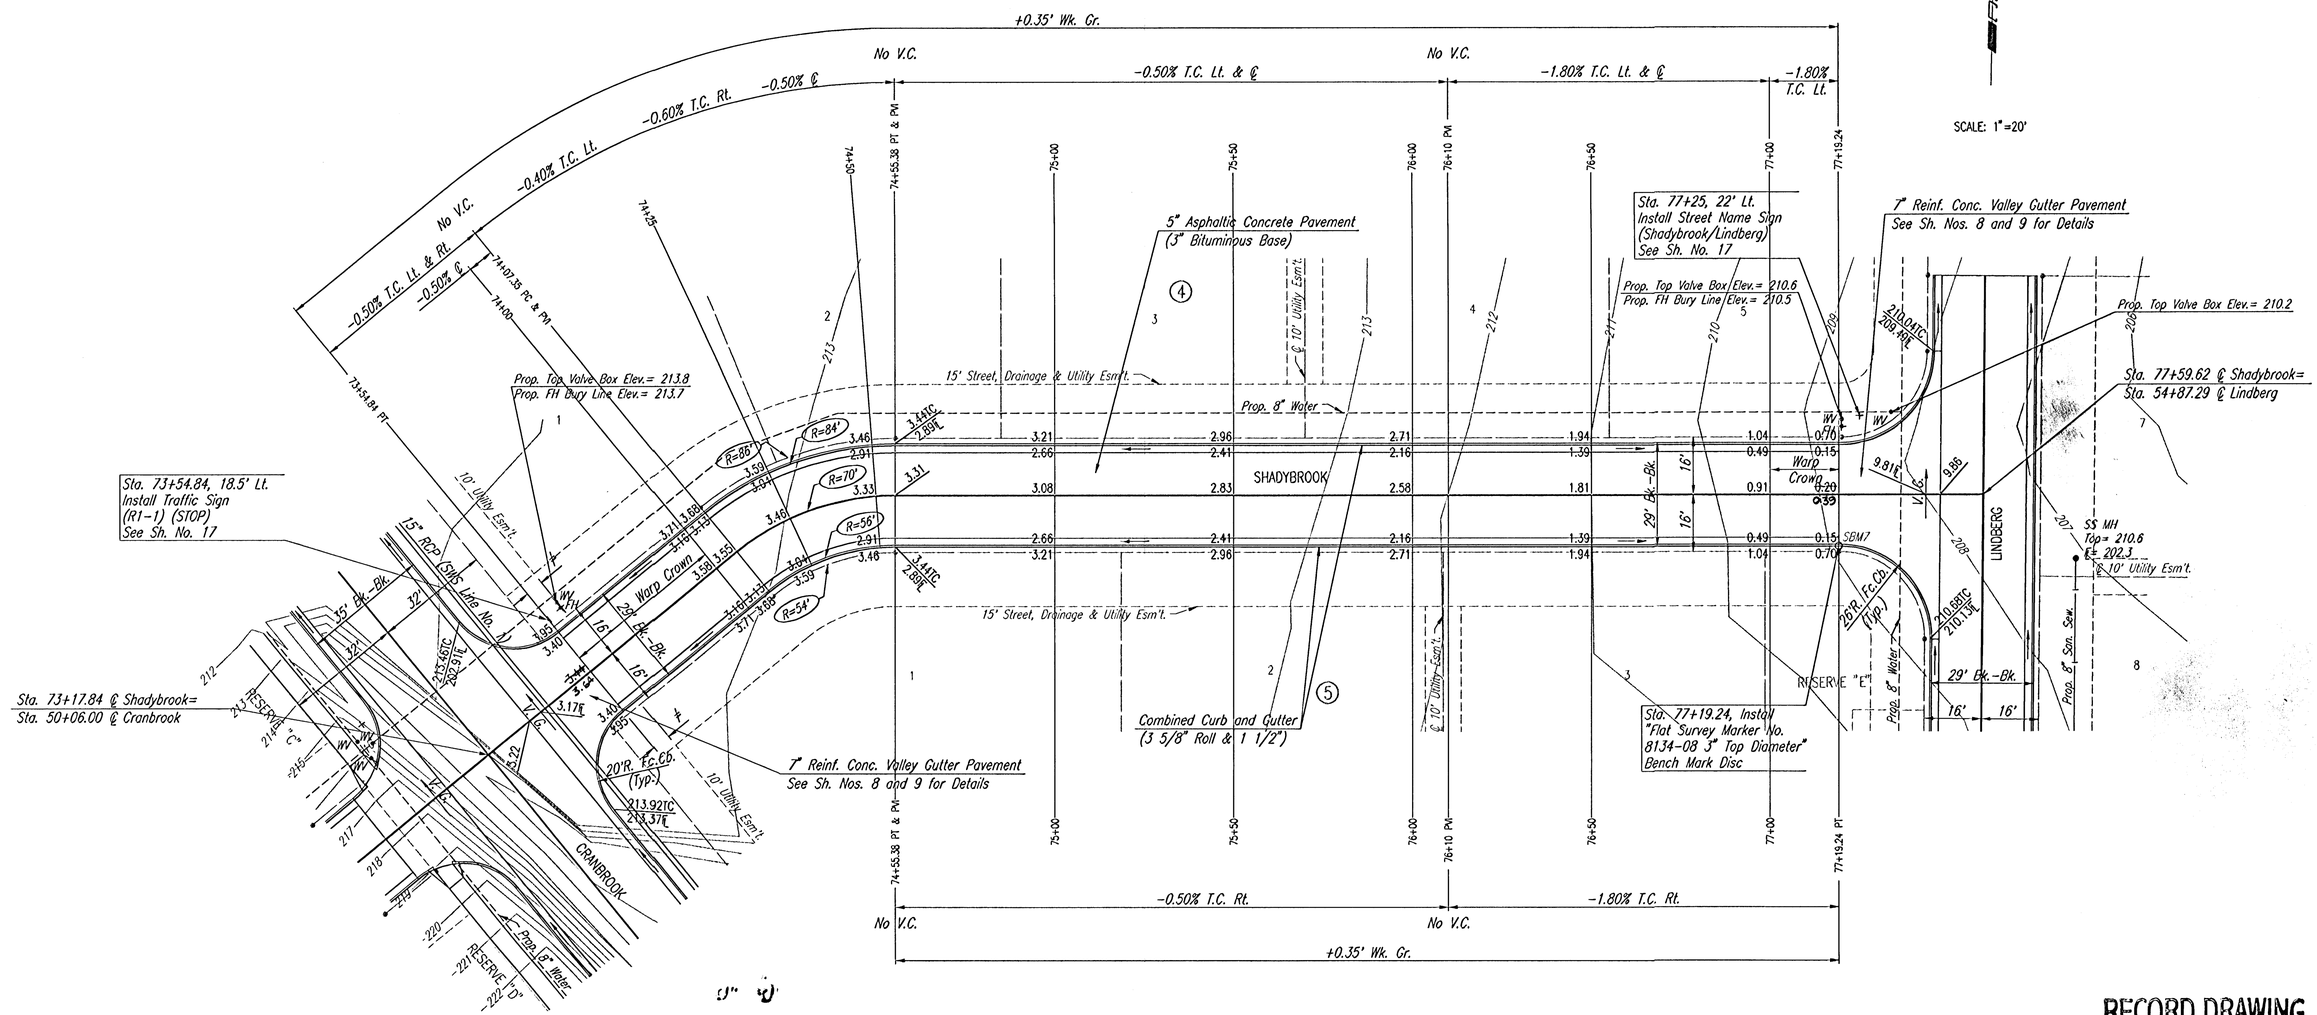

℄ CURVE DATA							
Δ=39°18'36"	D=81°51'04"	R=70.00'	L=48.03'	T=25.00'	E=4.33'		
CURVE DATA BASED ON ℄ RADIUS Δ/2=19°39'18"							
℄ STATION	℄ ARC LENGTH	FACE CURB LENGTH		CHORD LENGTH		DEFLECTION ANGLE	℄ TOTAL DEFLECTION
		LEFT CURB	RIGHT CURB	8'OFF LEFT FACE CURB	8'OFF RIGHT FACE CURB		
74+07.35	—	—	—	—	—	0°00'00"	0°00'00"
74+25	17.65'	21.18'	14.12'	23.14'	12.07'	7°13'24"	7°13'24"
74+50	25.00'	30.00'	20.00'	32.68'	17.05'	10°13'53"	17°27'17"
74+55.38	5.38'	6.45'	4.30'	7.06'	3.69'	2°12'01"	19°39'18"
TOTAL	48.03'	57.63'	38.42'	Defl./ft.=24.553404 min.			

NOTE: THIS STREET TO BE CONSTRUCTED WITH ROLL-TYPE CURB. TOP OF CURB ELEVATIONS GIVEN ARE FOR FULL HEIGHT CURB.

≠ 5' TRANSITION FROM COMBINED CURB AND GUTTER 6 5/8" & 1 1/2") TO COMBINED CURB AND GUTTER (3 5/8" ROLL & 1 1/2"). TO BE BID AND PAID FOR AS "COMBINED CURB AND GUTTER (3 5/8" ROLL & 1 1/2")".

RECORD DRAWING
24 NOV 03

REMINGTON PLACE - PHASE 3

SHADYBROOK
STA. 73+54.84 TO STA. 77+59.62

Professional Engineering Consultants, P.A.
303 S. TOPEKA • WICHITA, KANSAS 67202
316-262-2691 • FAX 316-262-3003

Designed by	BER	Checked by	
Drawn by	DEP	Date DEC., 2002	Job No. 02398-004

DSN'R: RRY OPER: DEP SCALE: 1=20.00
C:\2002\02398\004\SHADYBROOKS2 12-03-2002 03:47:21 pm