
WATER VALVE BOX ELEVATIONS			
STREET	STATION	OFFSET	PROPOSED ELEVATION
LINDBERG COURT	60+80.67	23.0'Rt.	2145.5

PROJECT NO.	SHEET NO.	TOTAL SHEETS
472-83377	8	23

SCALE: 1"=20'

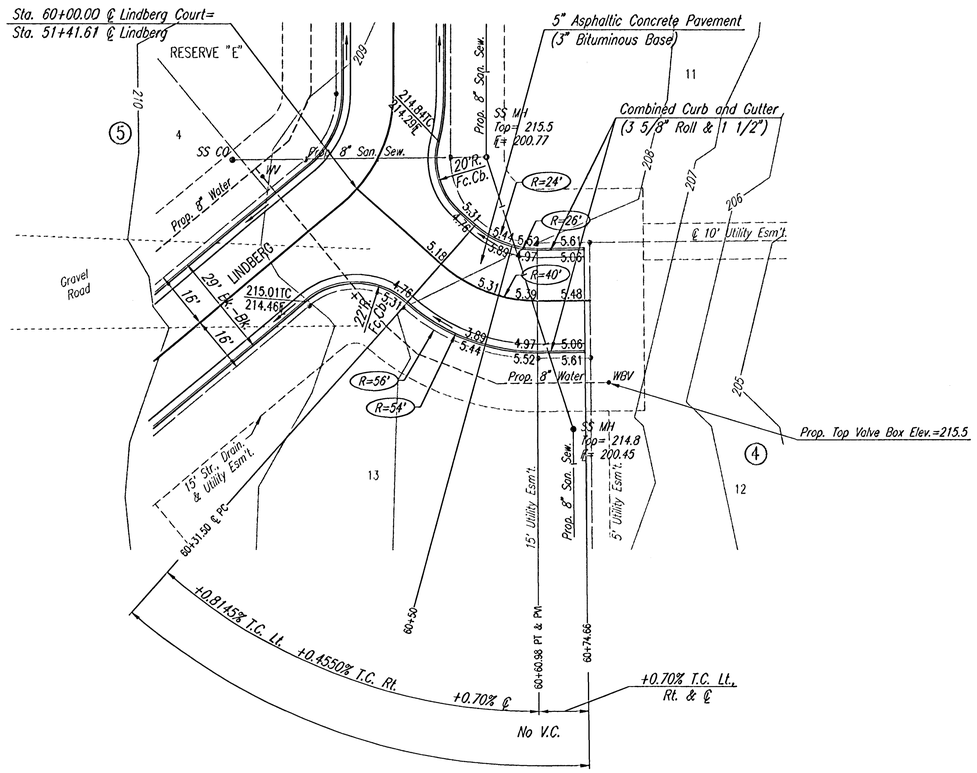

℄ CURVE DATA							
Δ=42°13'16" D=14°3'14"22" R=40.00' L=29.48' T=15.44' E=2.88'							
CURVE DATA BASED ON ℄ RADIUS Δ/2=21°06'38"							
℄ STATION	℄ ARC LENGTH	FACE CURB LENGTH		CHORD LENGTH		DEFLECTION ANGLE	℄ TOTAL DEFLECTION
		LEFT CURB	RIGHT CURB	8"OFF LEFT FACE CURB	8"OFF RIGHT FACE CURB		
60+31.50	———	———	———	———	———	0°00'00"	0°00'00"
60+50	18.50'	12.03'	24.98'	8.25'	28.42'	1°14'59"	1°14'59"
60+60.98	10.98'	7.13'	14.82'	4.92'	16.96'	7°51'39"	21°06'38"
TOTAL	29.48'	19.16'	39.80'	Defl./ft.=42.965853 min.			

NOTE: THIS STREET TO BE CONSTRUCTED WITH ROLL-TYPE CURB. TOP OF CURB ELEVATIONS GIVEN ARE FOR FULL HEIGHT CURB.

RECORD DRAWING
Brad E. Eckroth 24 NOV 03

REMINGTON PLACE - PHASE 3

LINDBERG COURT
STA. 60+00.00 TO STA. 60+74.66

Professional Engineering Consultants, P.A.
303 S. TOPEKA • WICHITA, KANSAS 67202
316-262-2691 • FAX 316-262-3003

Designed by	BER	Checked by	
Drawn by	DEP	Date DEC., 2002	Job No. 02398-004

DSNR: DEP OPER: DEP SCALE: 1=20.00
Q:\2002\02398\004\LINDBERCT 12-03-2002 03:46:22 pm